

STATE OF ARIZONA
 DEPARTMENT OF TRANSPORTATION
 INFRASTRUCTURE DELIVERY AND OPERATIONS DIVISION



CROSS SECTIONS







STATE HIGHWAY
 CORDES JCT-FLAGSTAFF HIGHWAY
 INTERSTATE 17


INDEX OF SHEETS







Sheet No.	Sheet Type
1	Cover Sheet
2-7	I-17 Cross Sections
8-24	JW Powell Cross Sections
25-27	Detour Cross Sections


I-17 AIRPORT RD TI UP
 PROJECT NO. 017 CN 337 F0362 01C
 FEDERAL AID NO. 017-B(237)T







ARIZONA DEPARTMENT OF TRANSPORTATION
 INFRASTRUCTURE DELIVERY AND OPERATIONS DIVISION
 GREGORY BYRES, P.E., STATE ENGINEER

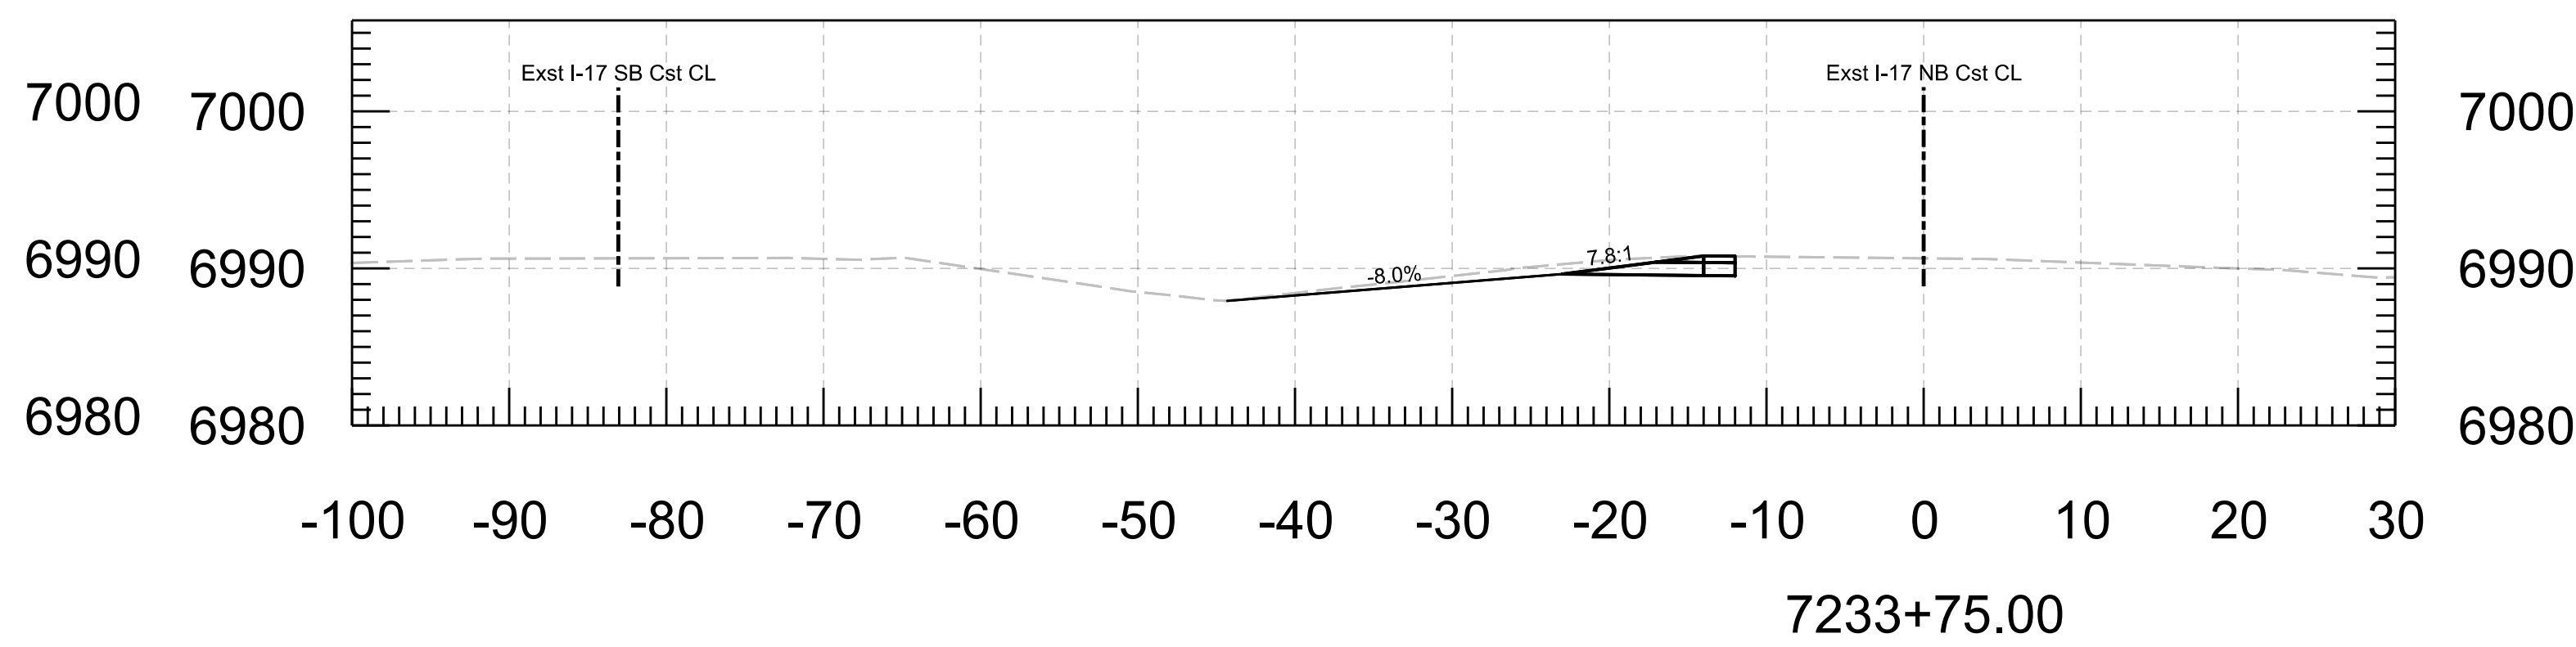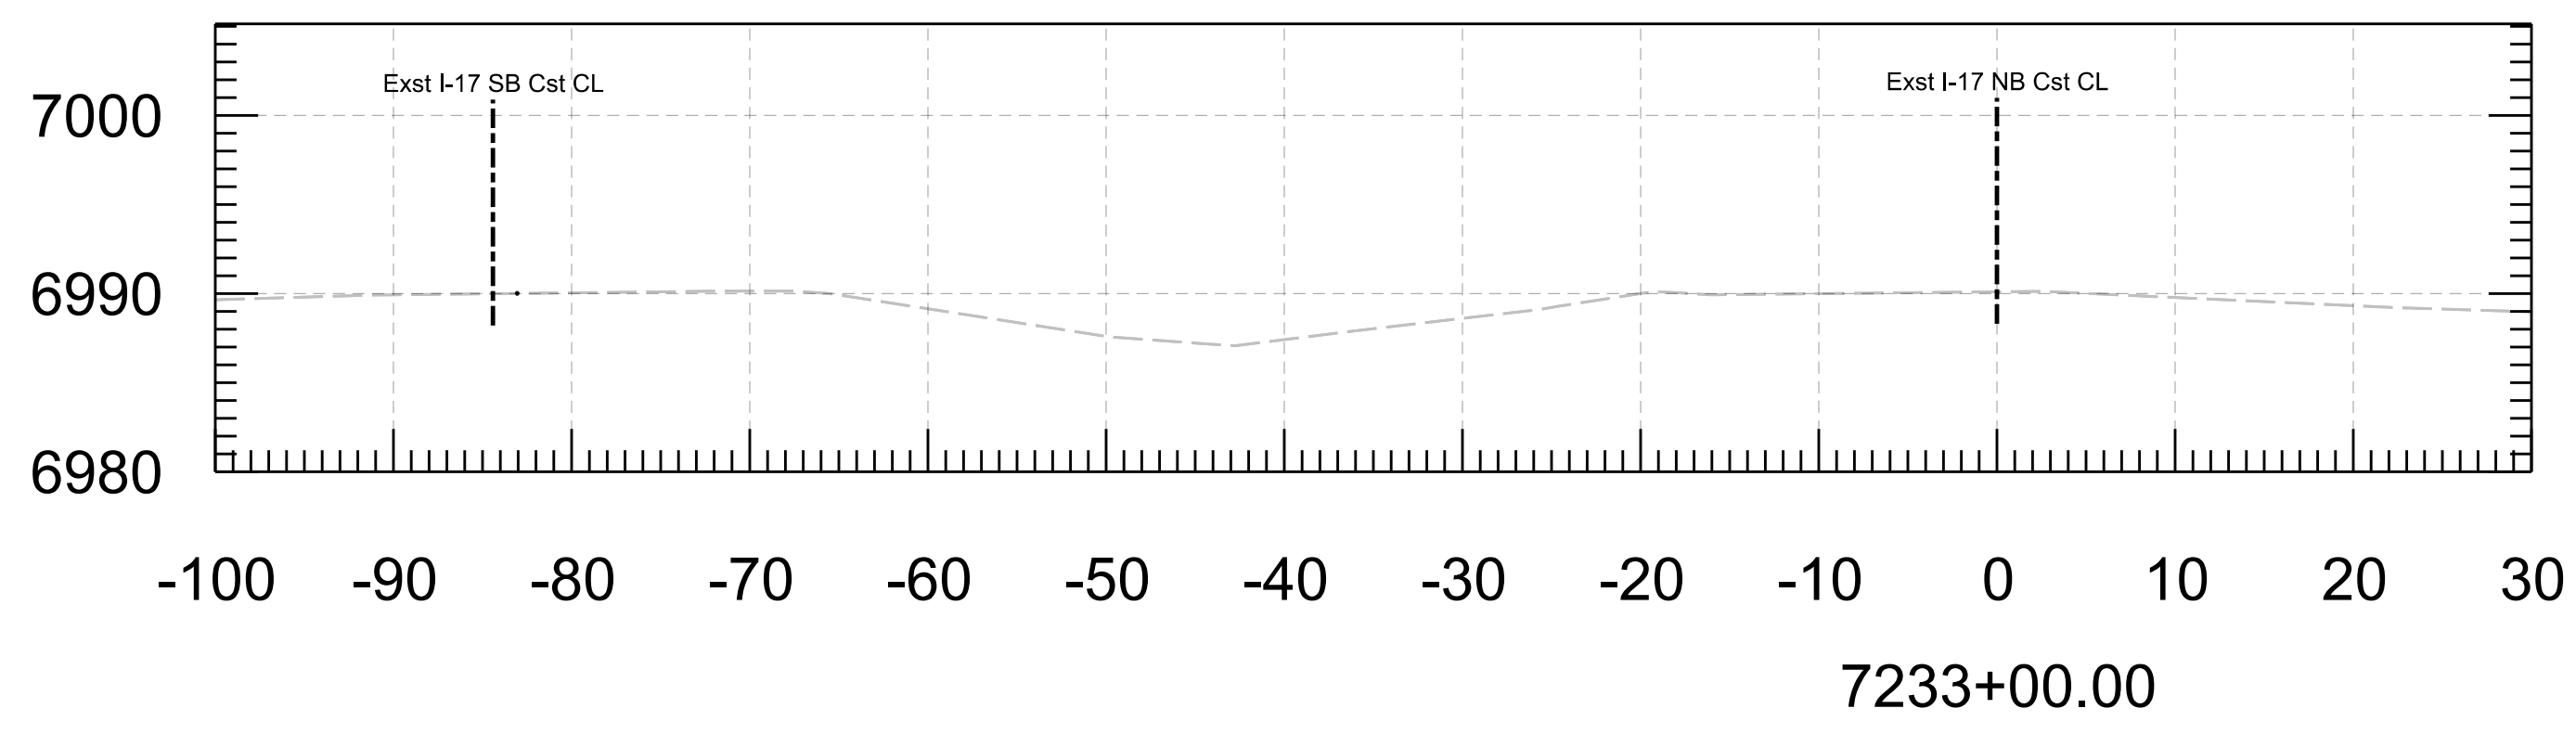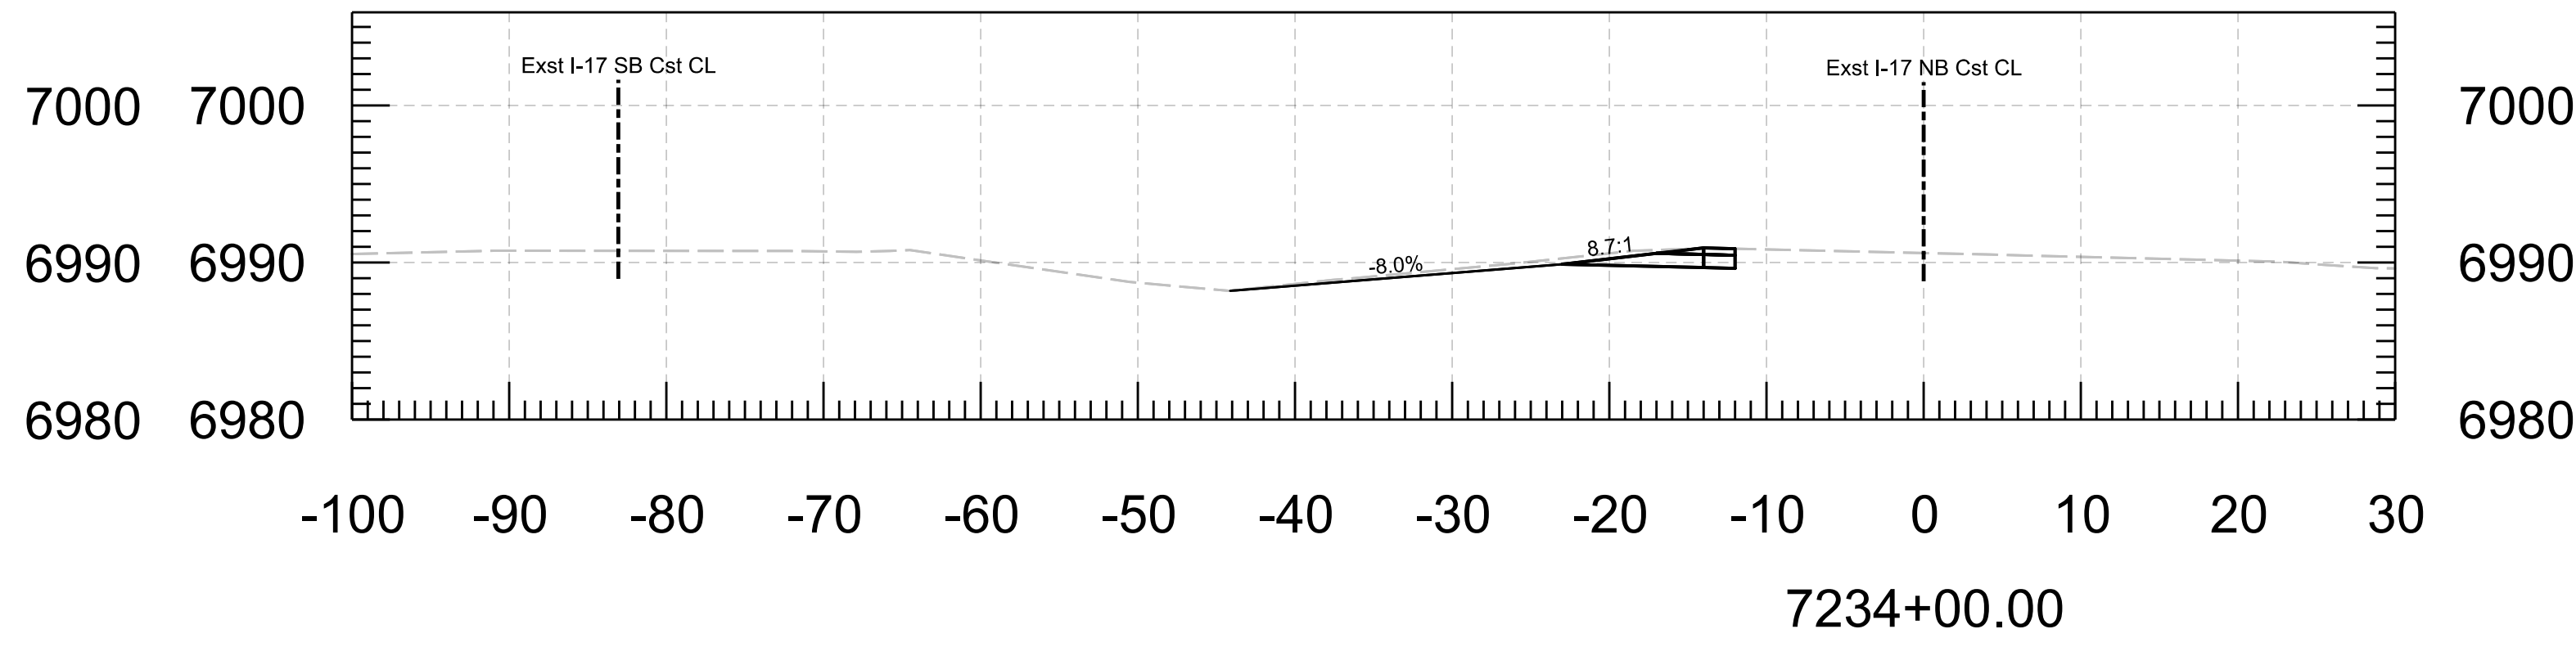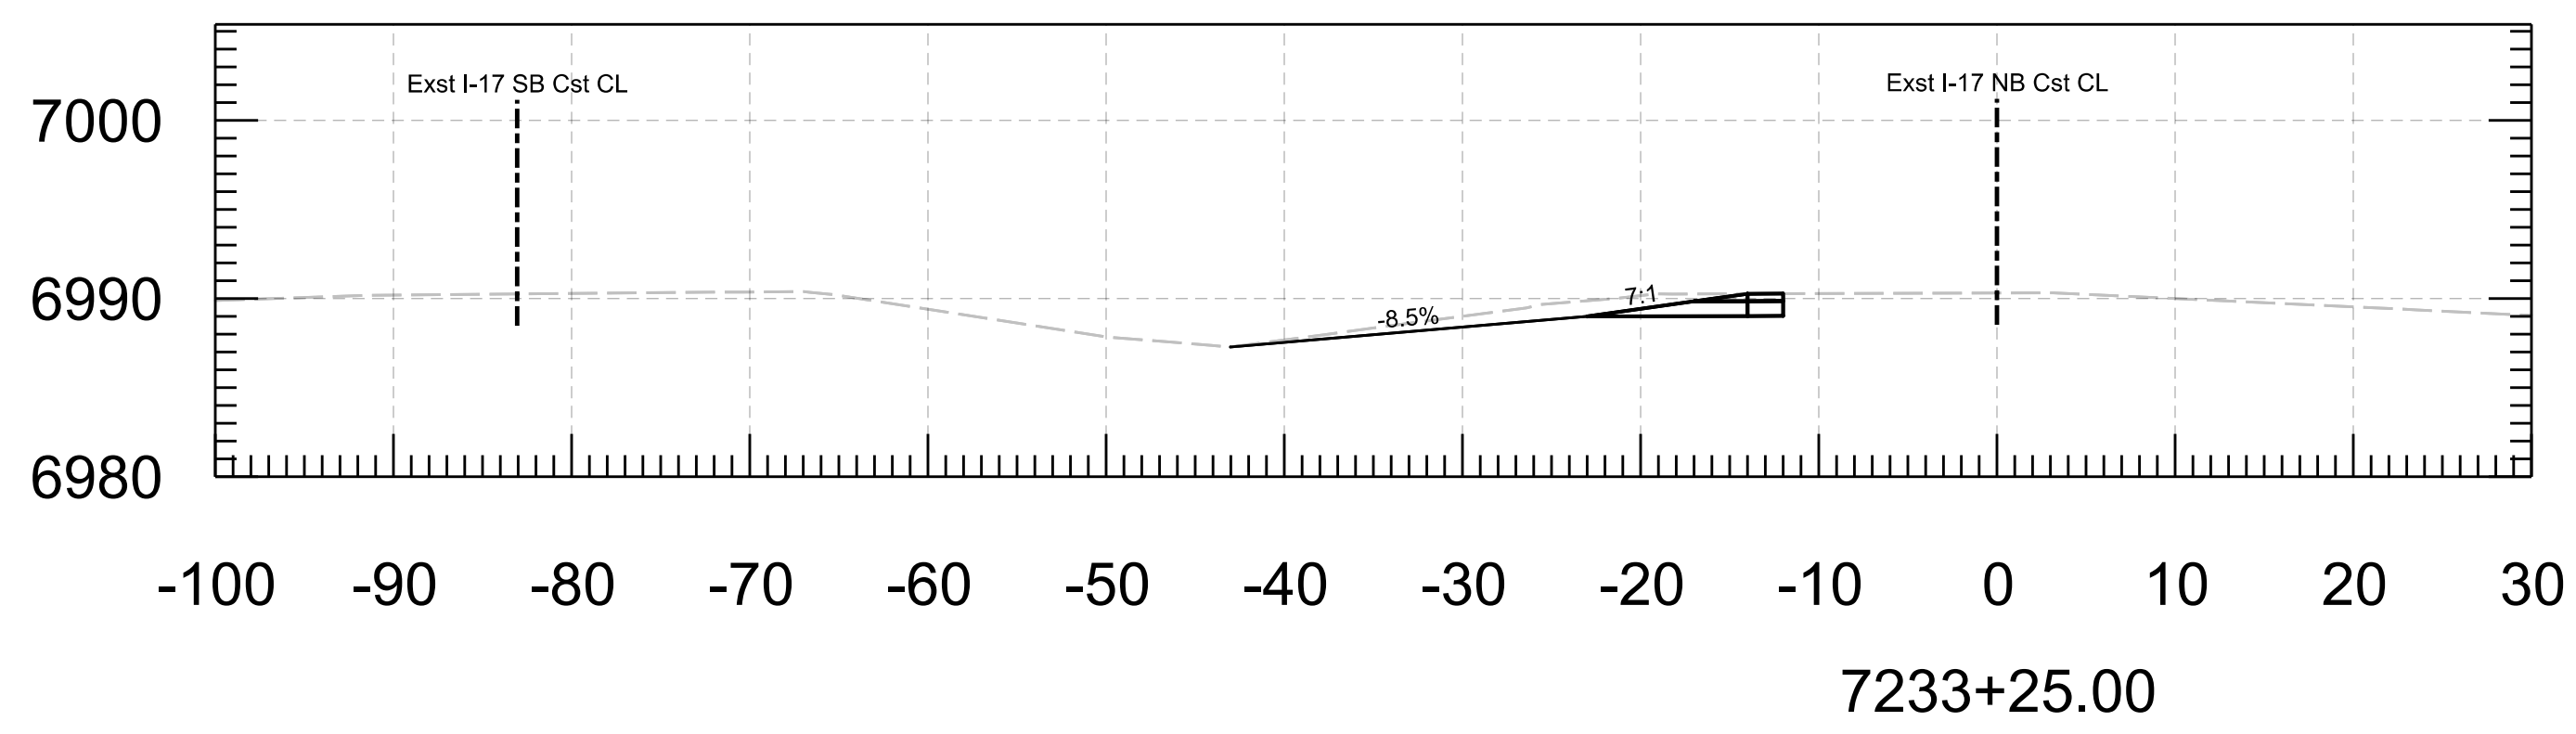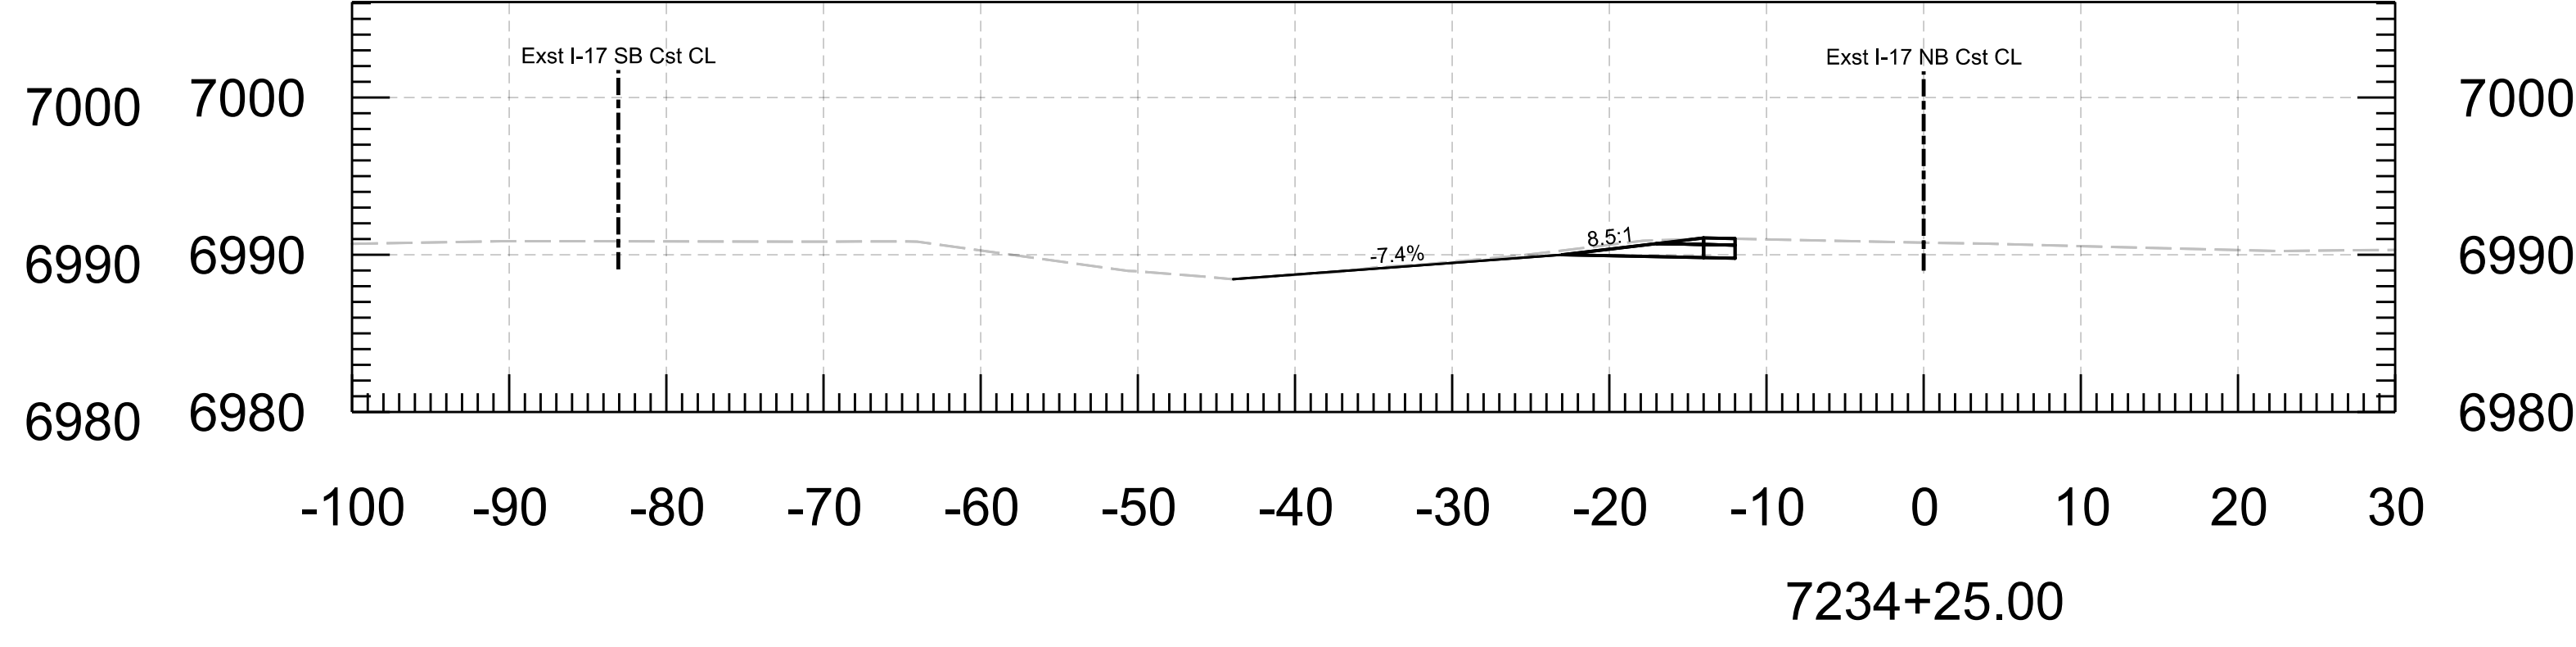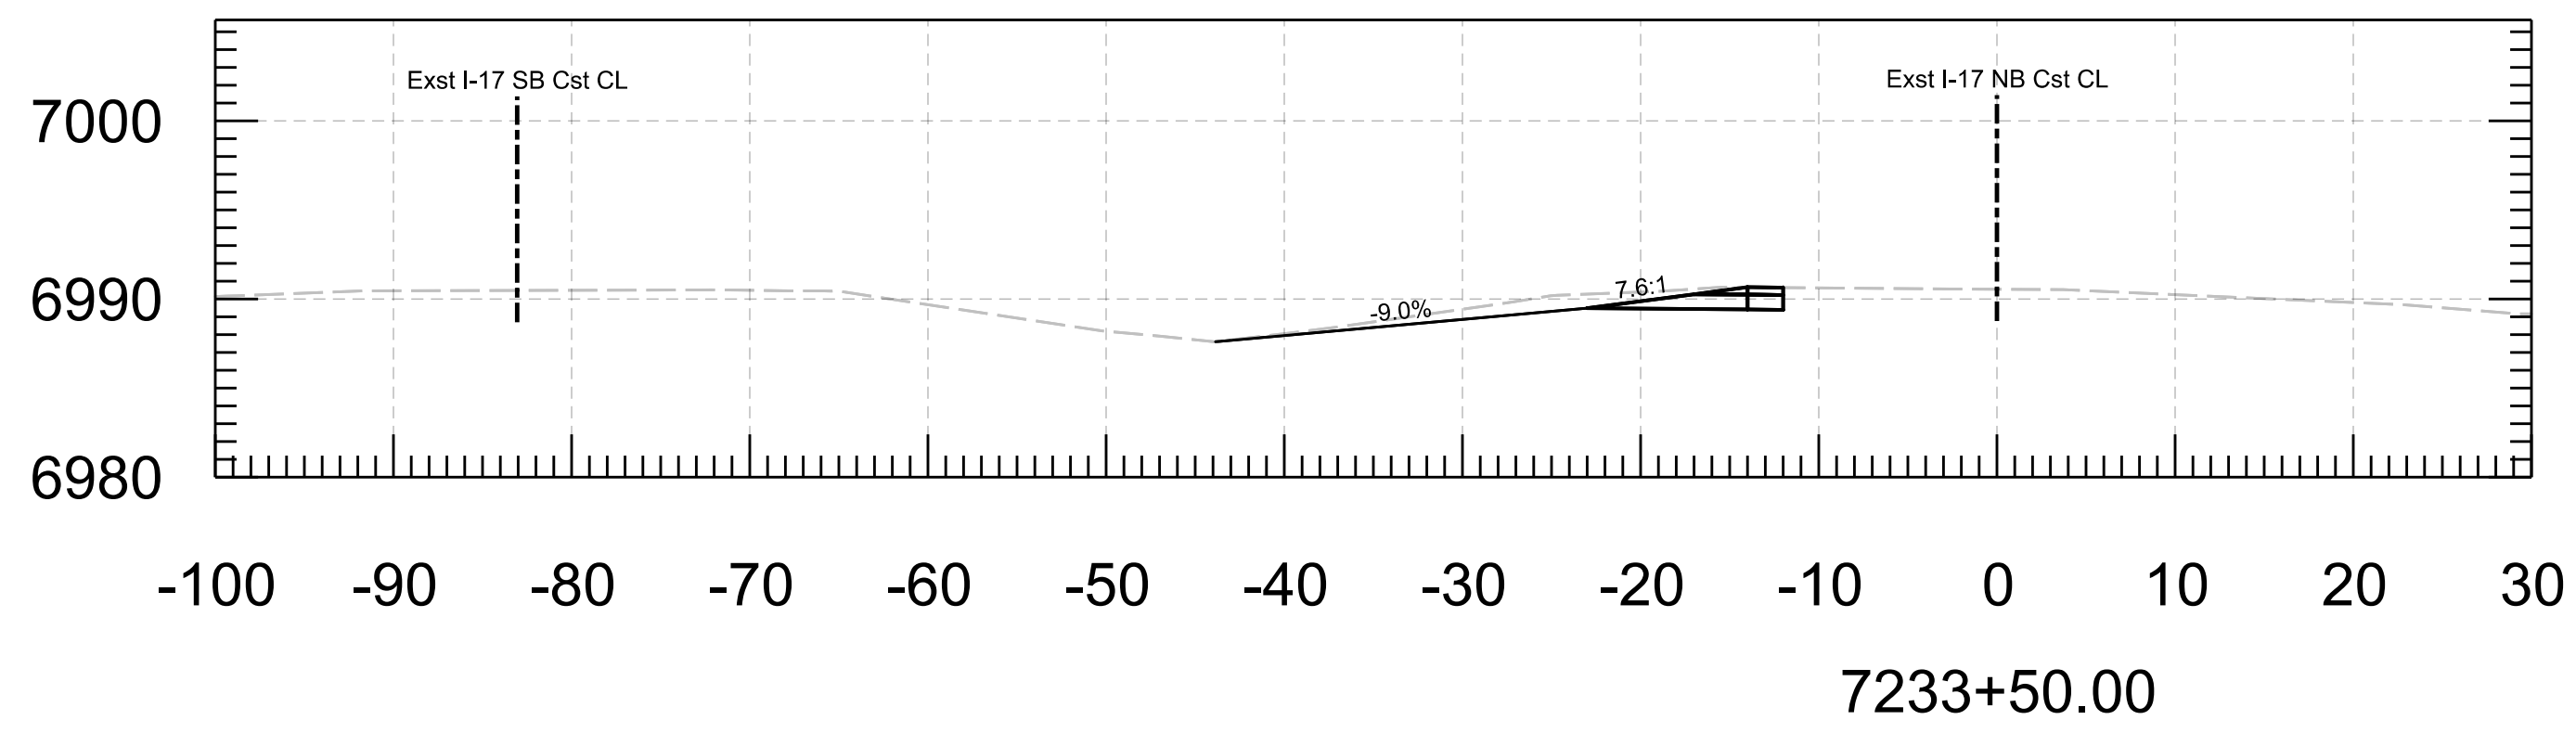


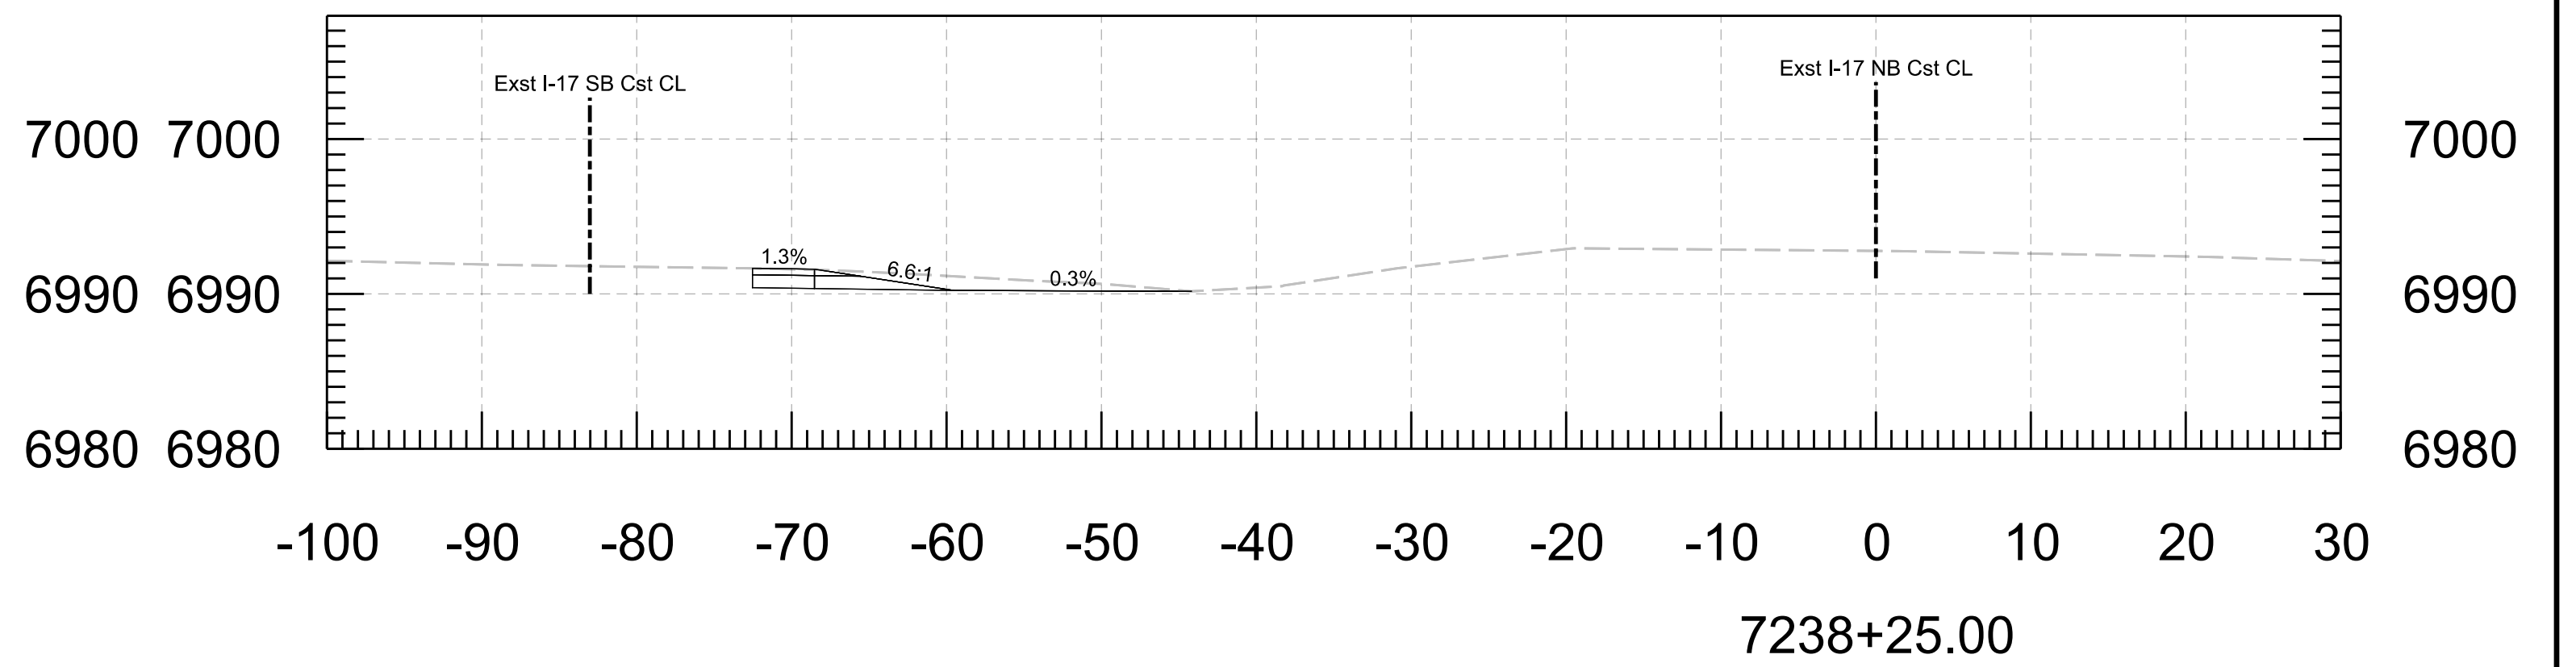
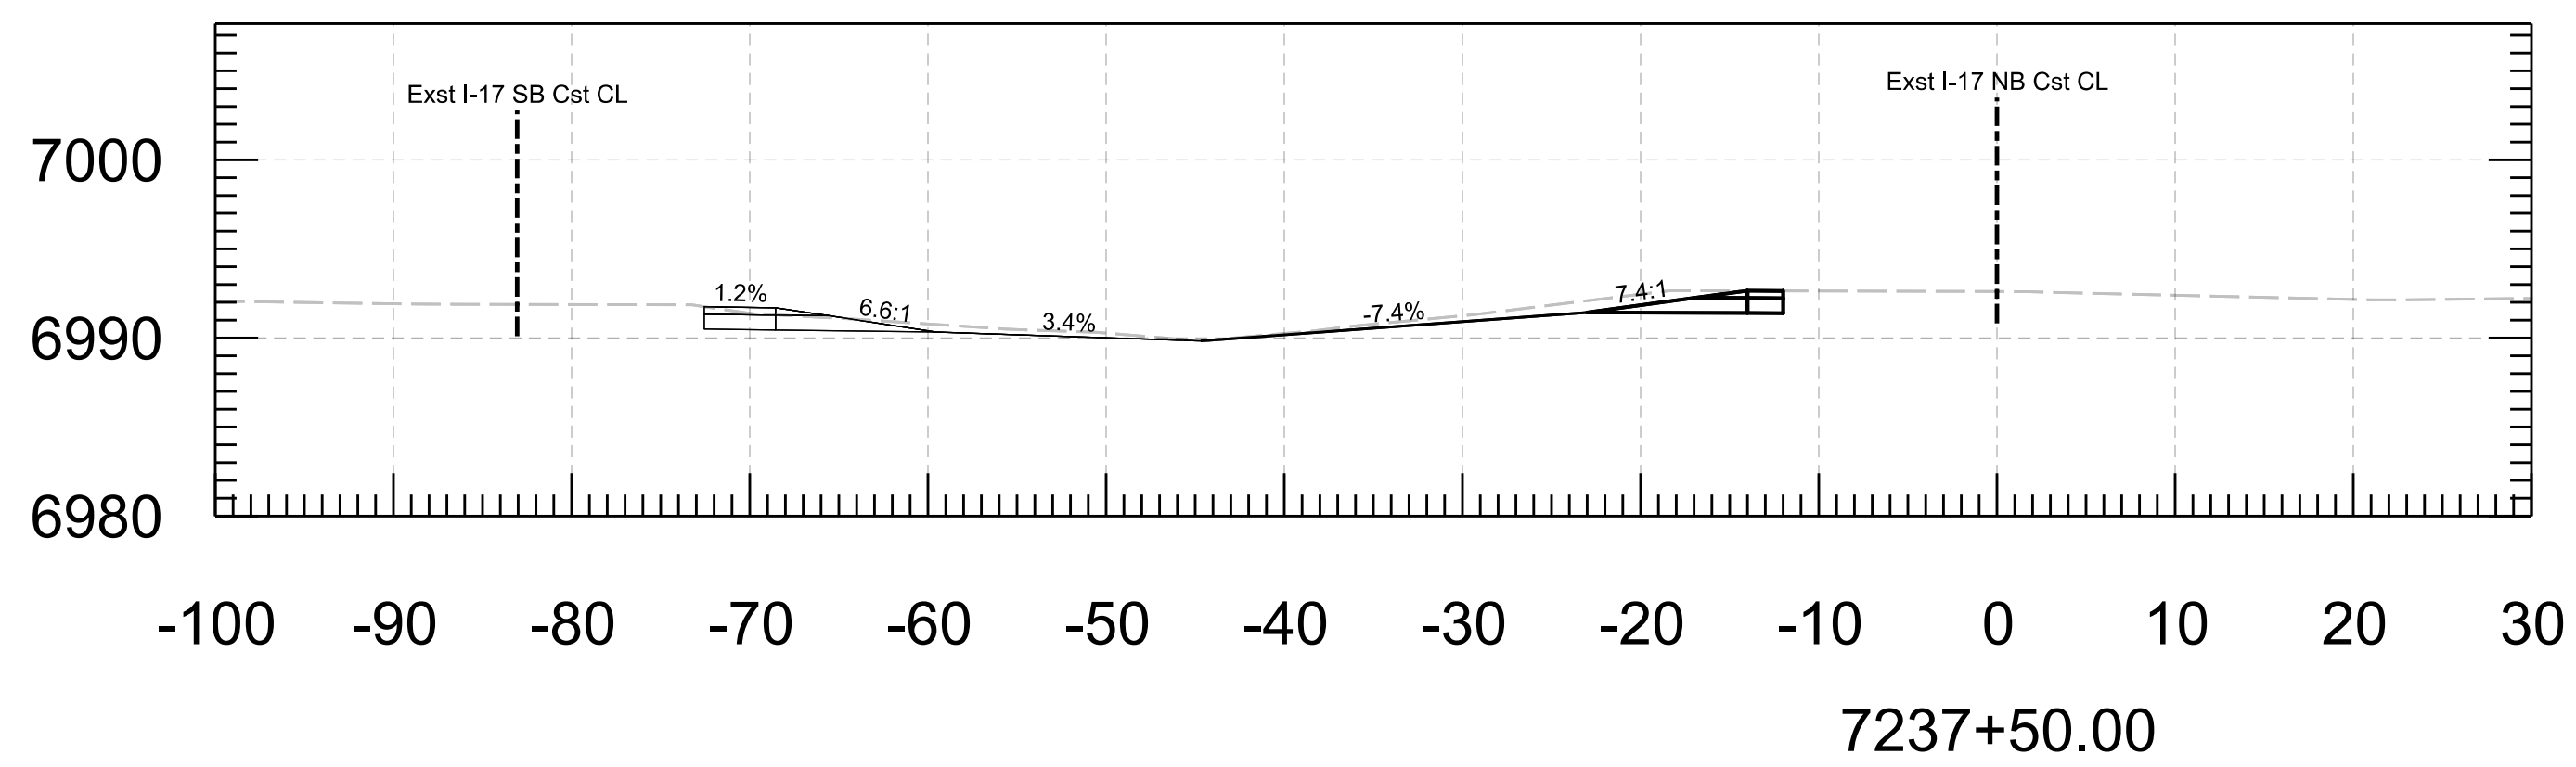
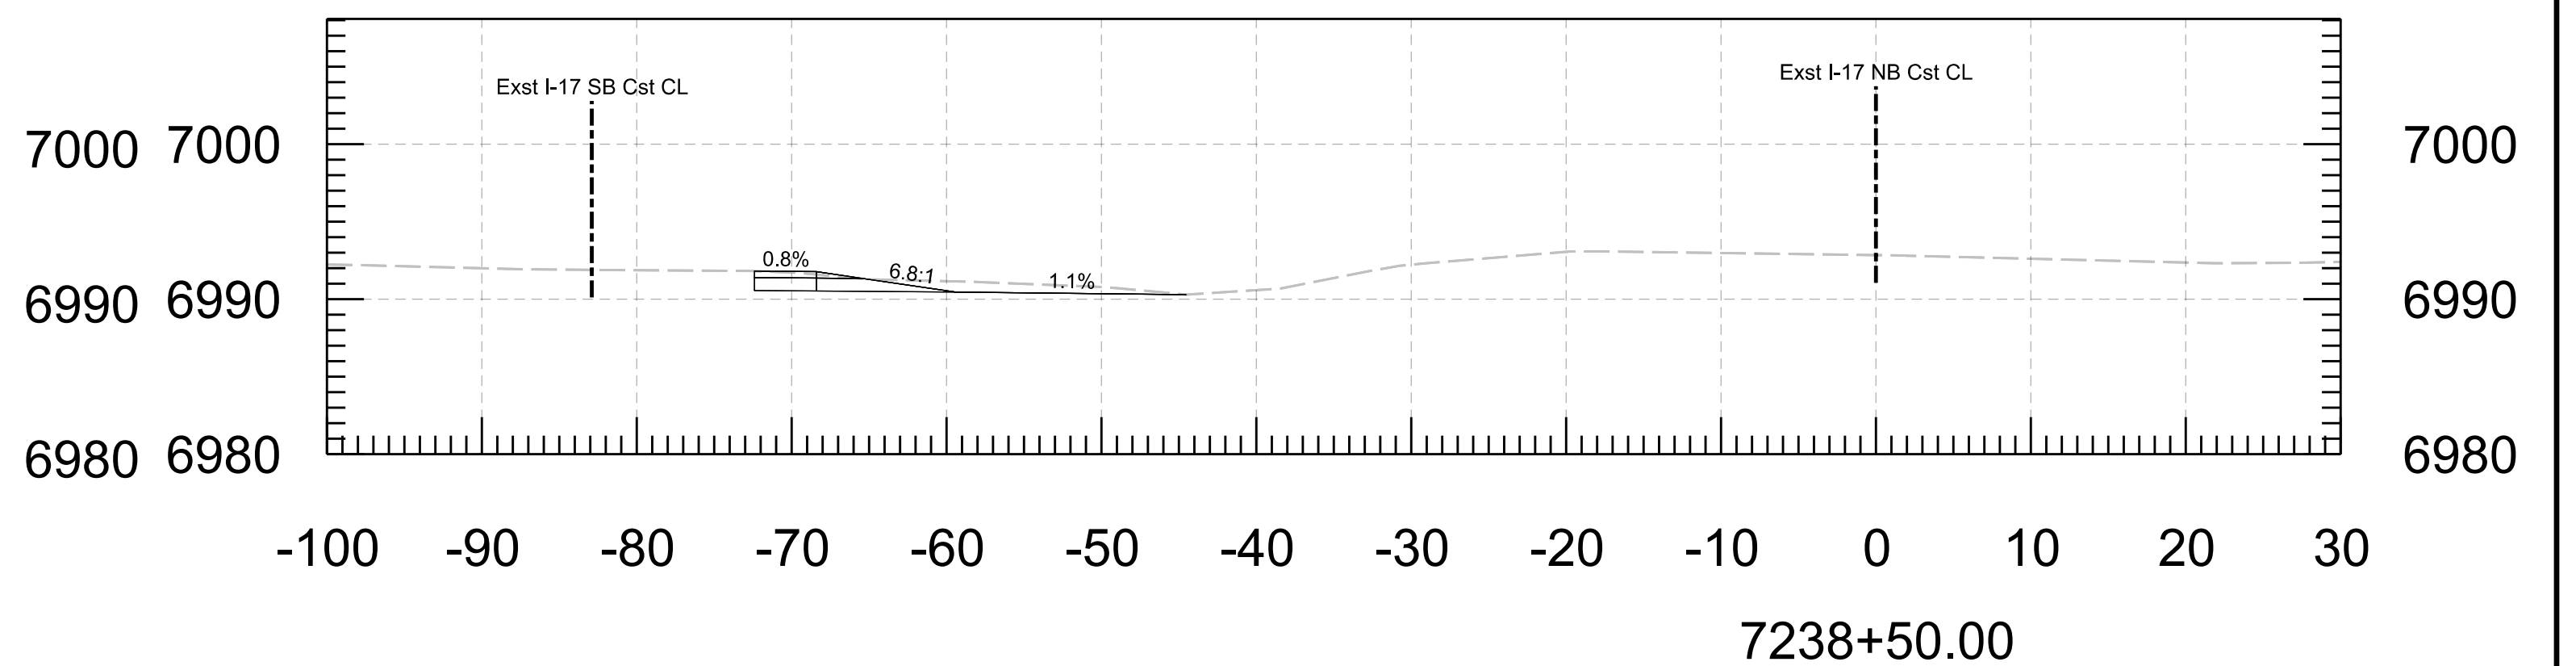
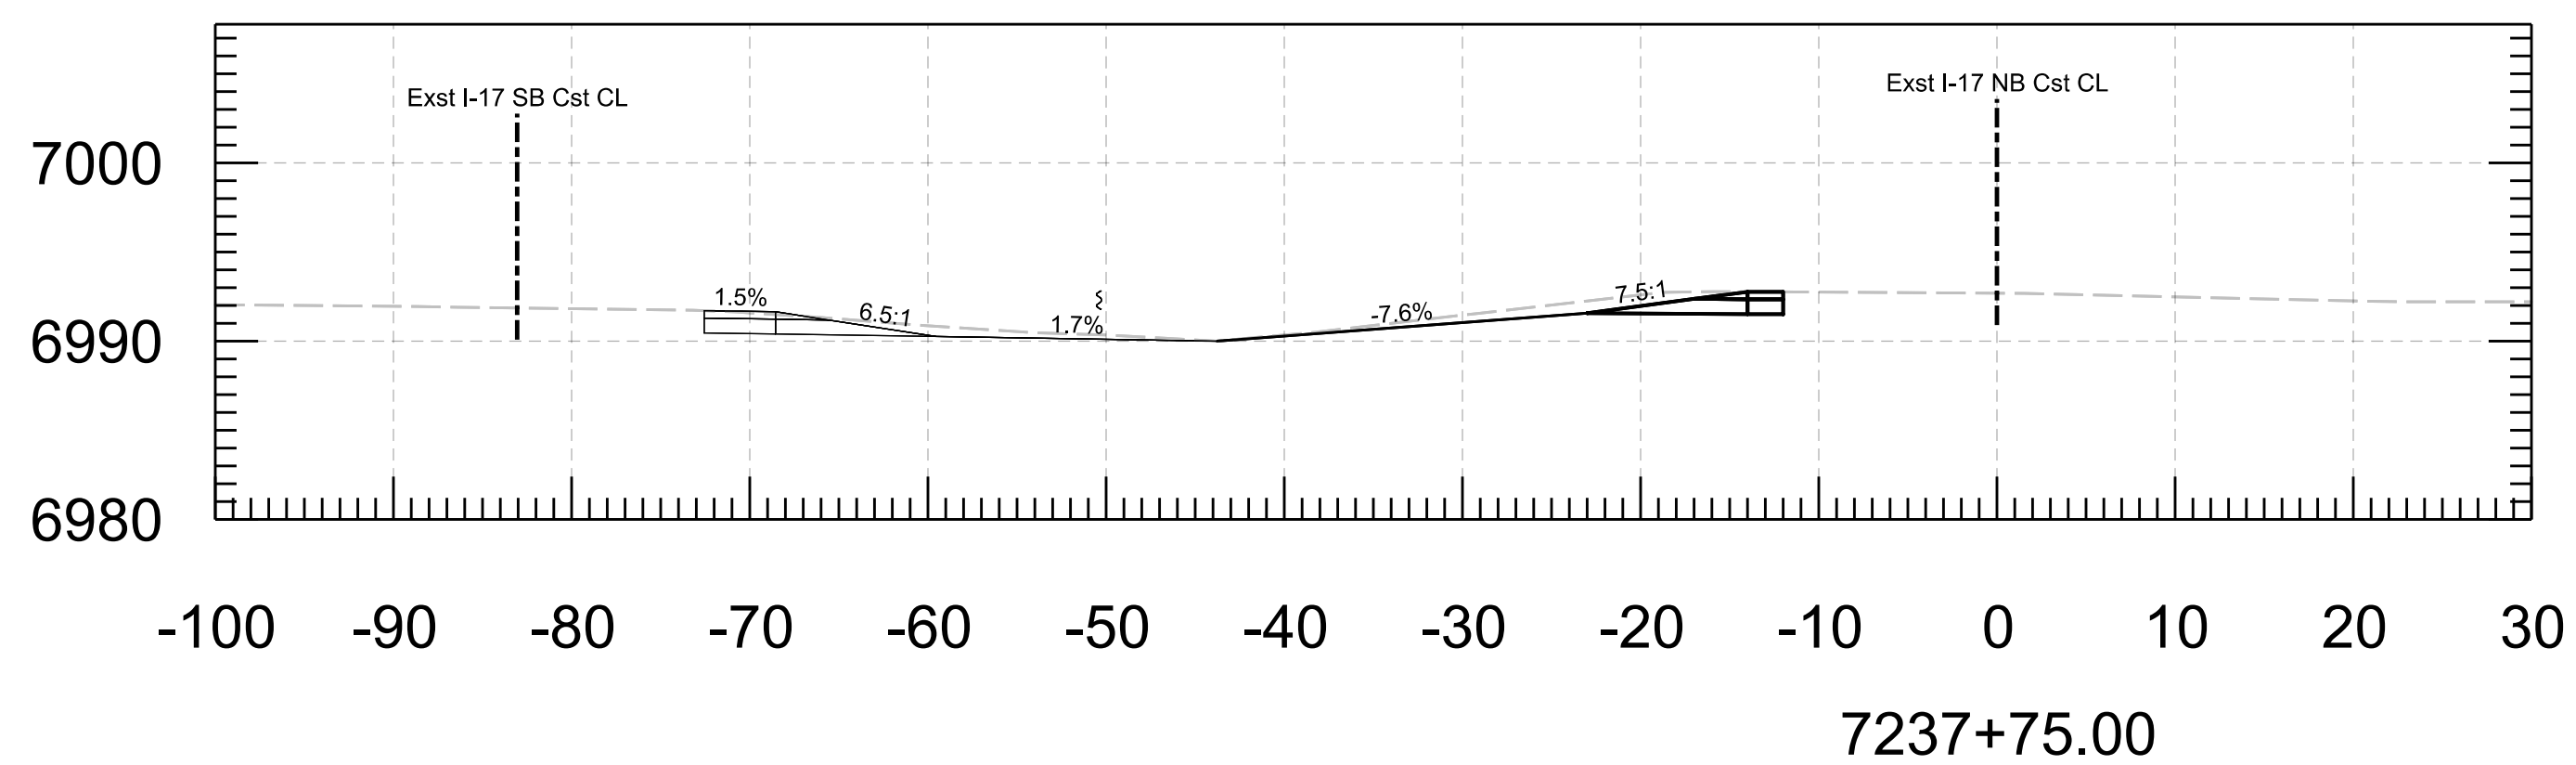
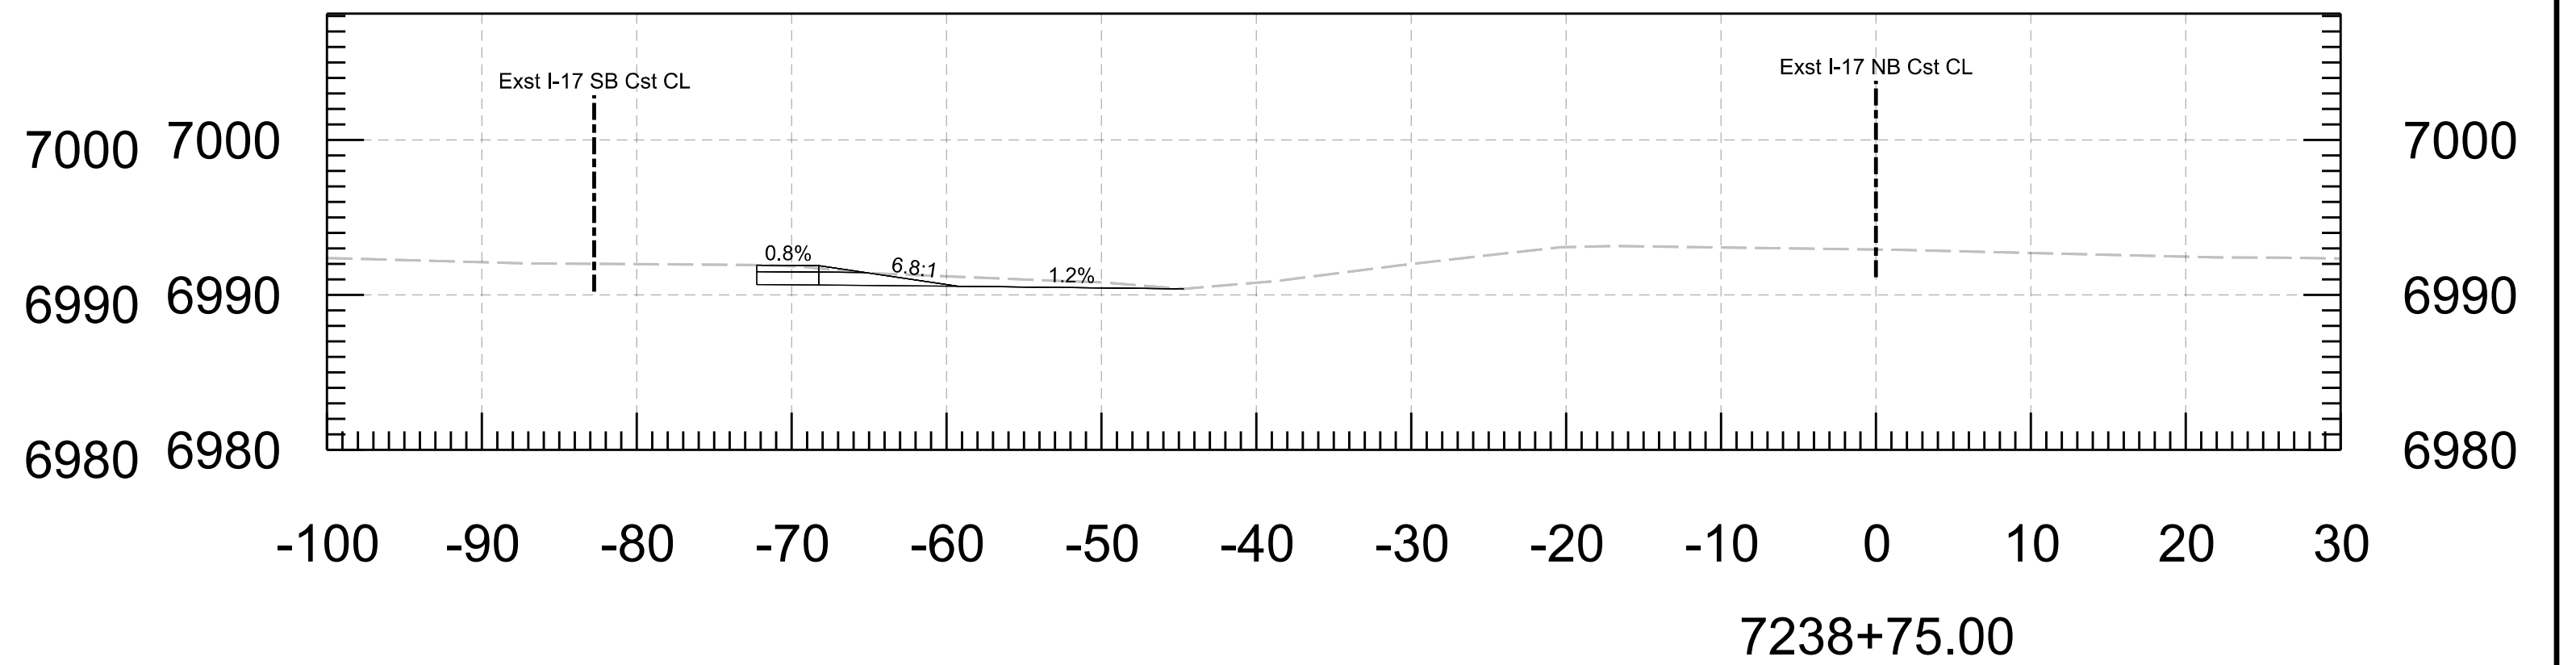
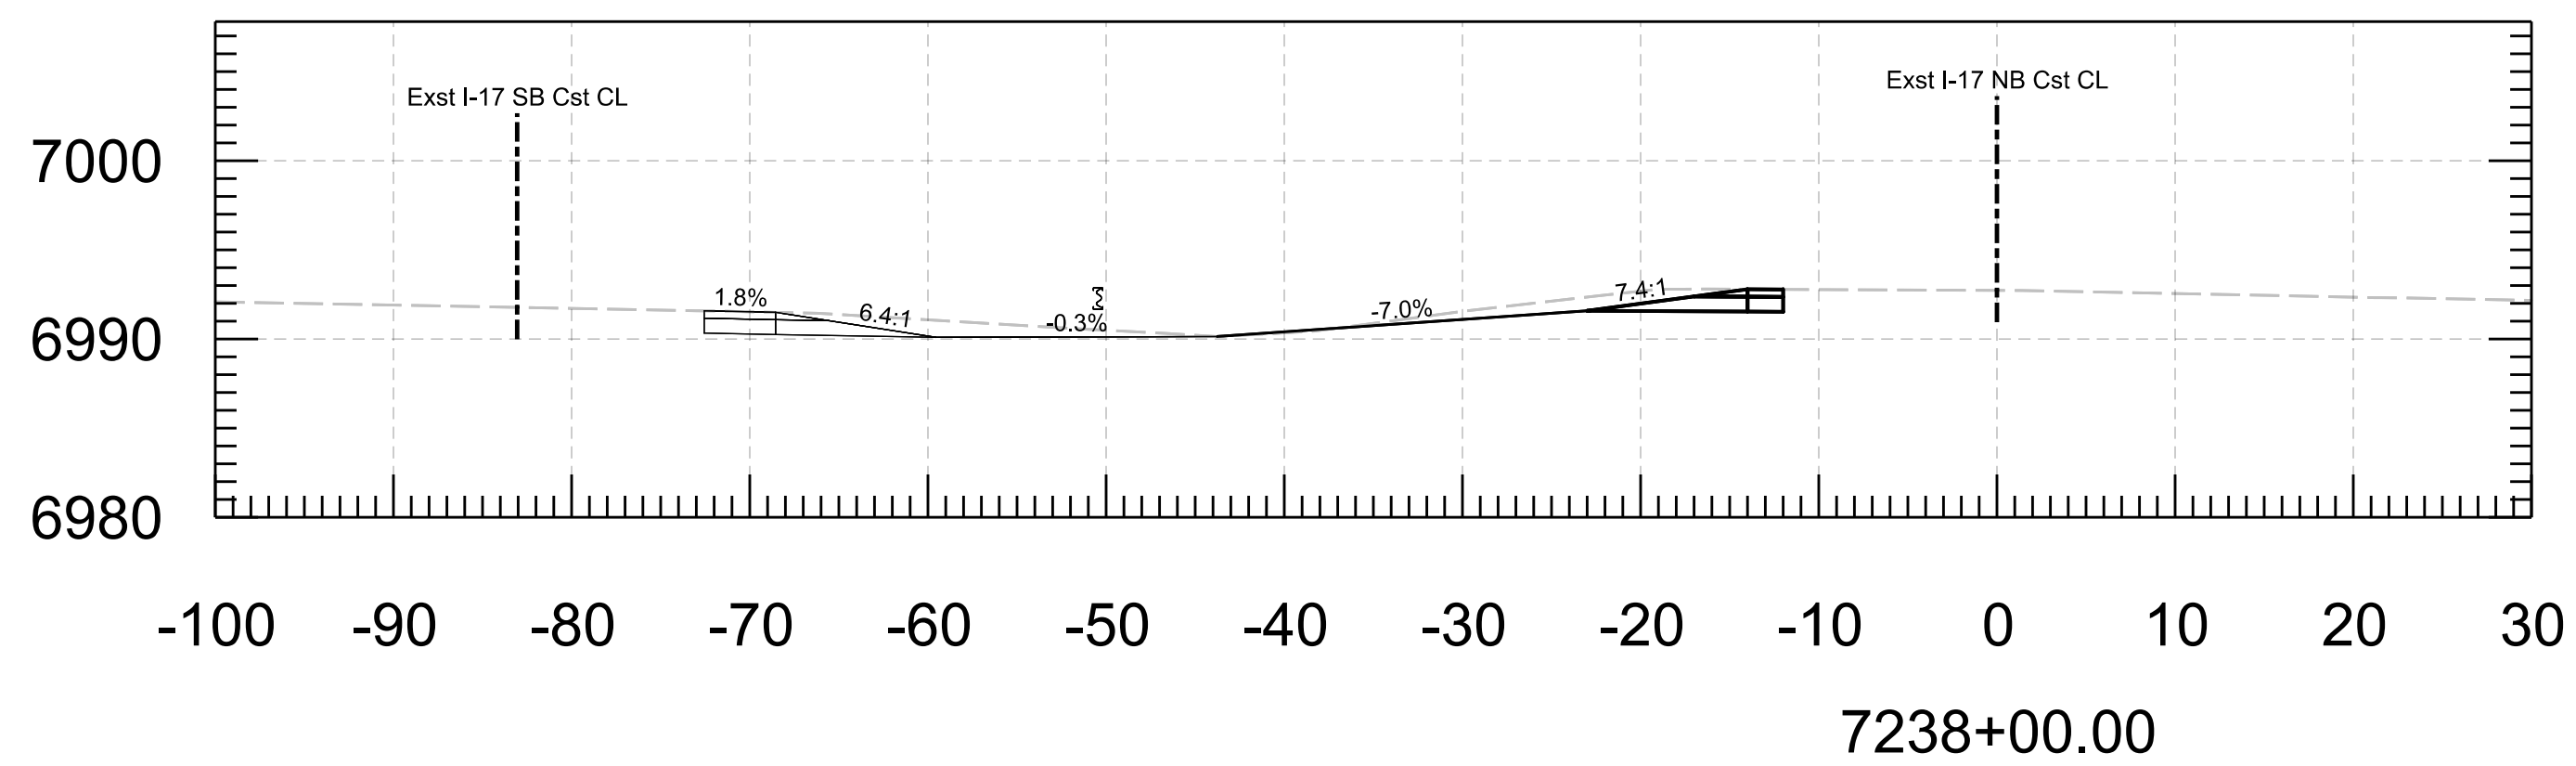
	DESIGN	J.NOYES	10/23	ARIZONA DEPARTMENT OF TRANSPORTATION INFRASTRUCTURE DELIVERY AND OPERATIONS DIVISION ROADWAY DESIGN SECTION	ROUTE	I-17	F.H.W.A. Arizona Division STATE ARIZ.	PROJECT NO.	017 CN 337	FEDERAL ID NO.	017-B(237)T	SHEET NO.	2	TOTAL SHEETS	27	RECORD DRAWING
	DRAWN	J.NOYES	10/23		MILEPOST	337.39		LOCATION	I-17 AIRPORT RD TI UP				DWG NO.			
	CHECKED	L.BUSENBARK	10/23		STRUCTURE NO.			TRACS NO.	F0362 01C				OF			
HDR, INC. 20 E. THOMAS ROAD SUITE 2500 PHOENIX, AZ 85012 TEL. (602) 522-7700				CROSS SECTIONS EXST I-17 NB												

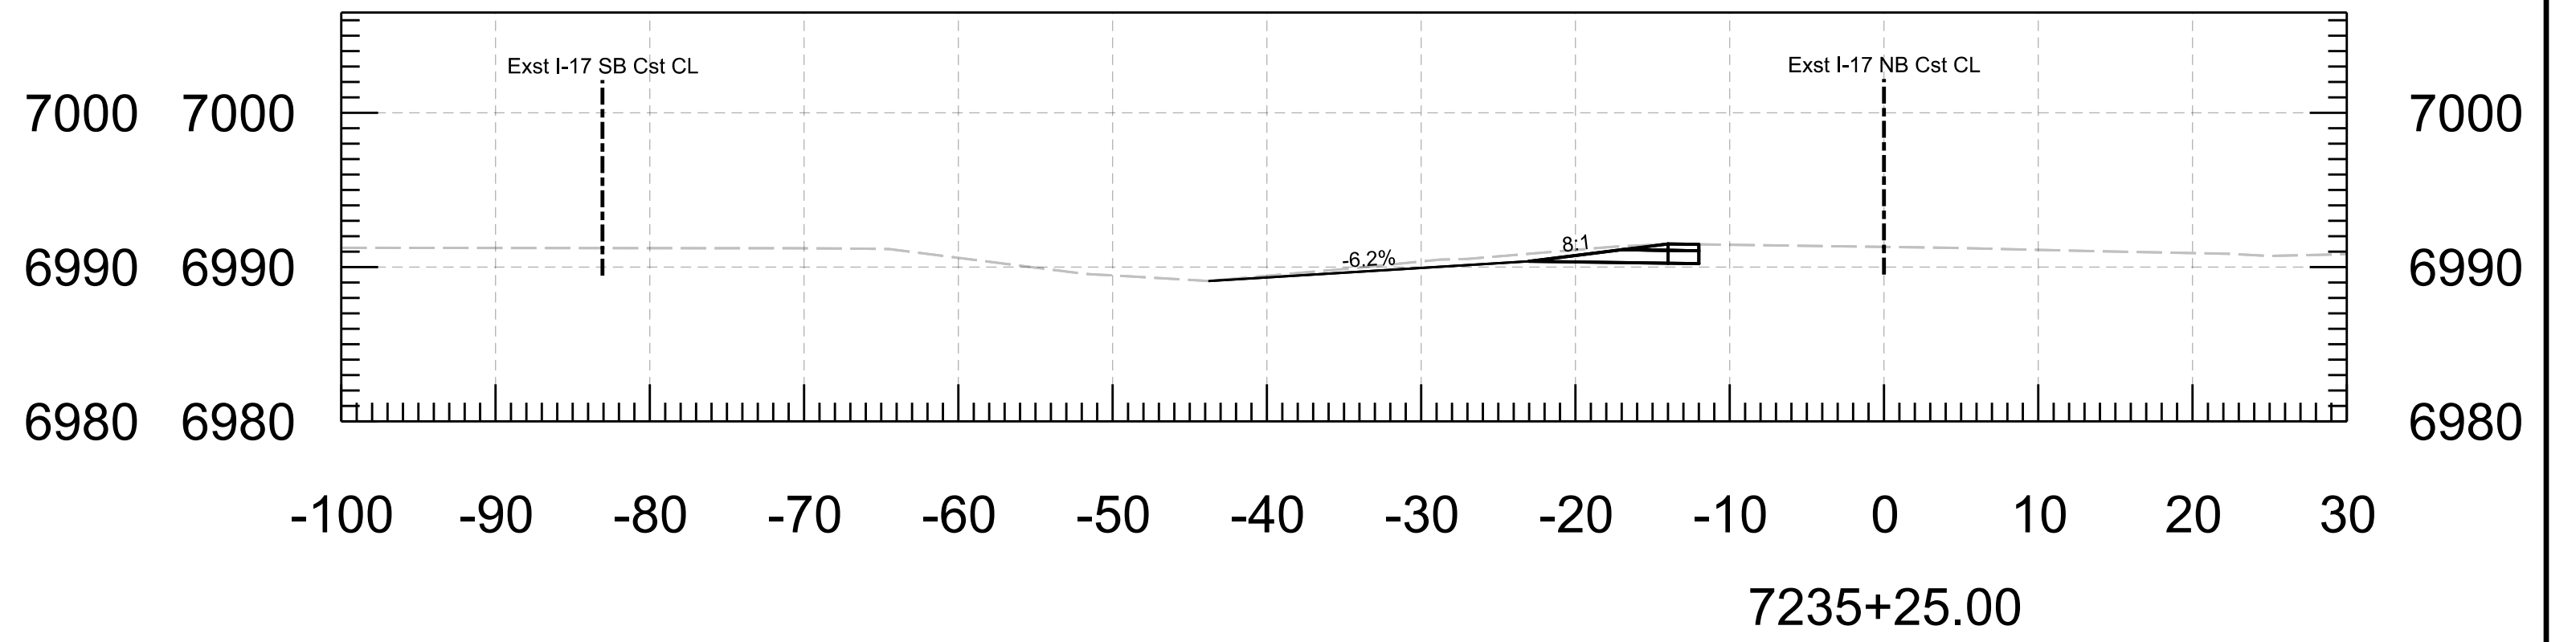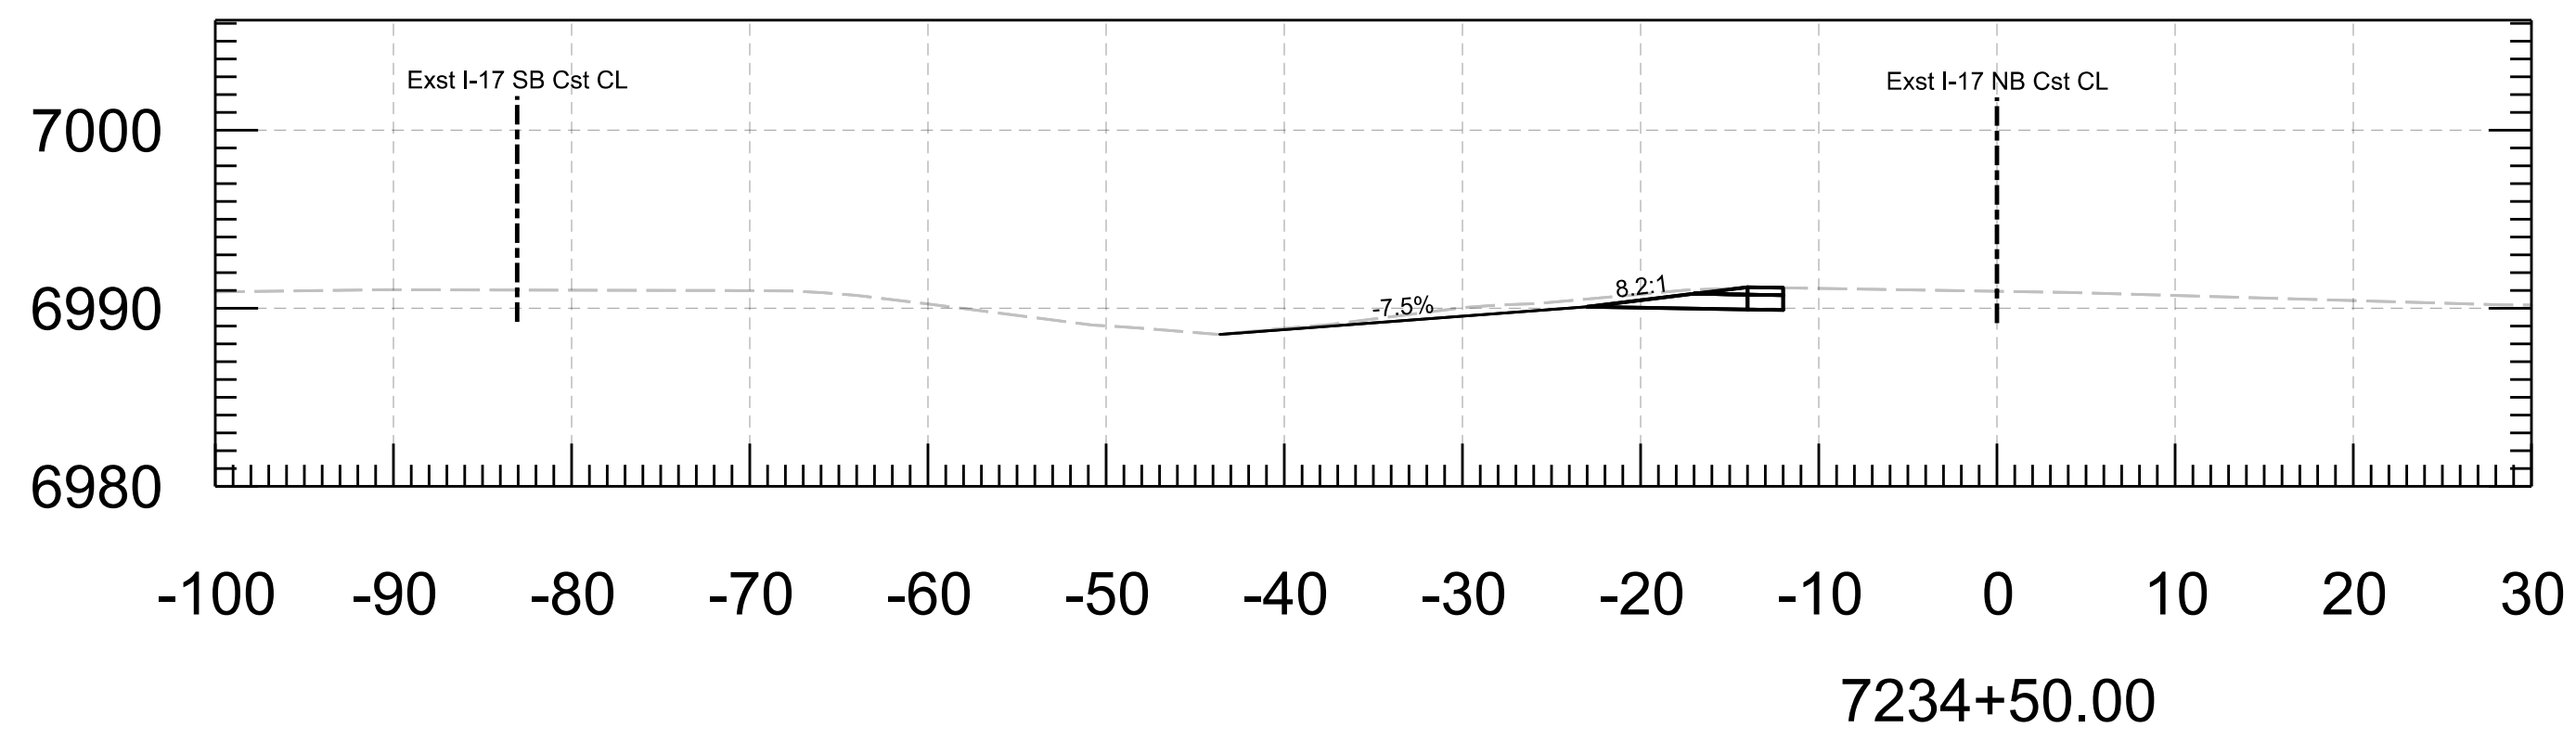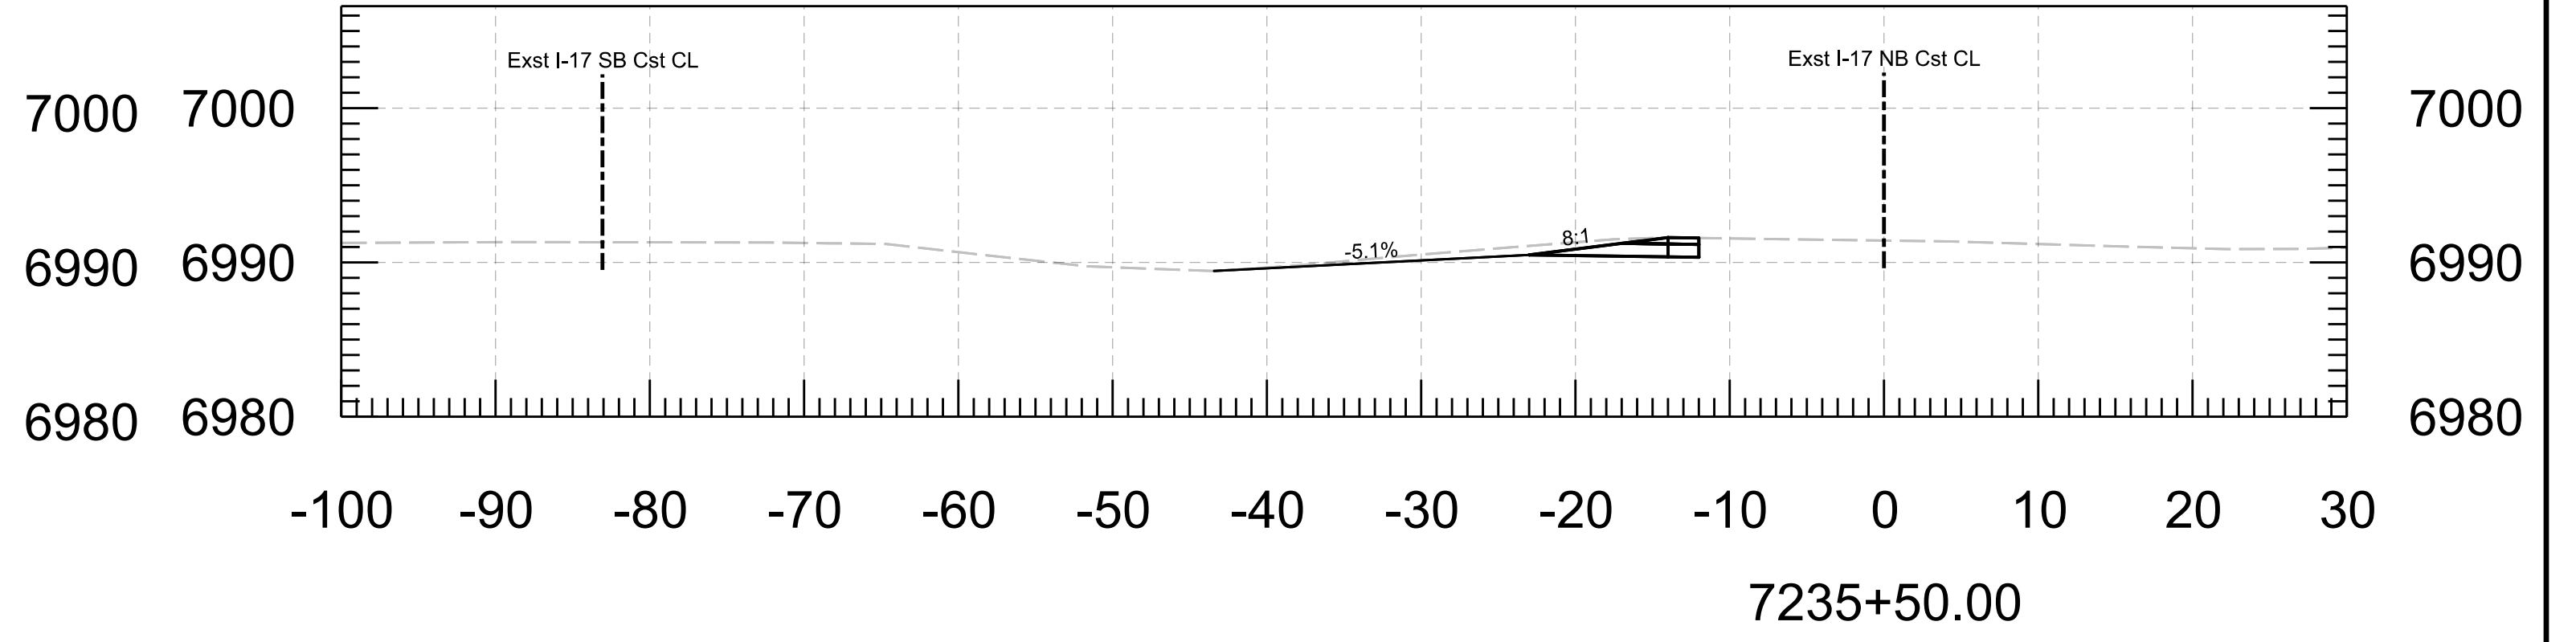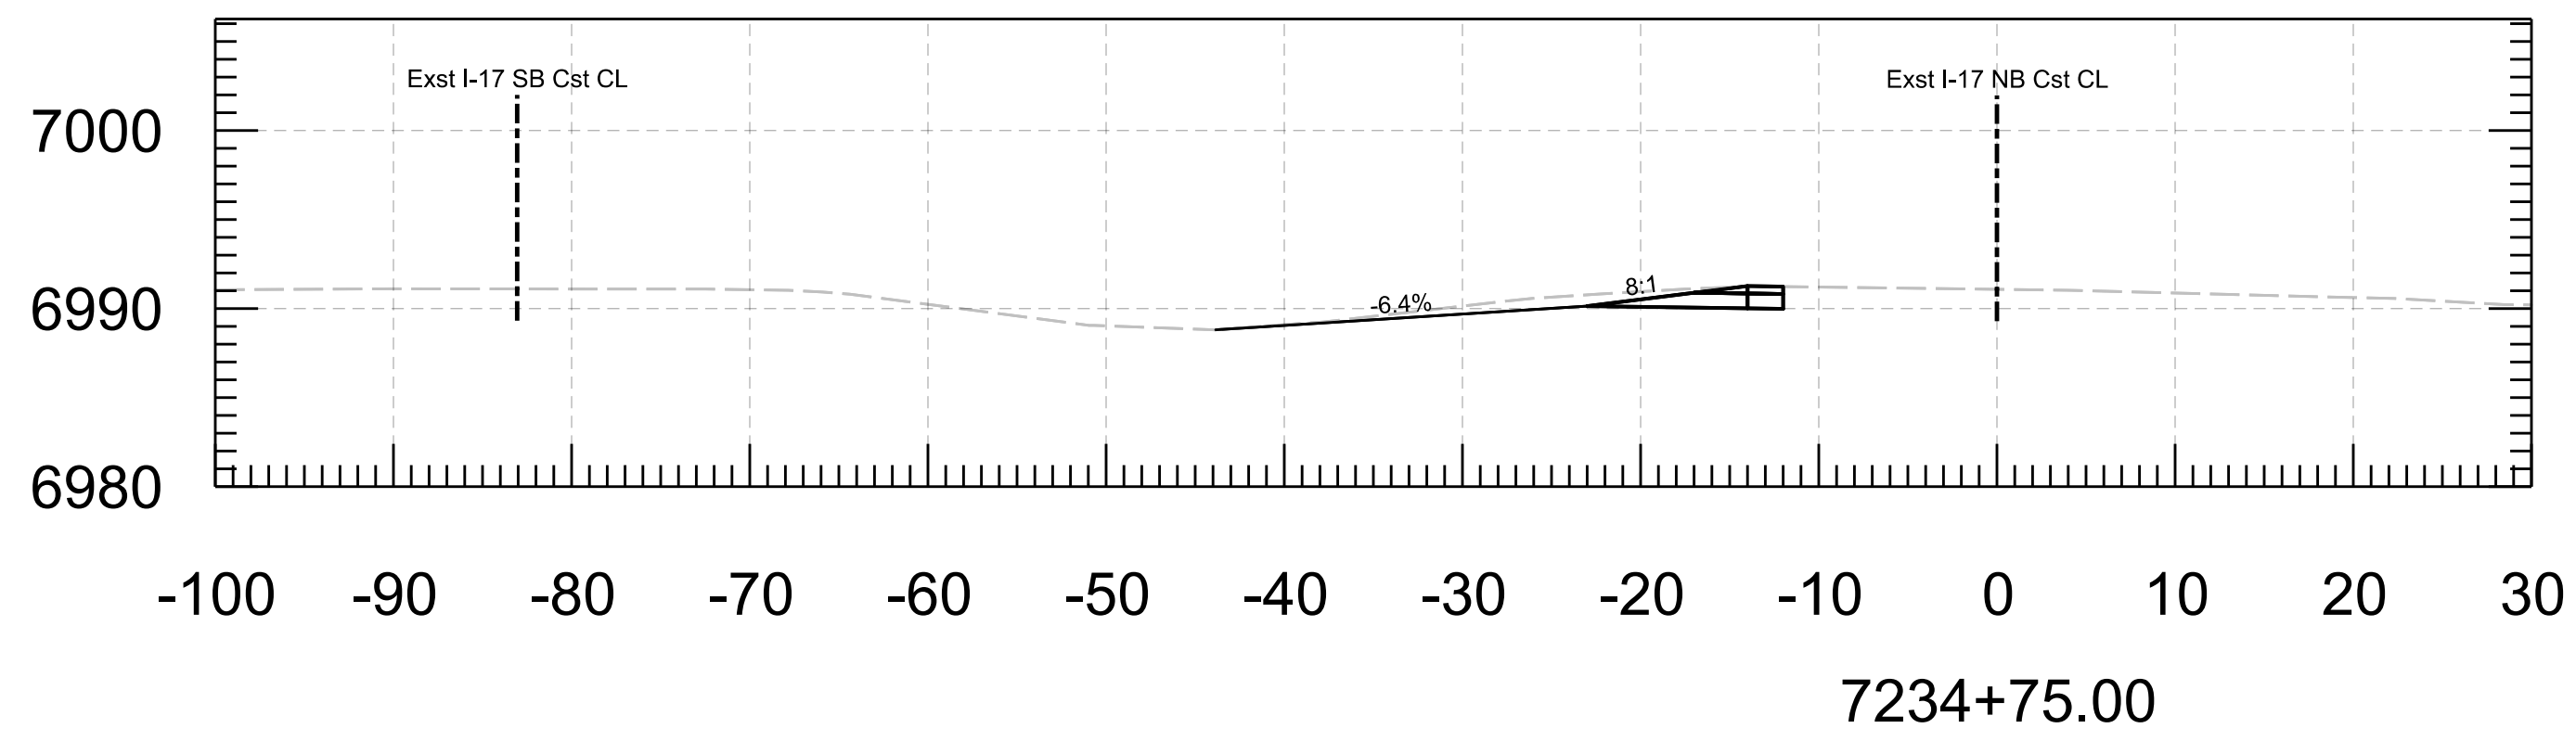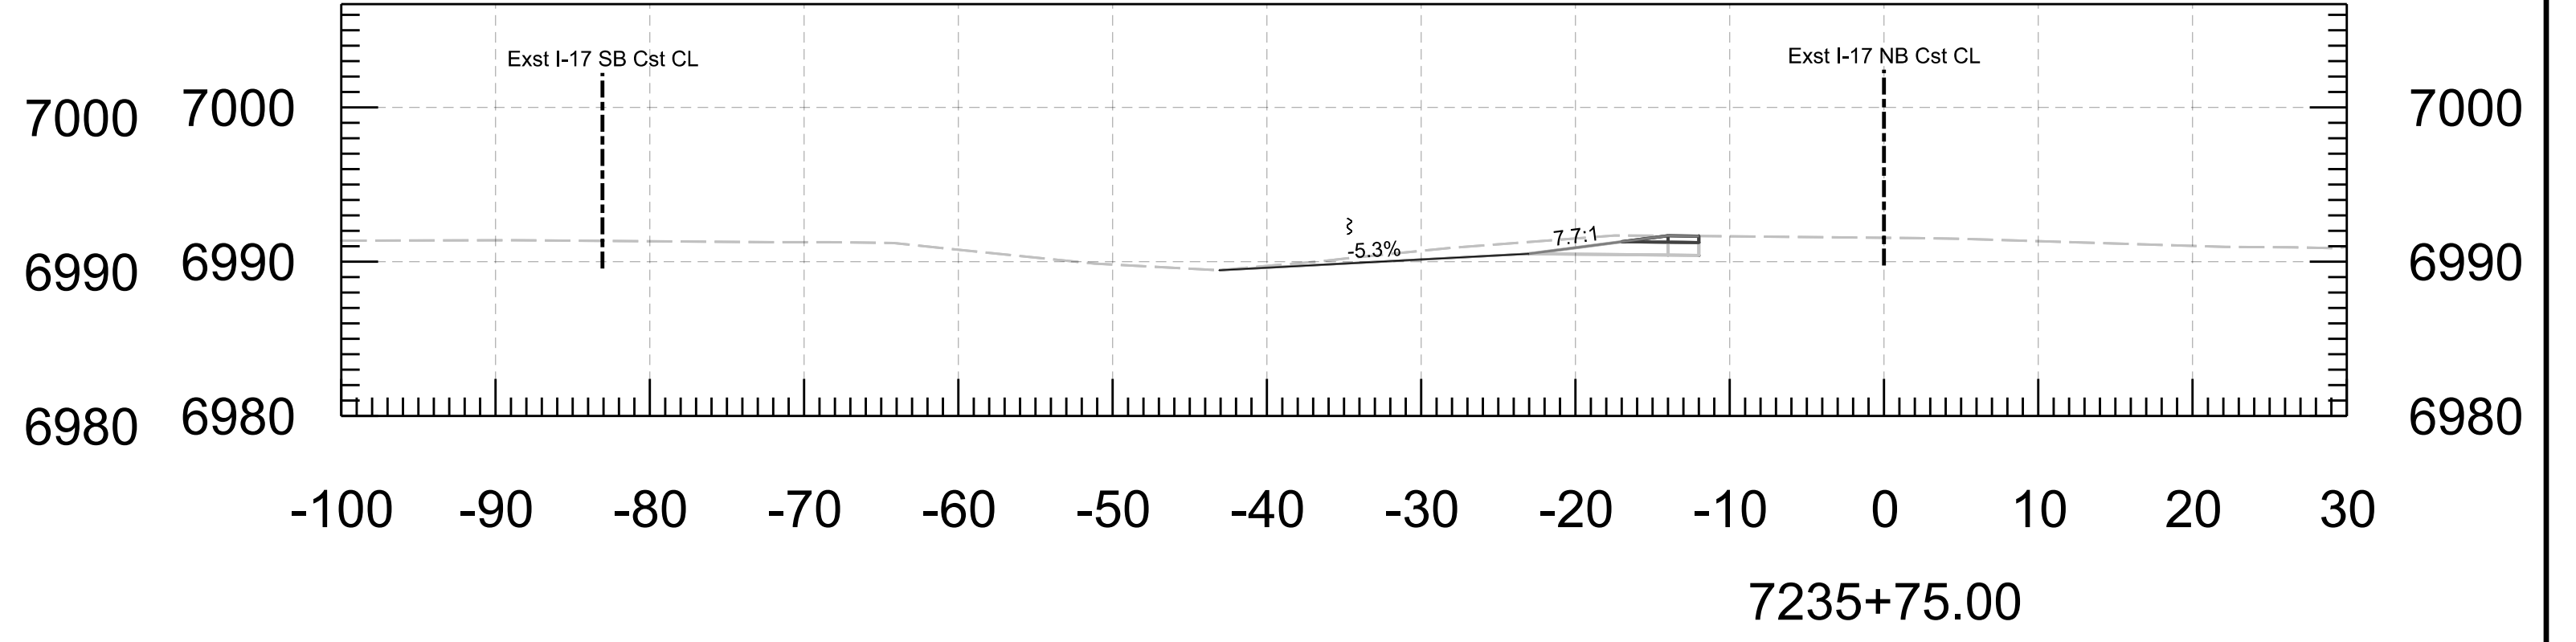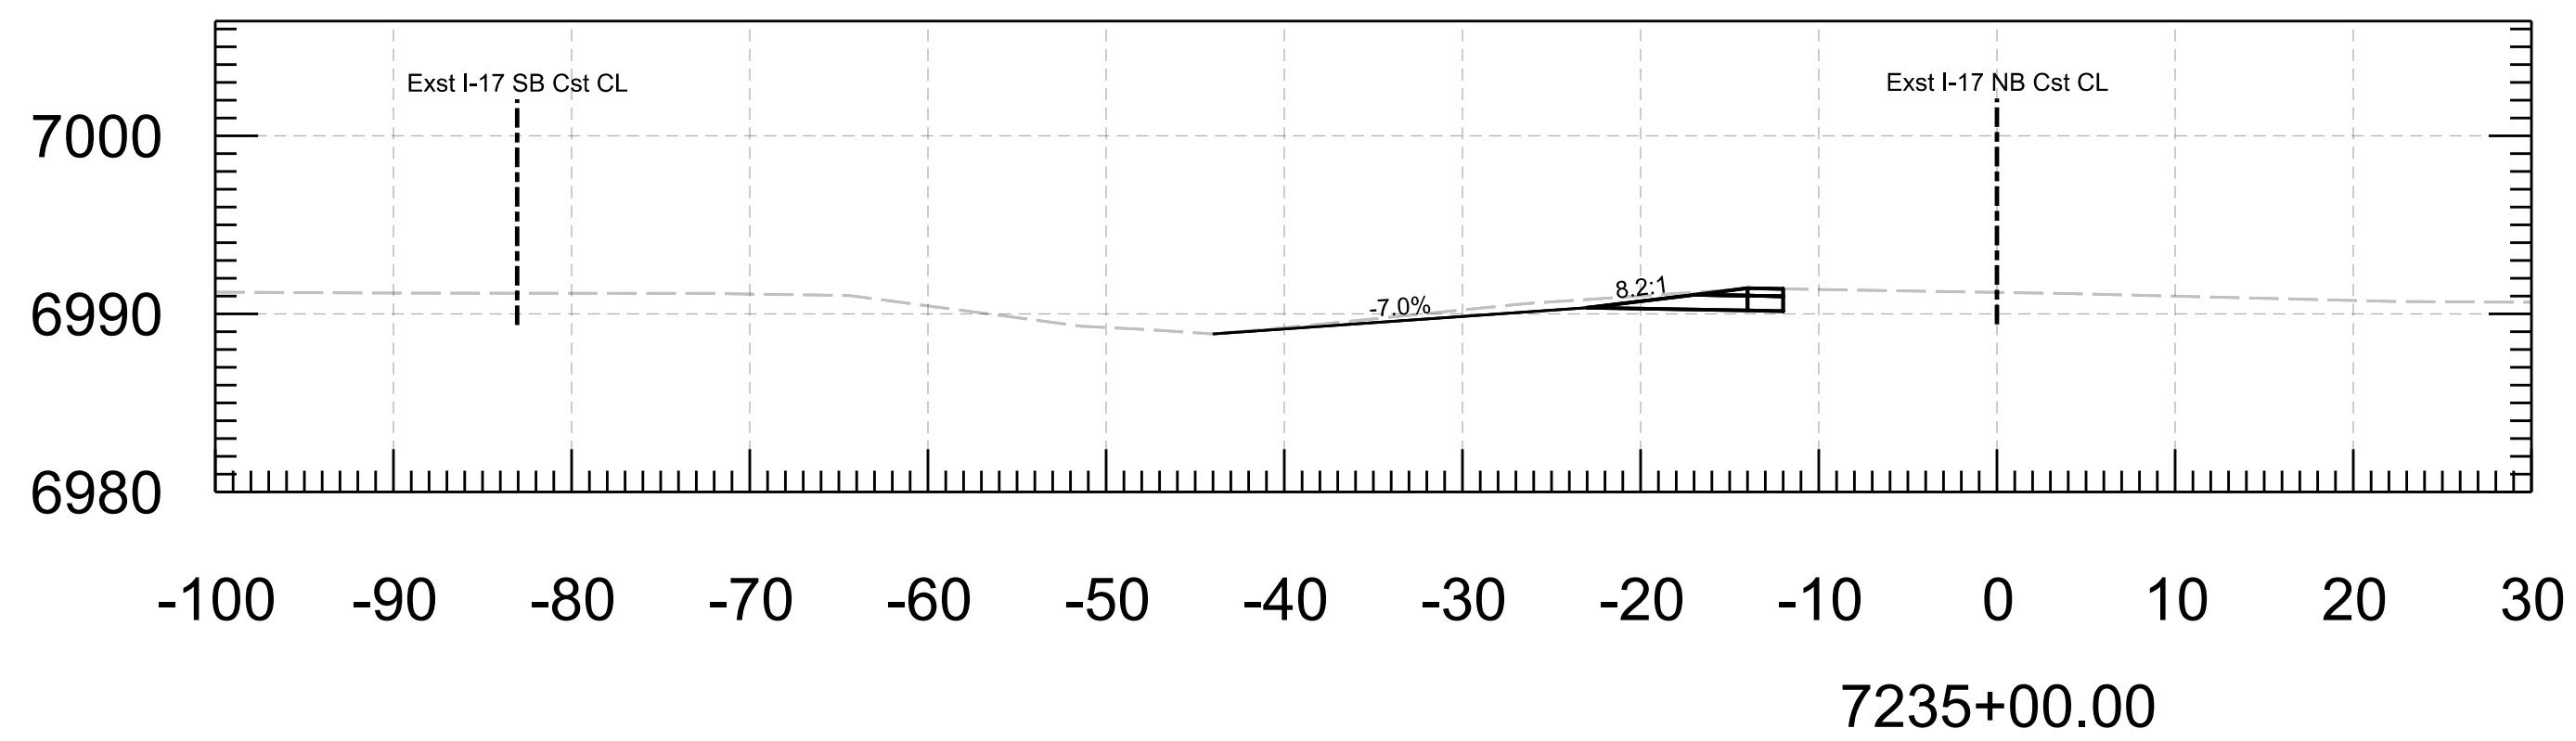


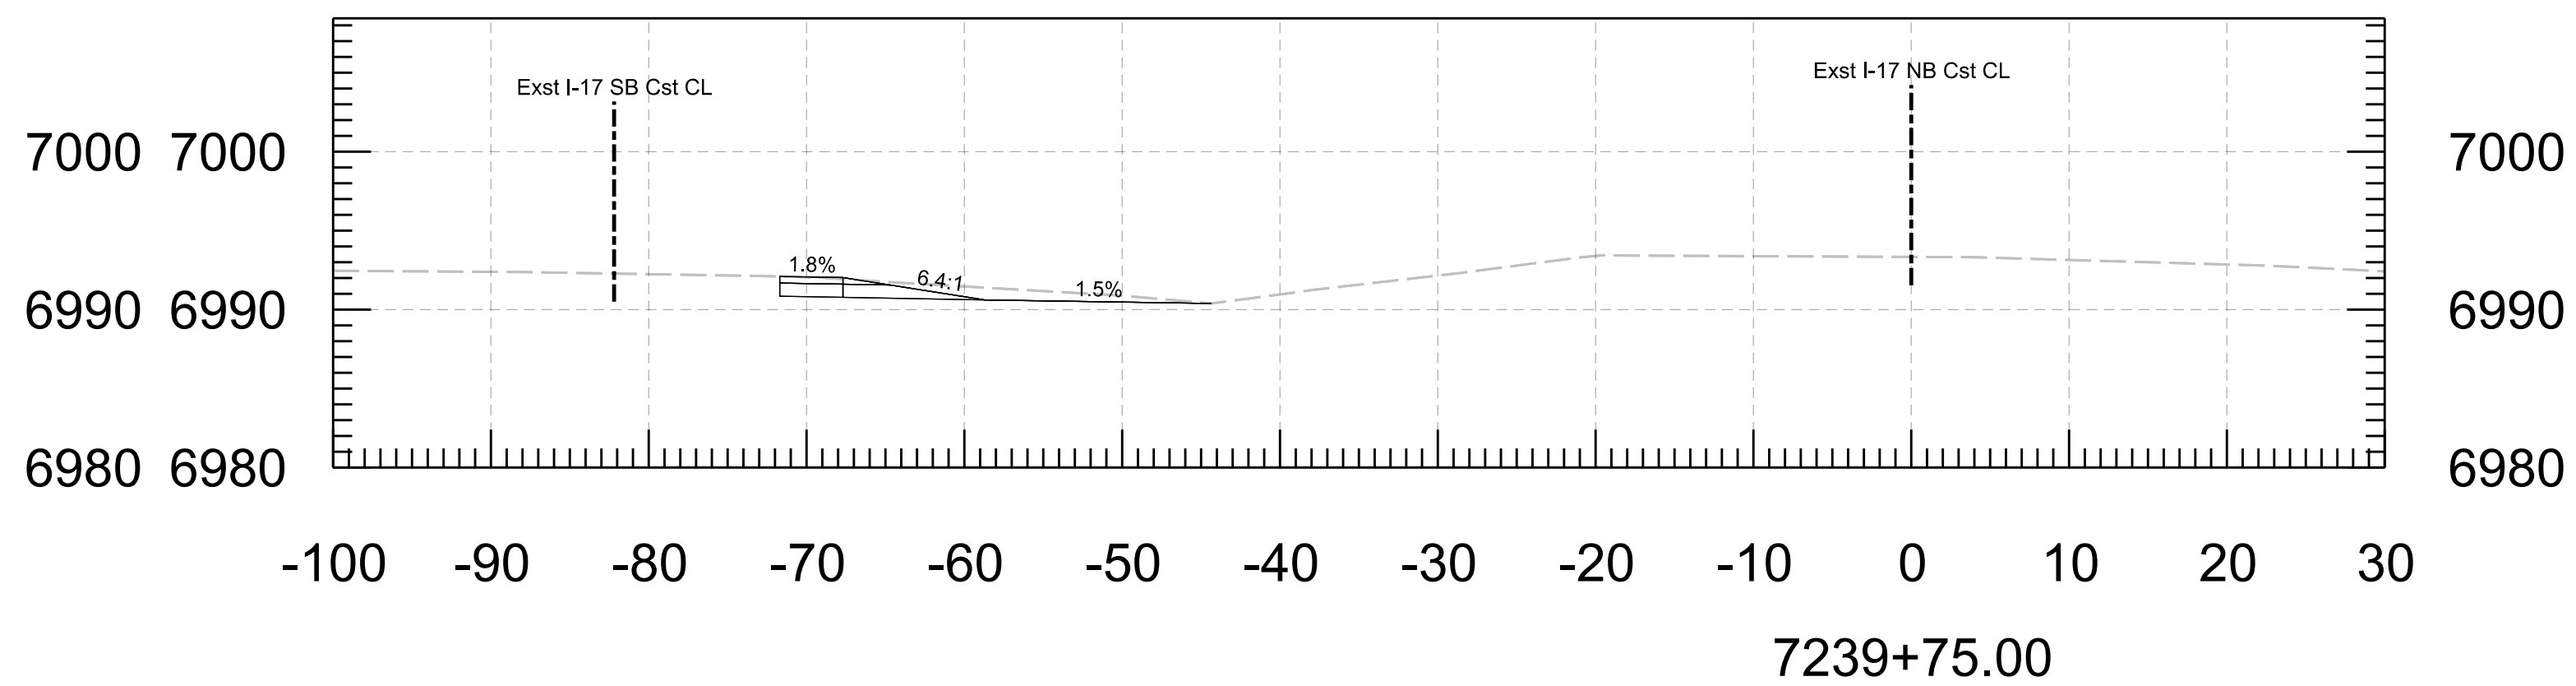
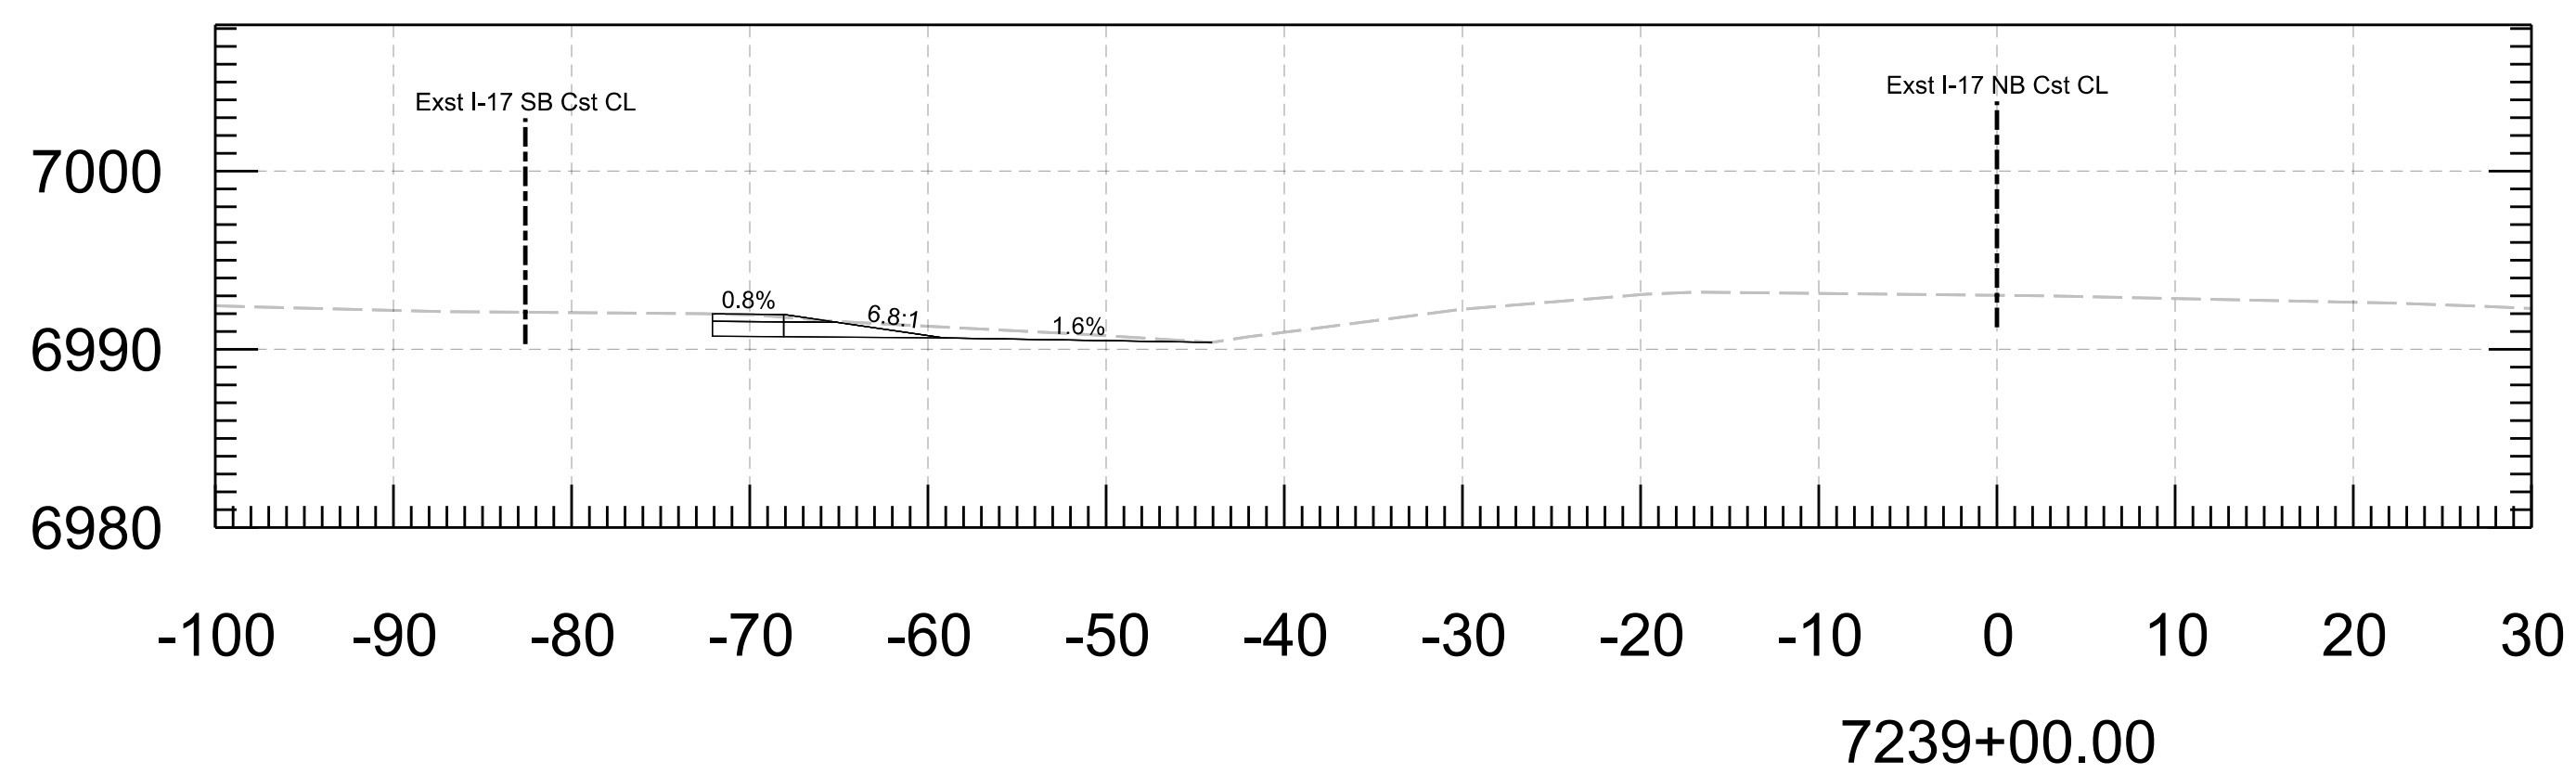
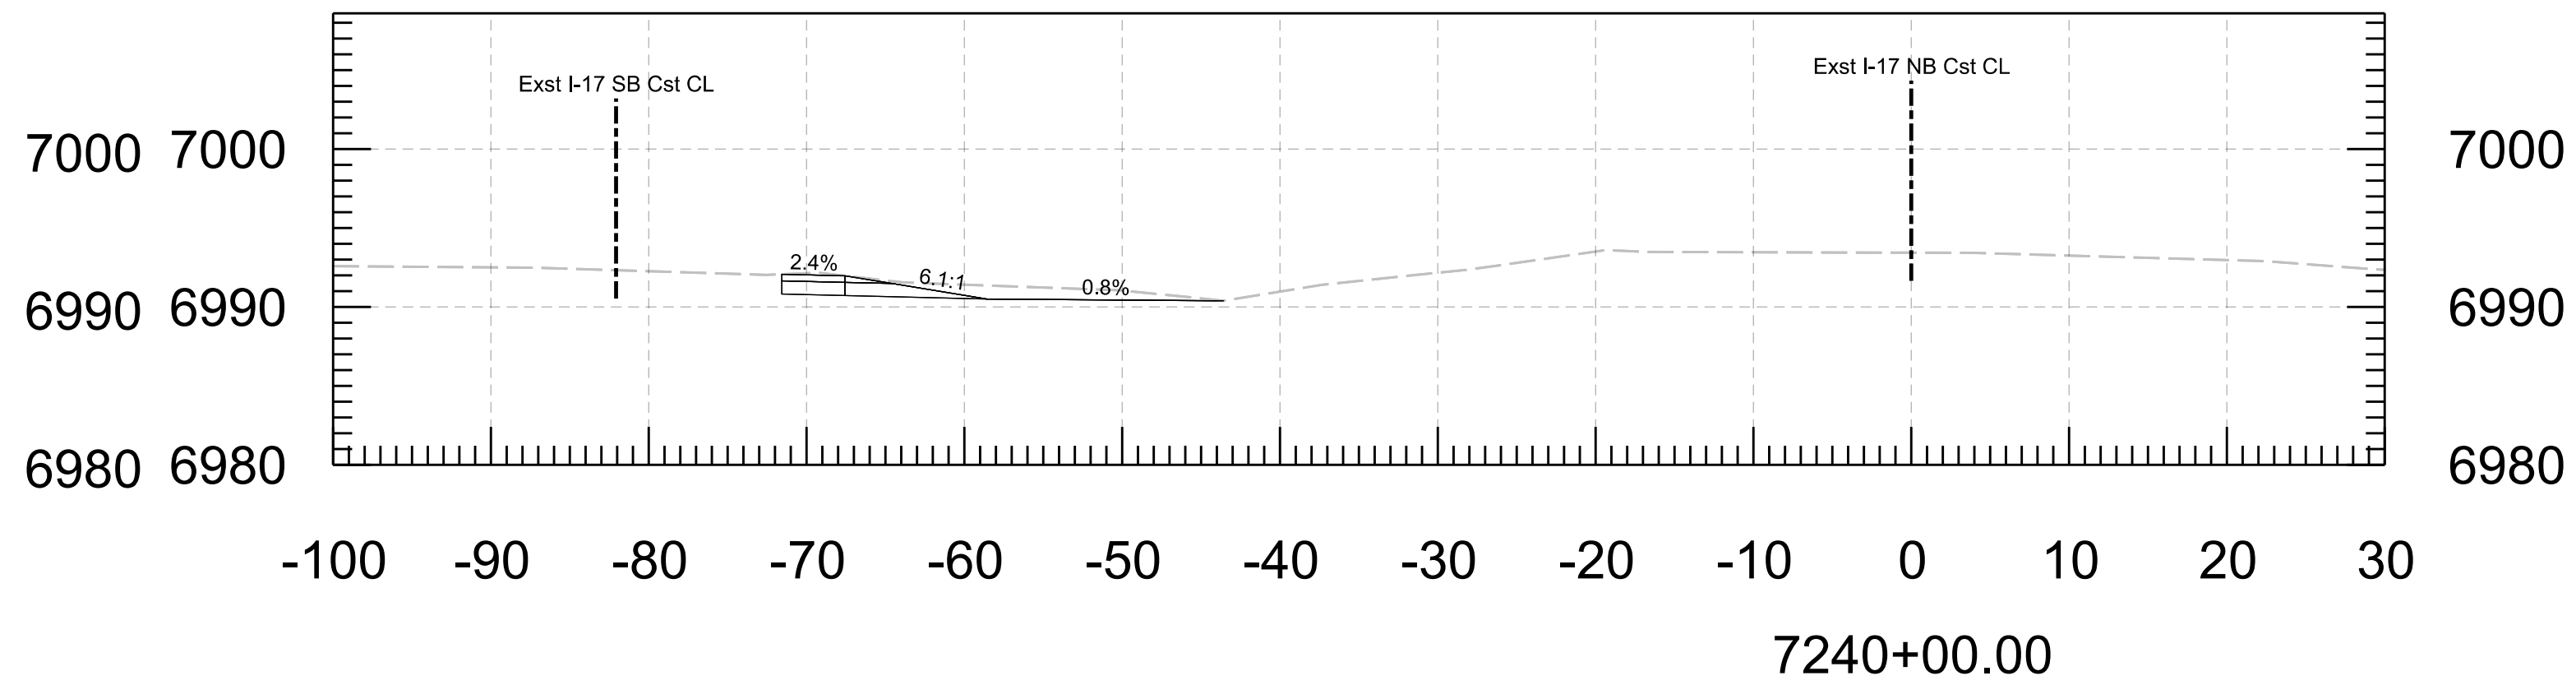
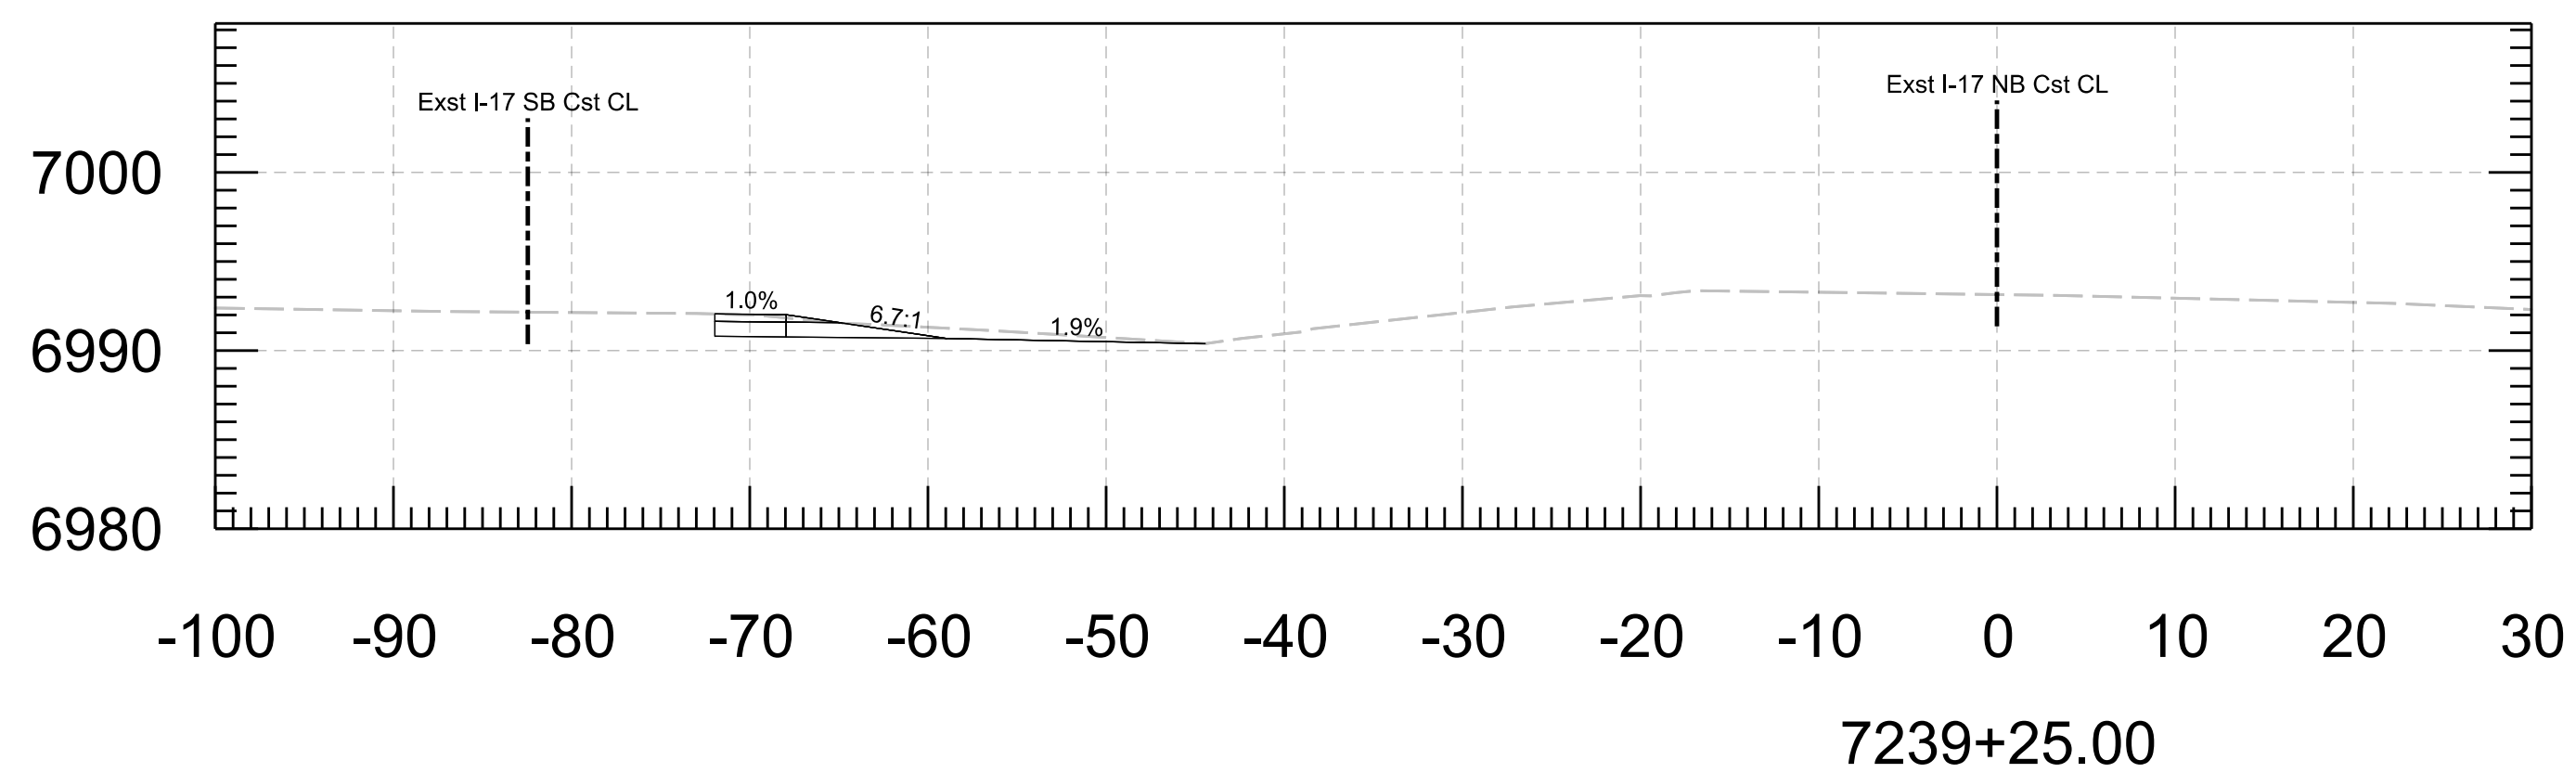
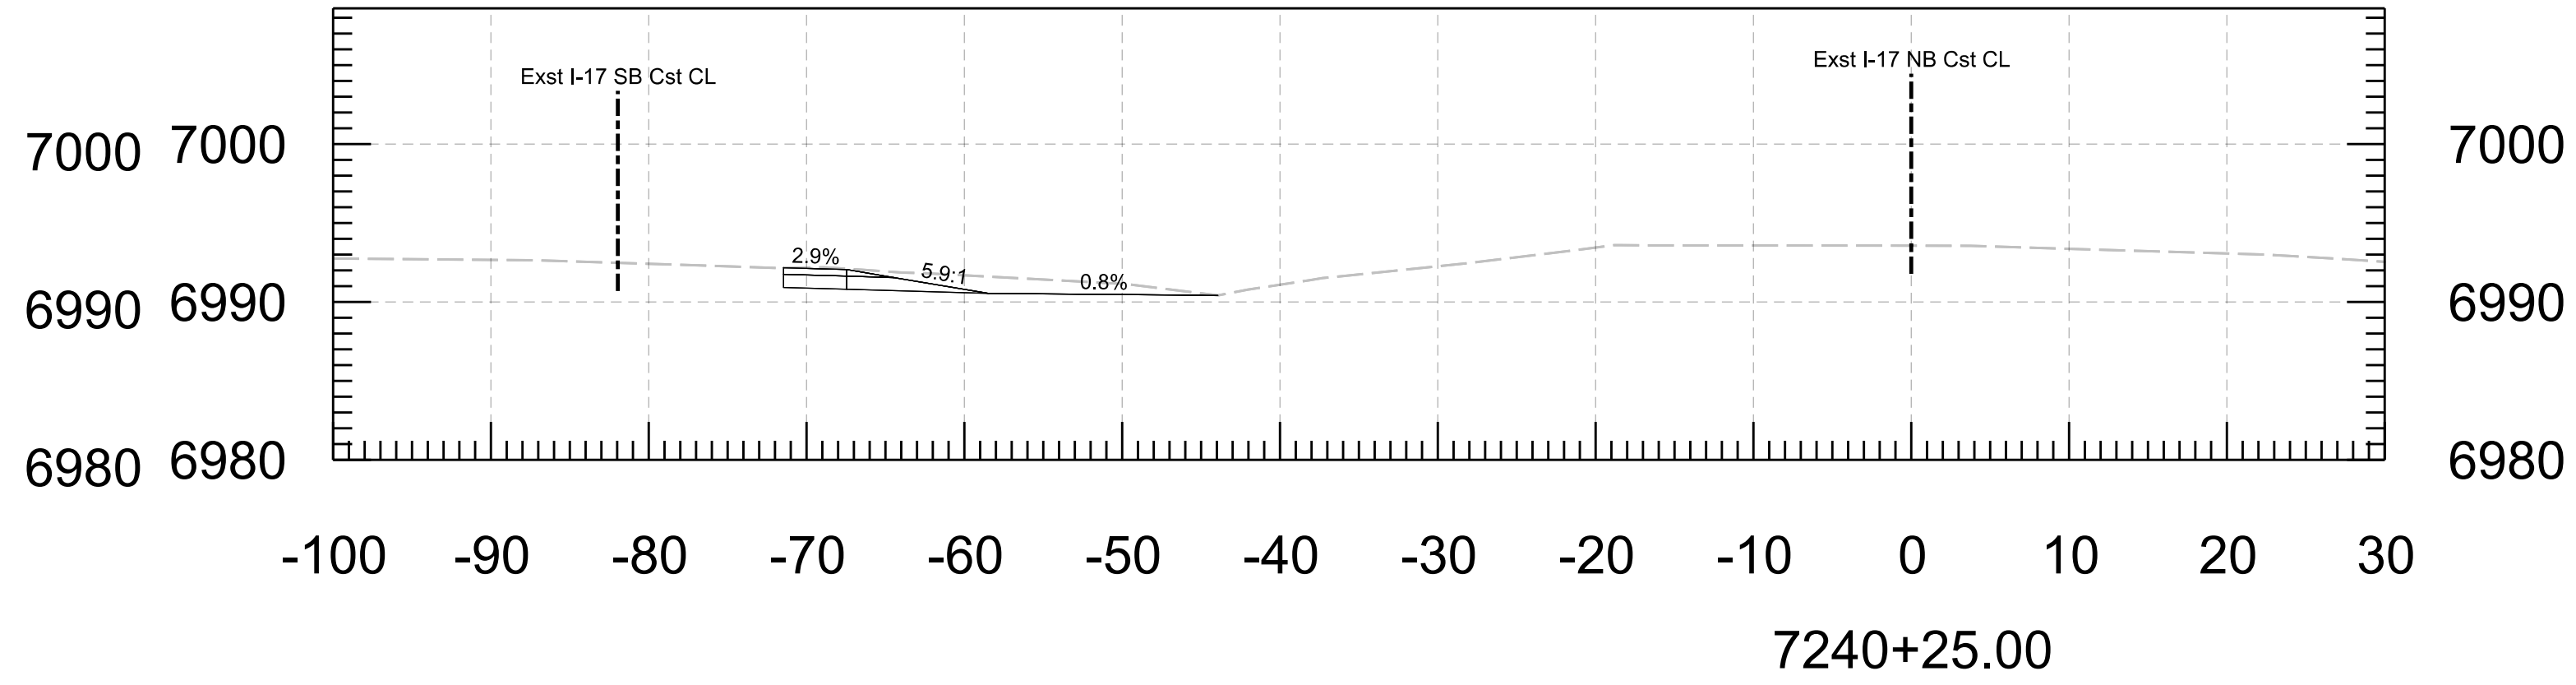
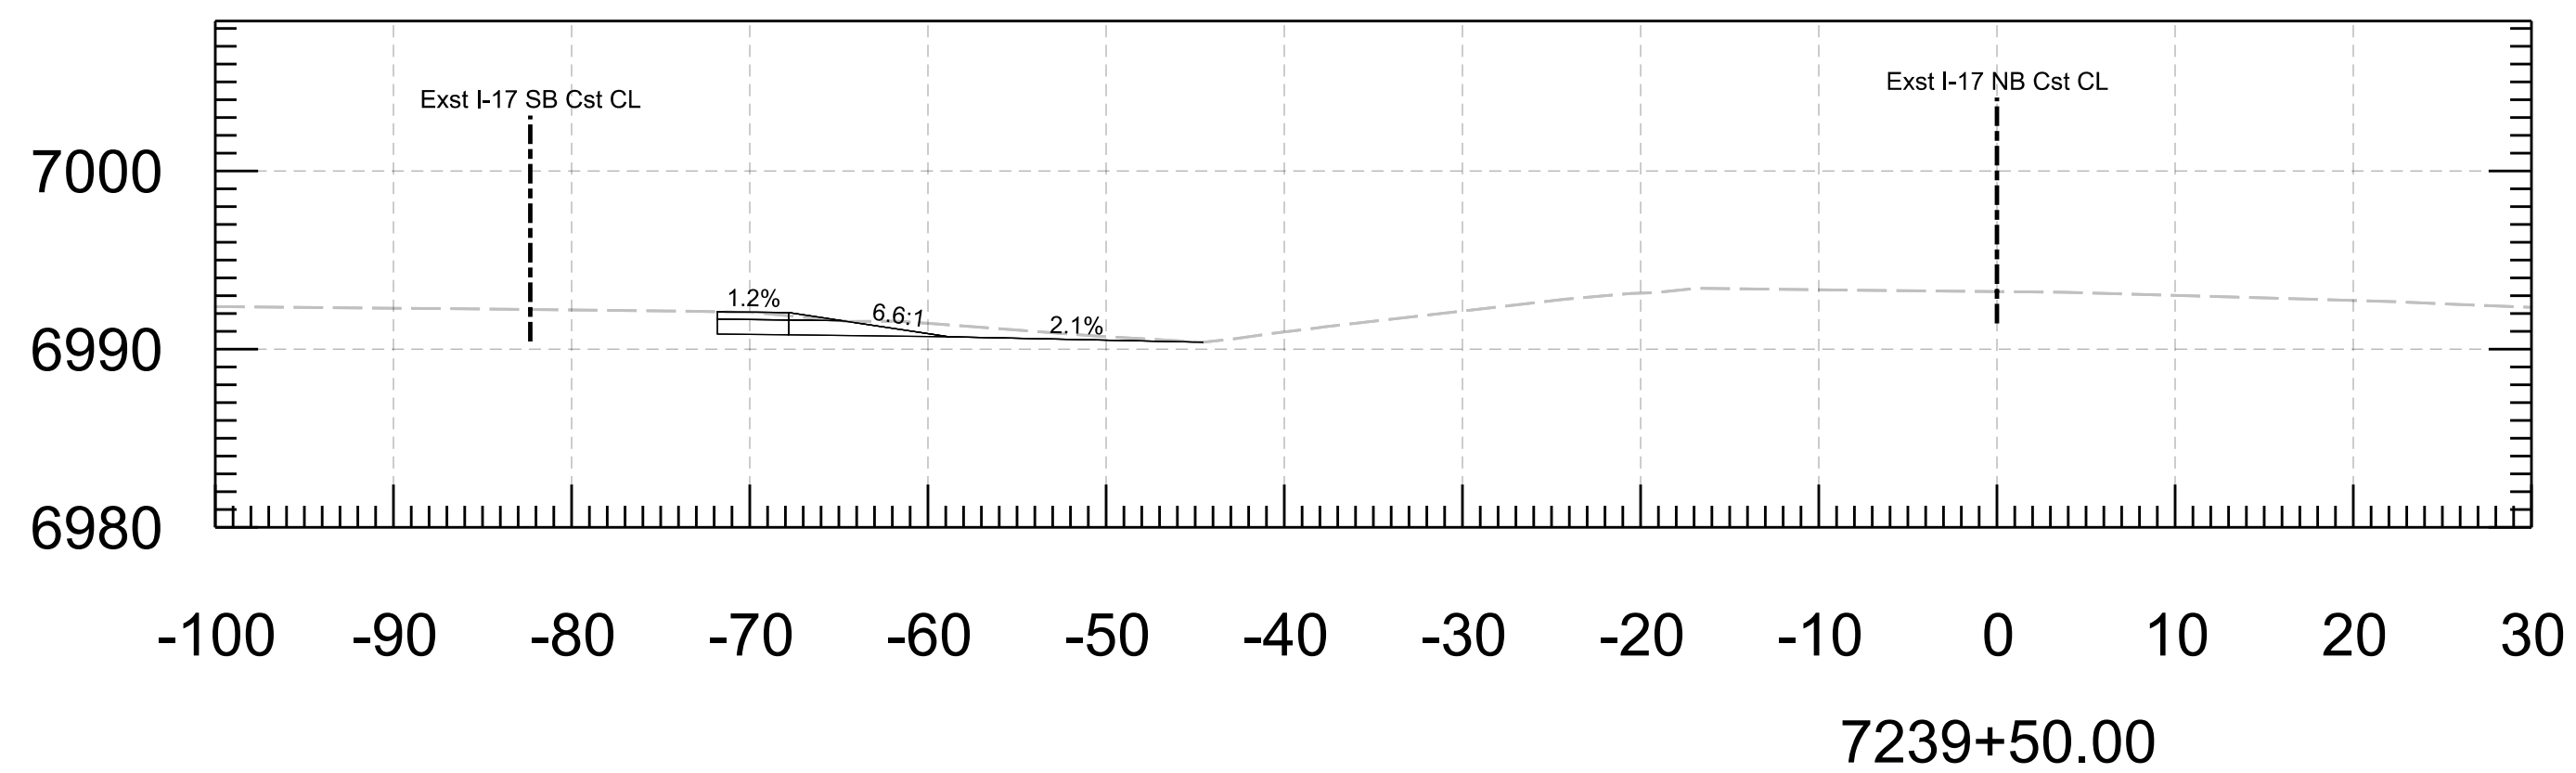
	DESIGN	J.NOYES	10/23	ARIZONA DEPARTMENT OF TRANSPORTATION INFRASTRUCTURE DELIVERY AND OPERATIONS DIVISION ROADWAY DESIGN SECTION	ROUTE	I-17	F.H.W.A. Arizona Division STATE ARIZ.	PROJECT NO.	017 CN 337	FEDERAL ID NO.	017-B(237)T	SHEET NO.	3	TOTAL SHEETS	27	RECORD DRAWING
	DRAWN	J.NOYES	10/23		MILEPOST	337.39		LOCATION	I-17 AIRPORT RD TI UP				DWG NO.			
	CHECKED	L.BUSENBARK	10/23		STRUCTURE NO.			TRACS NO.	F0362 01C				OF			
HDR, INC. 20 E. THOMAS ROAD SUITE 2500 PHOENIX, AZ 85012 TEL. (602) 522-7700				CROSS SECTIONS EXST I-17 NB												

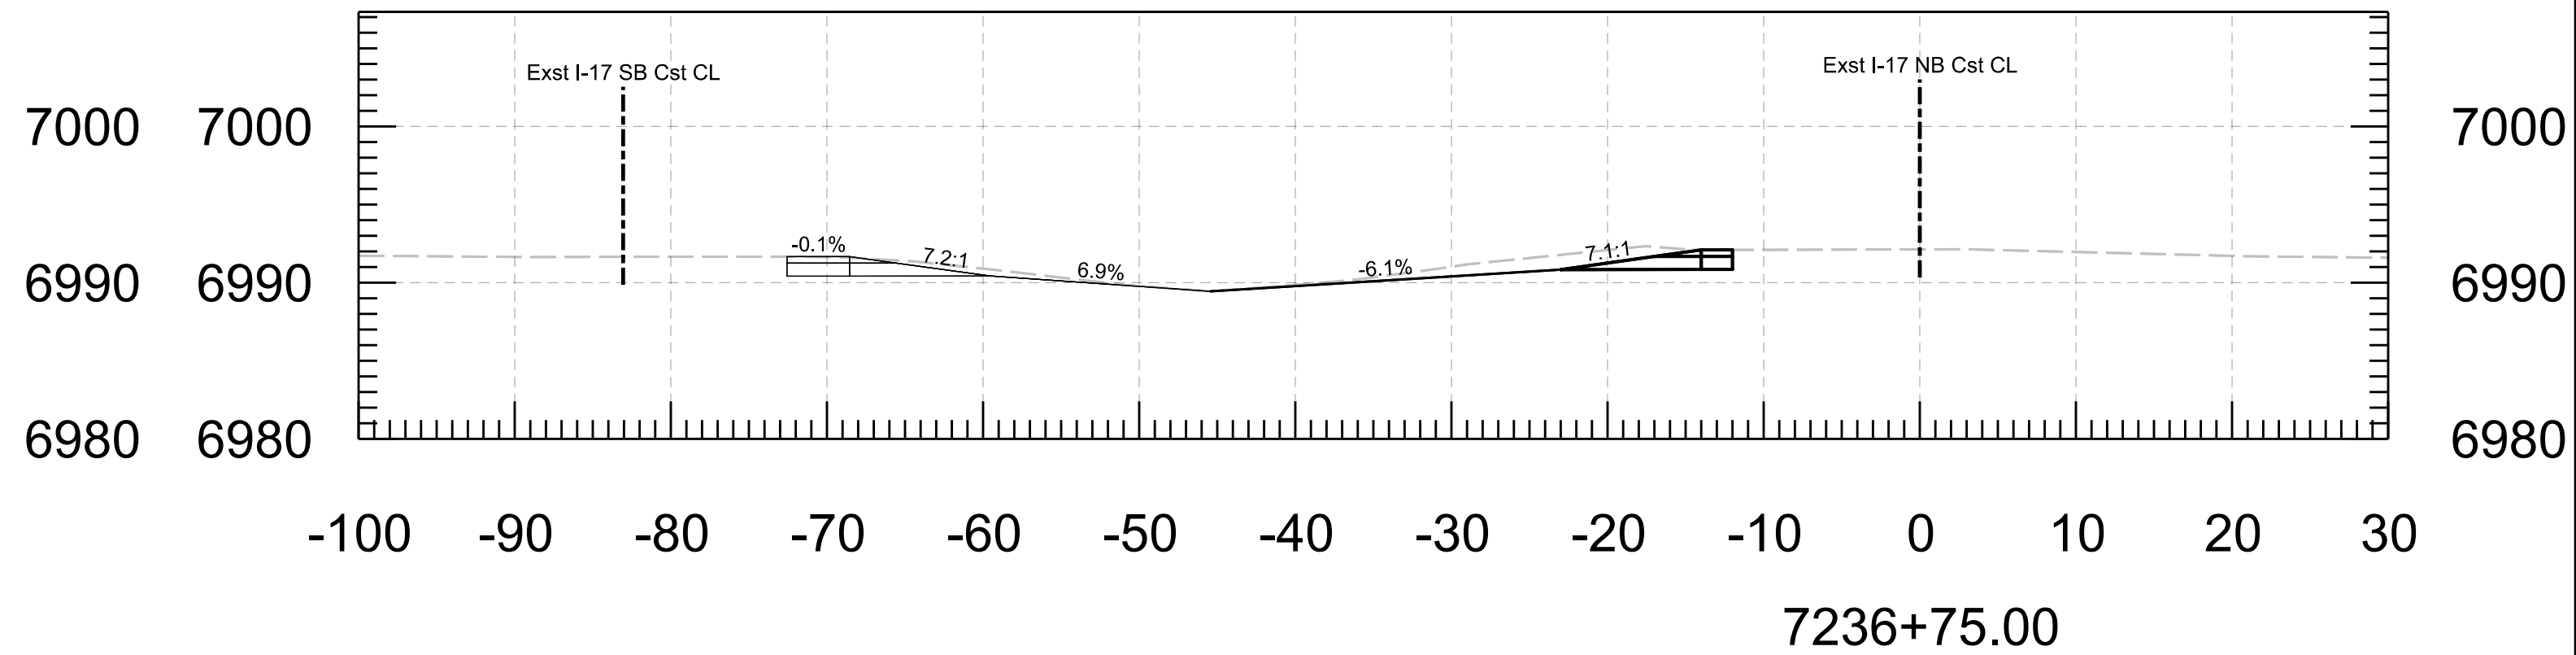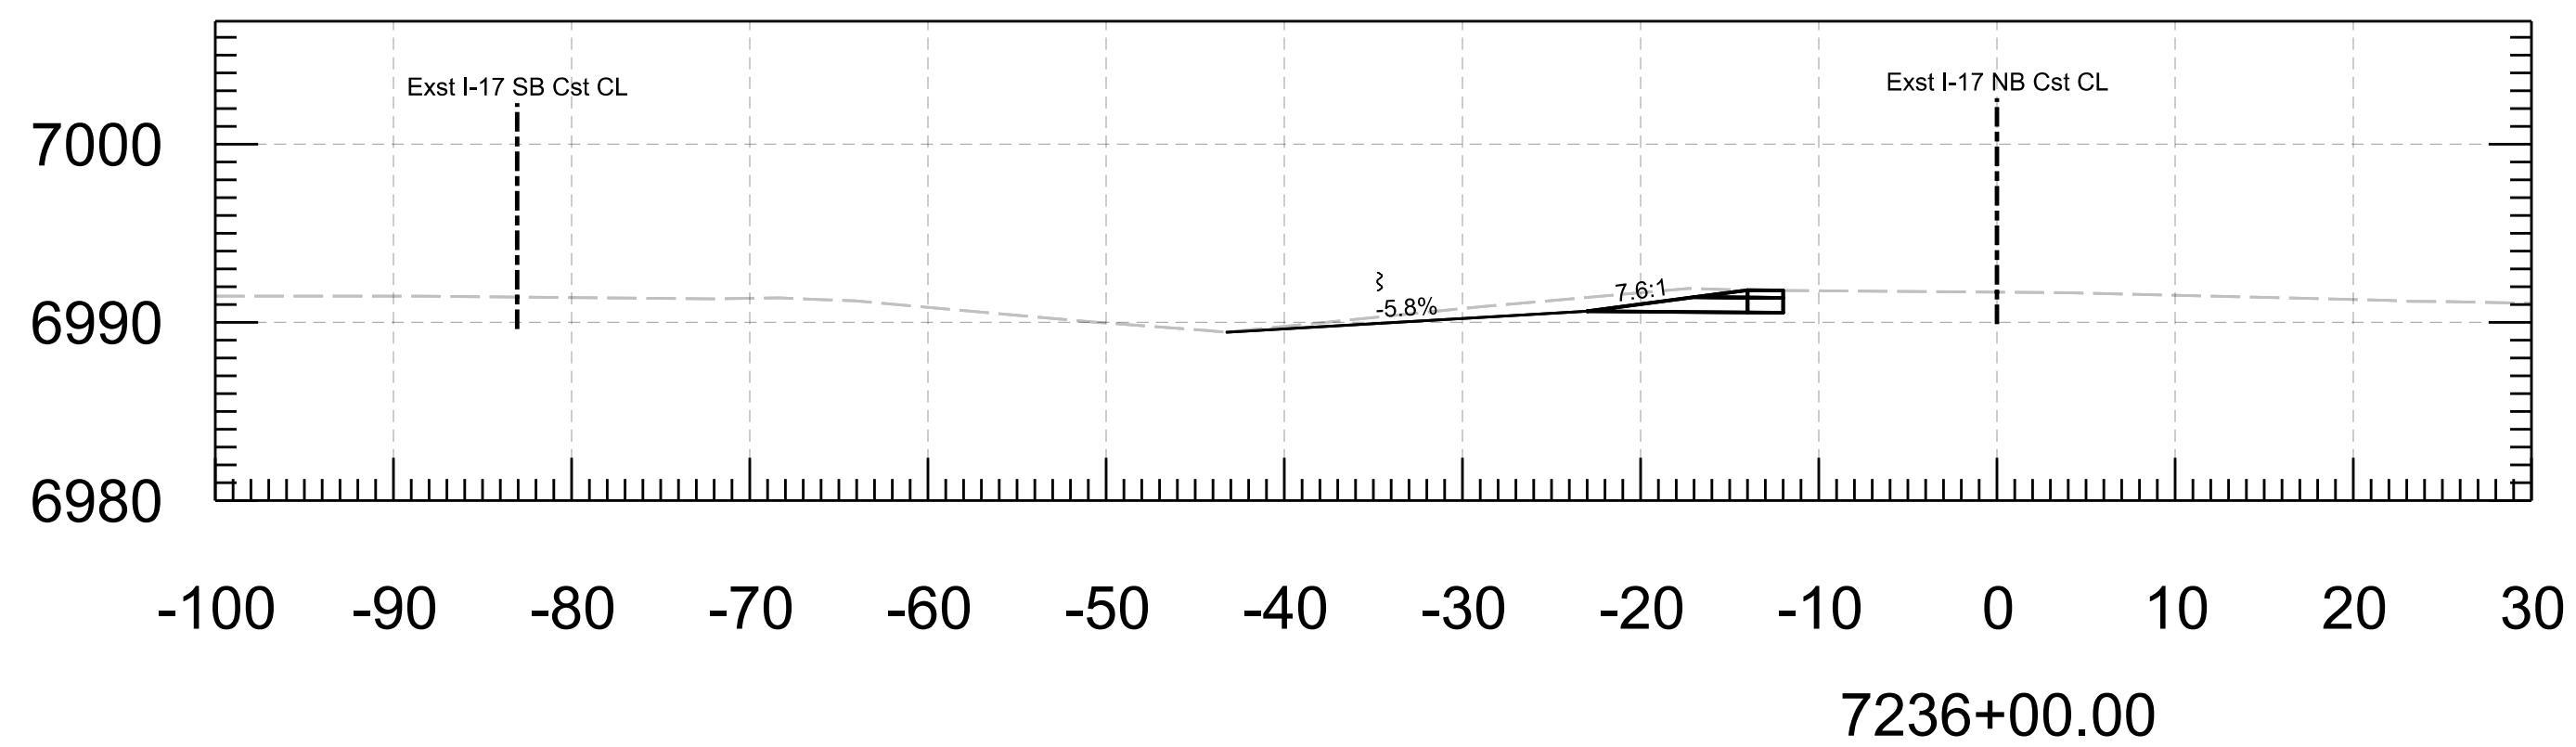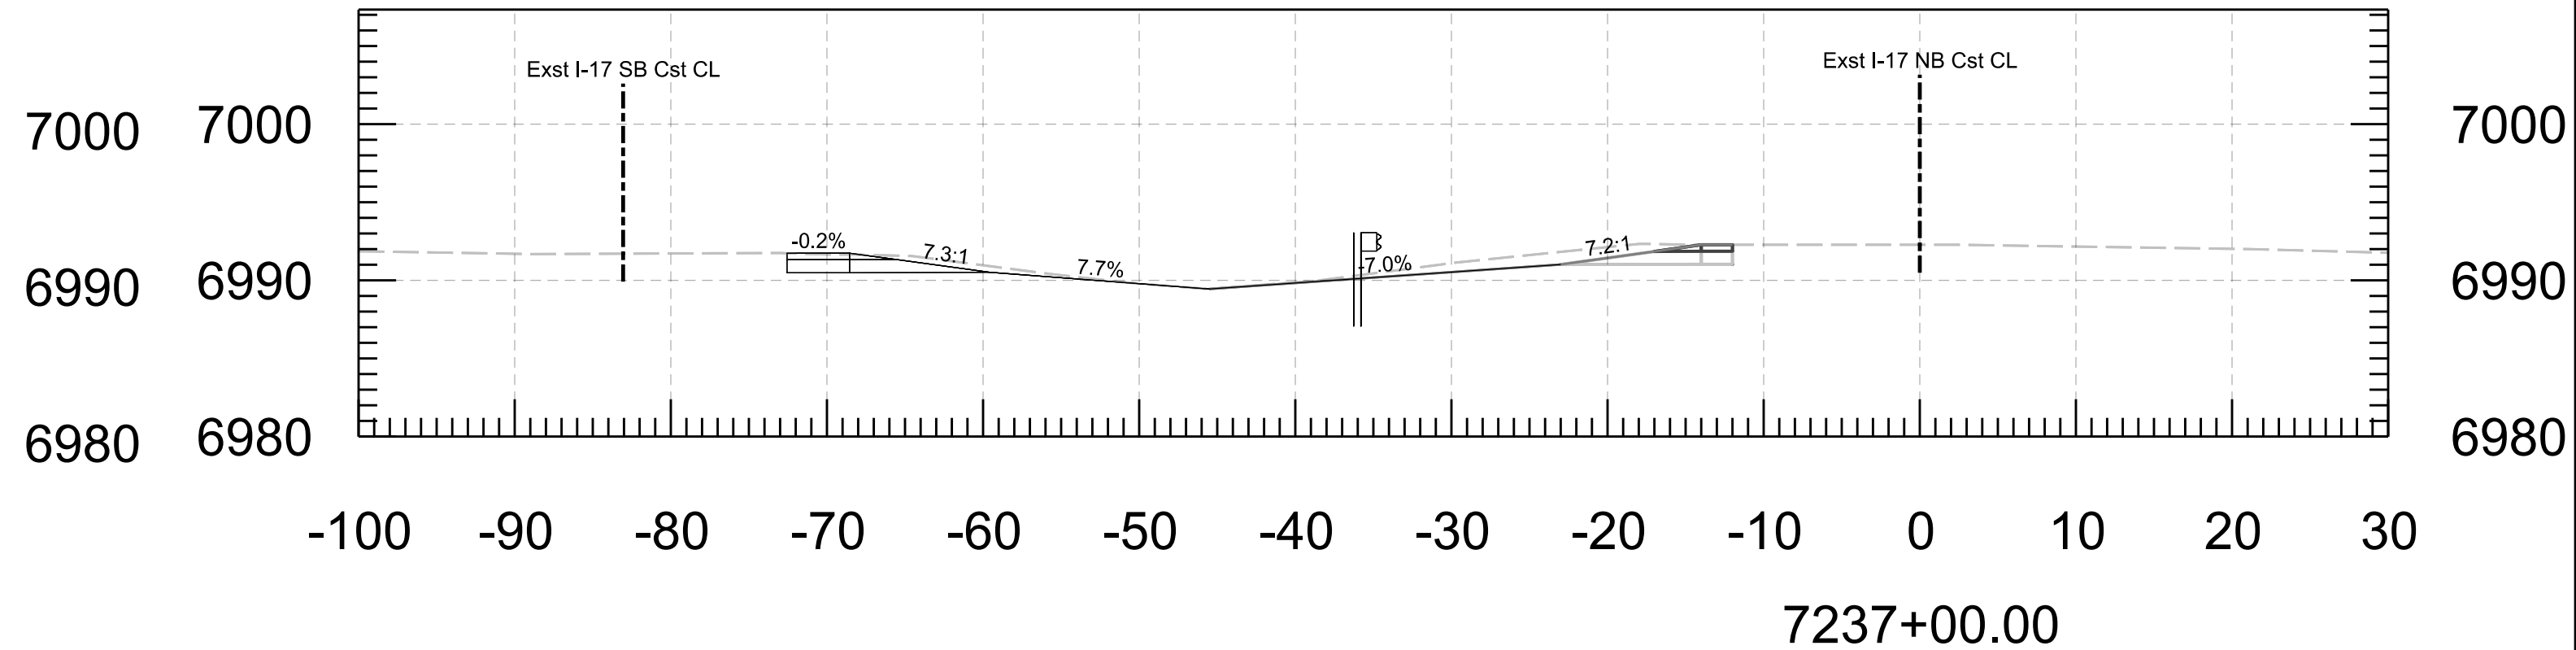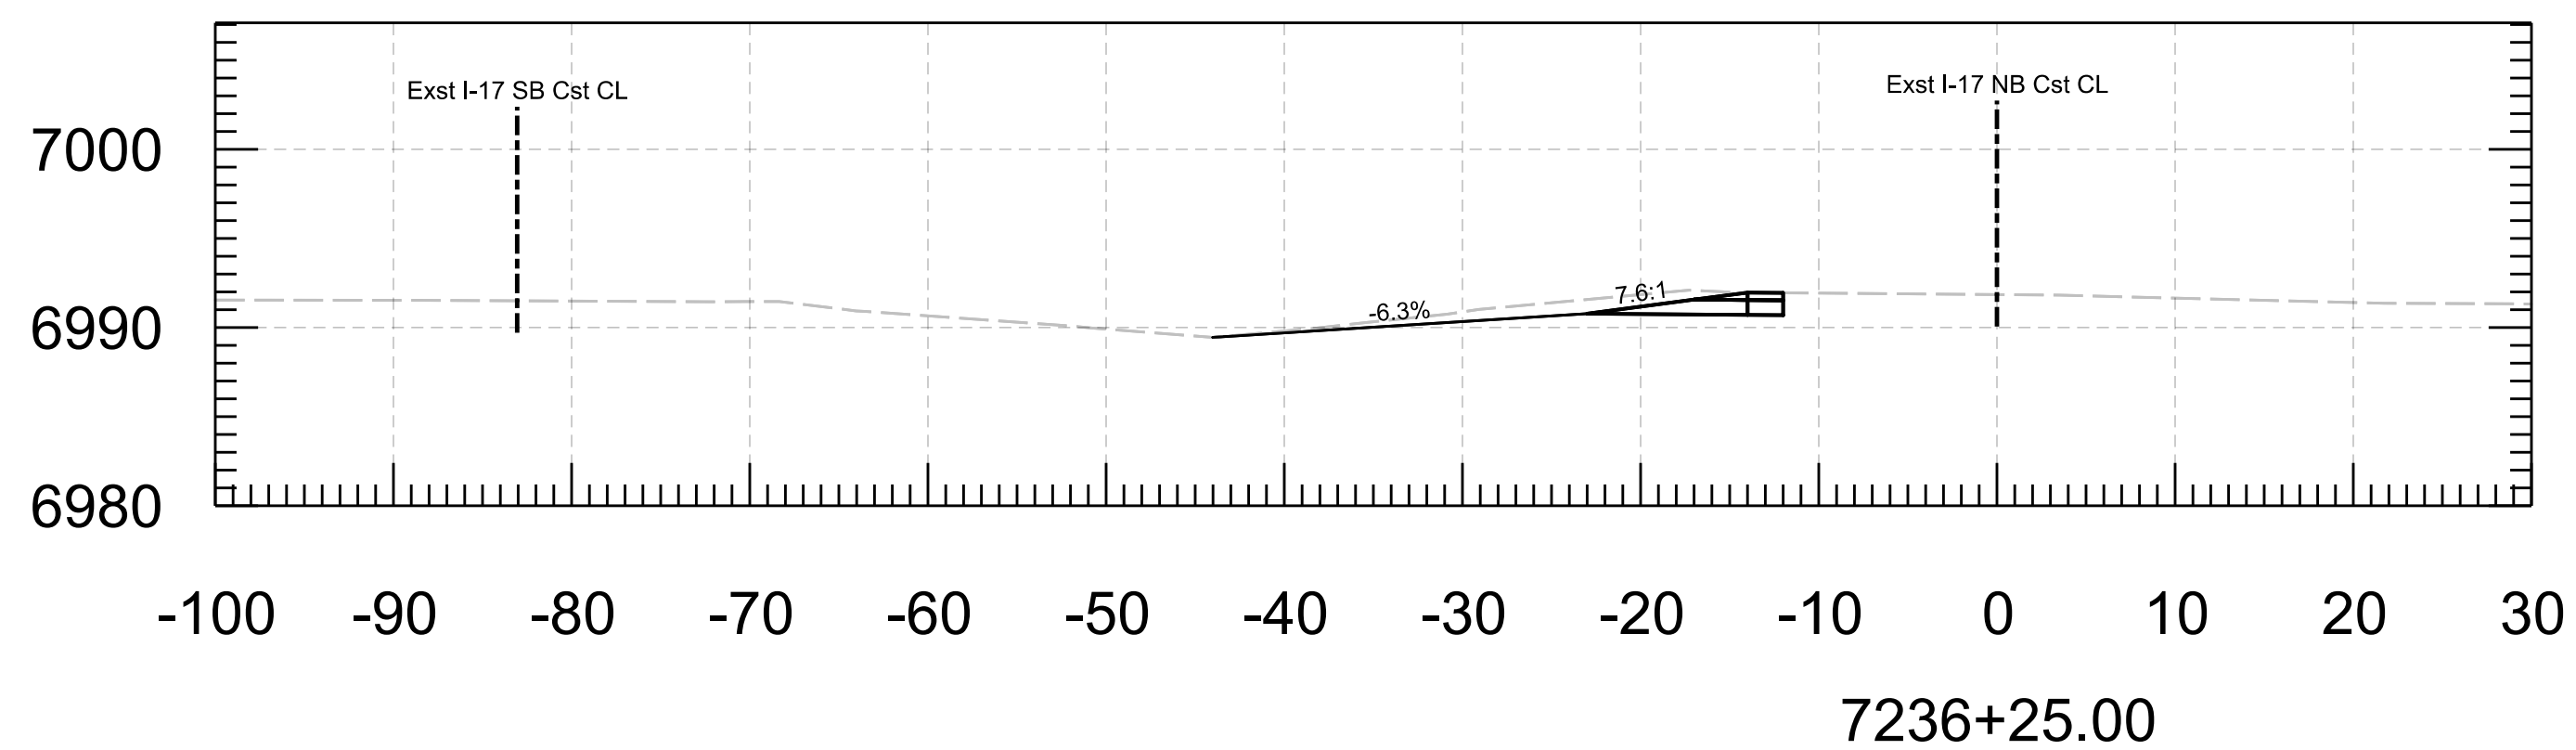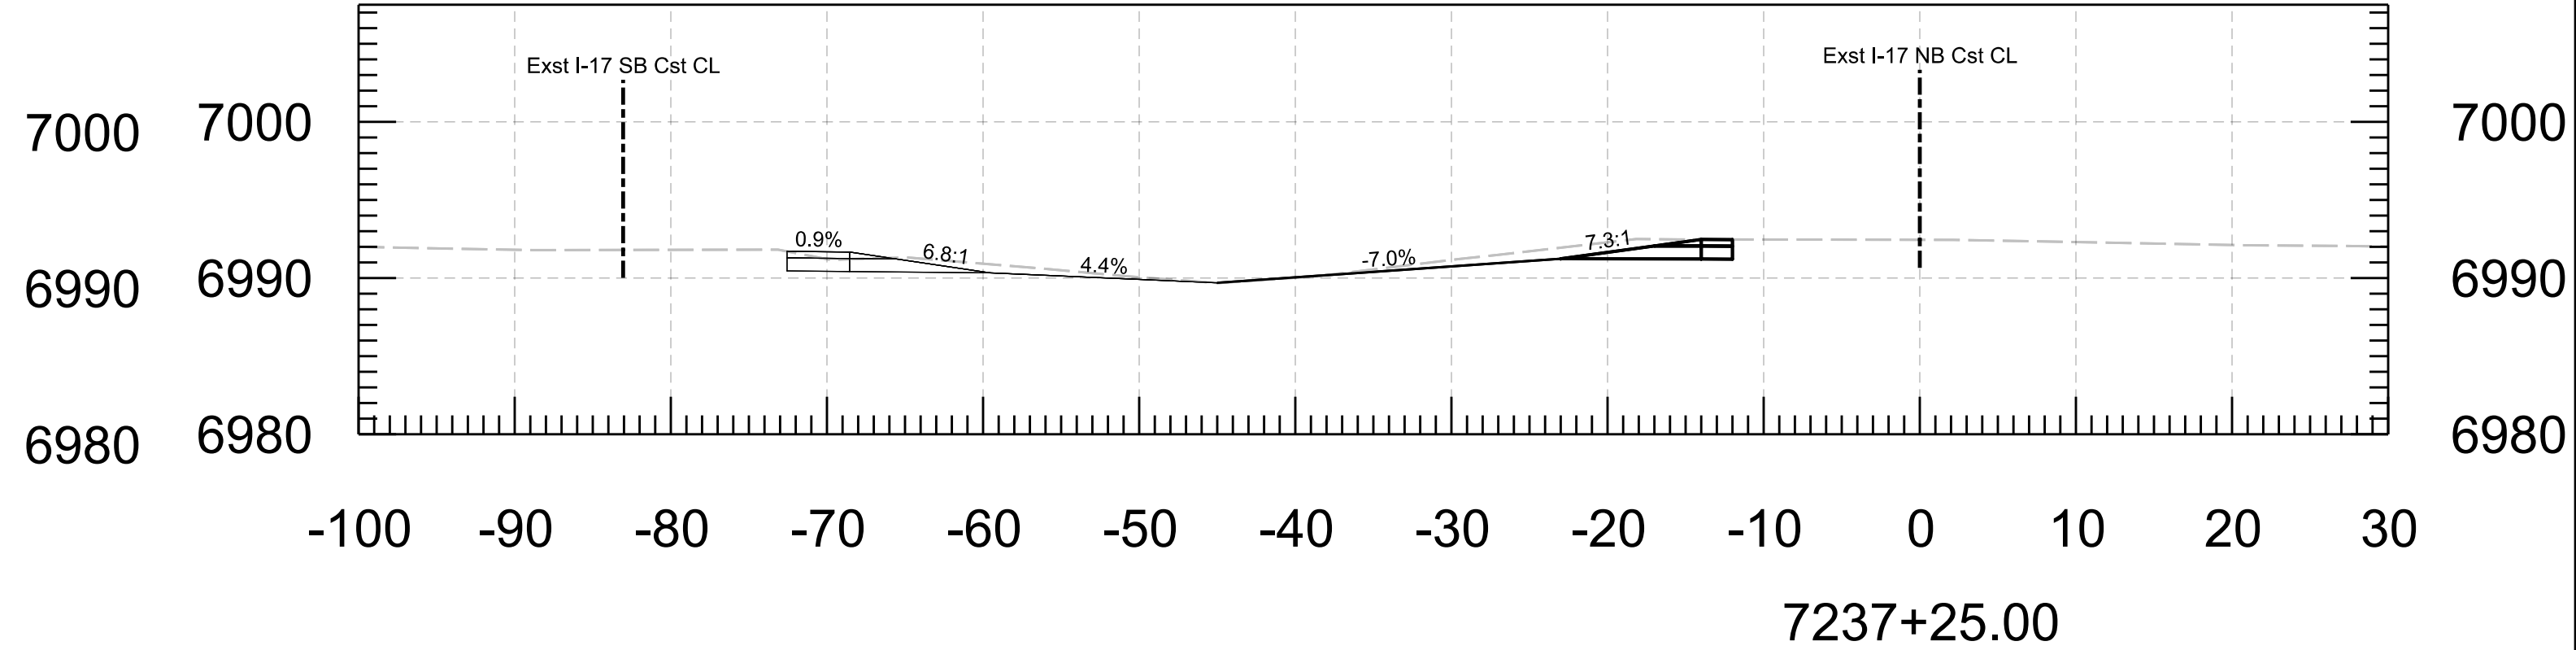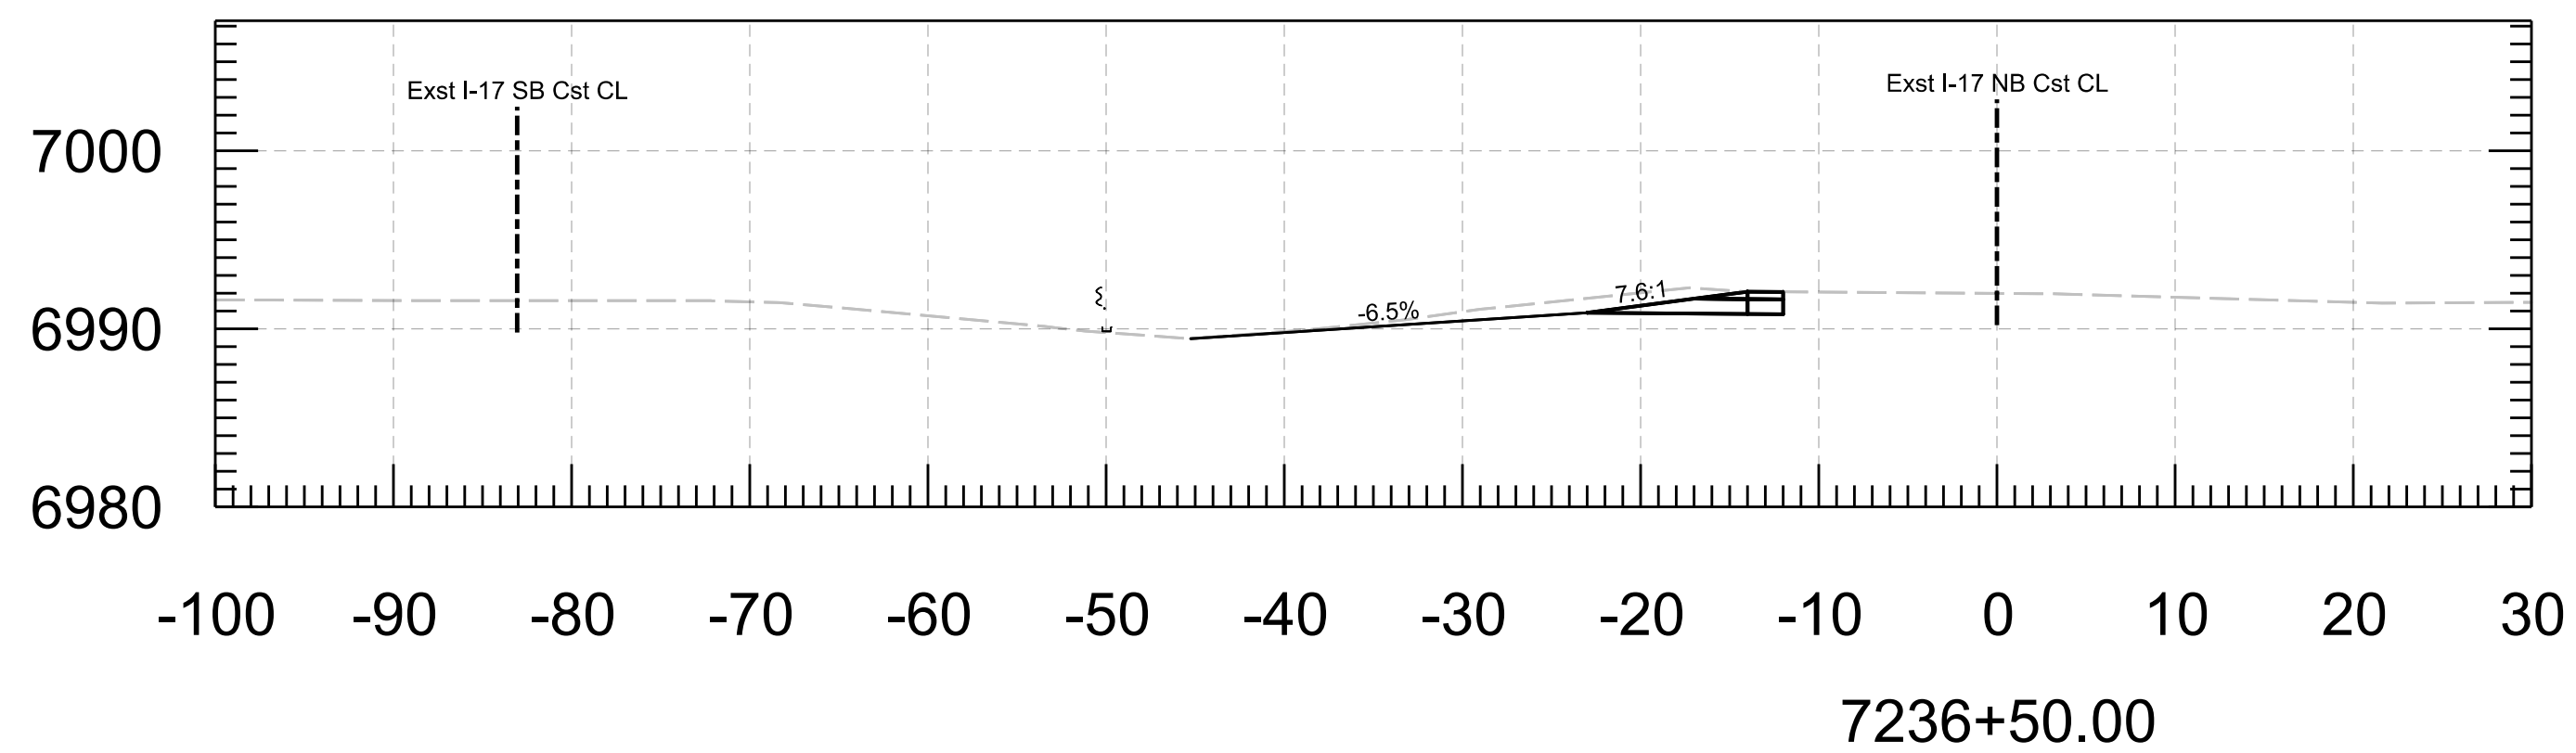


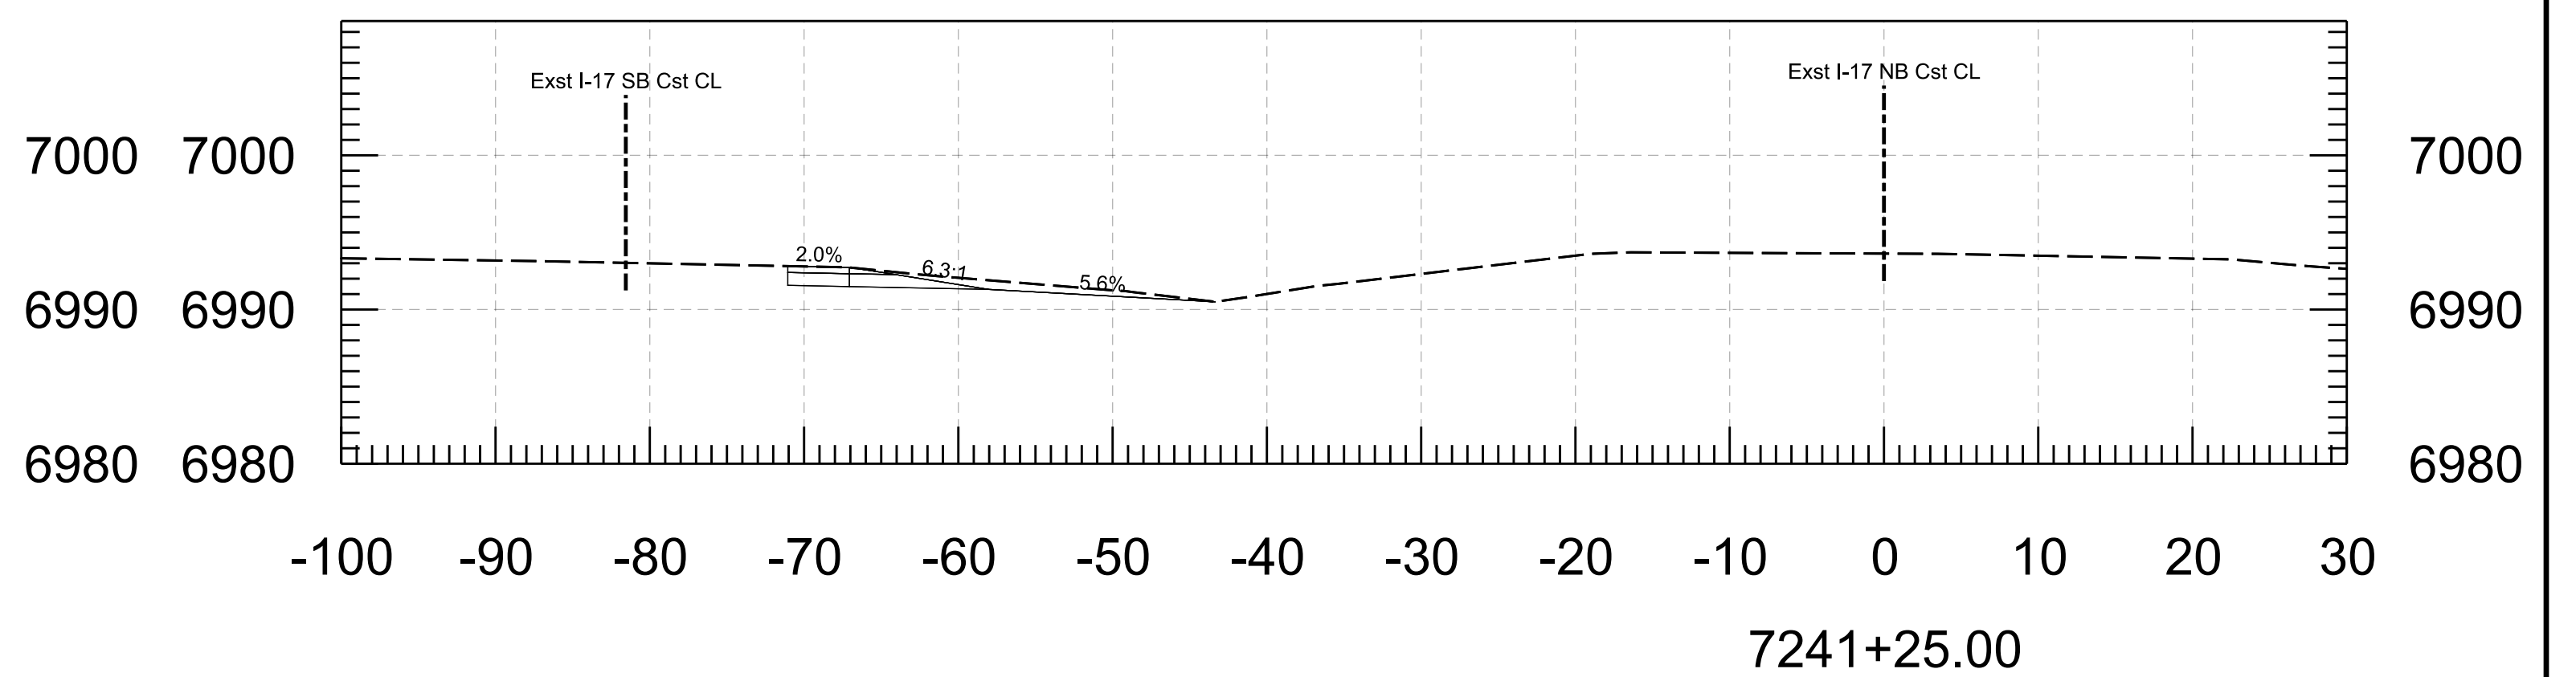
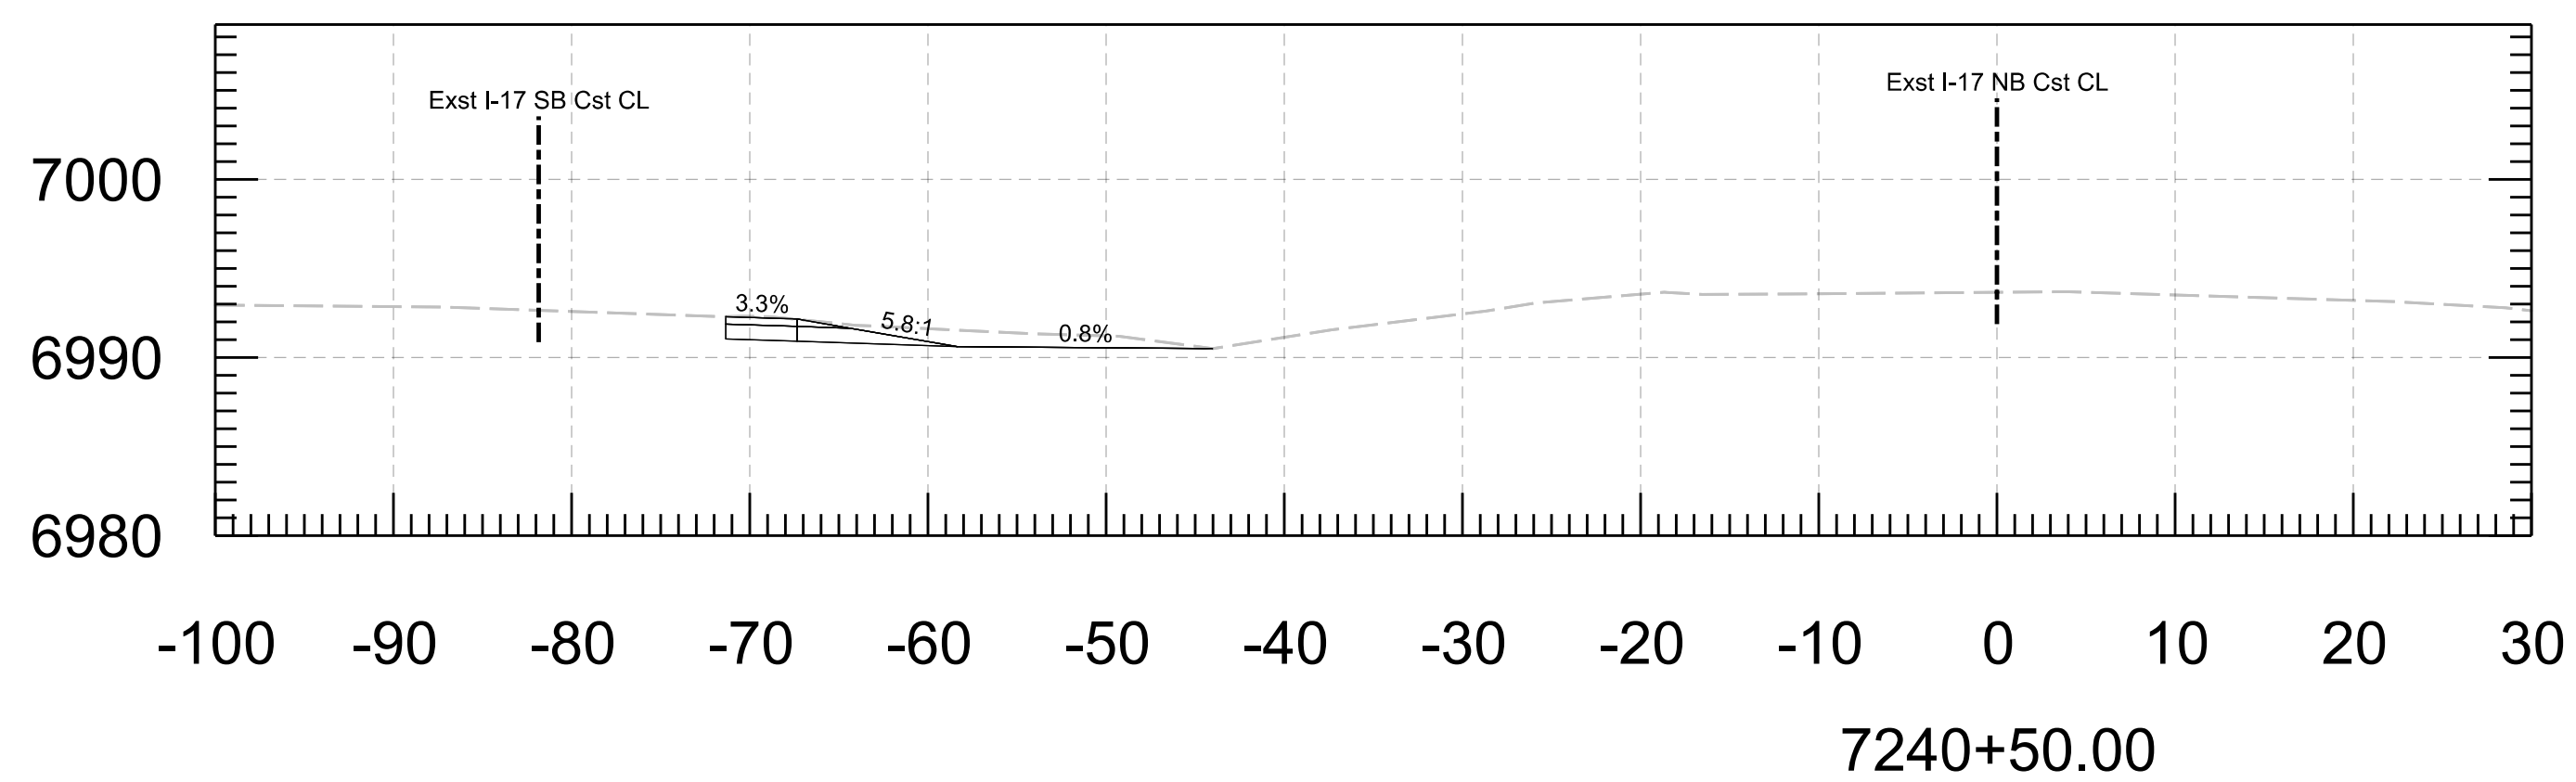
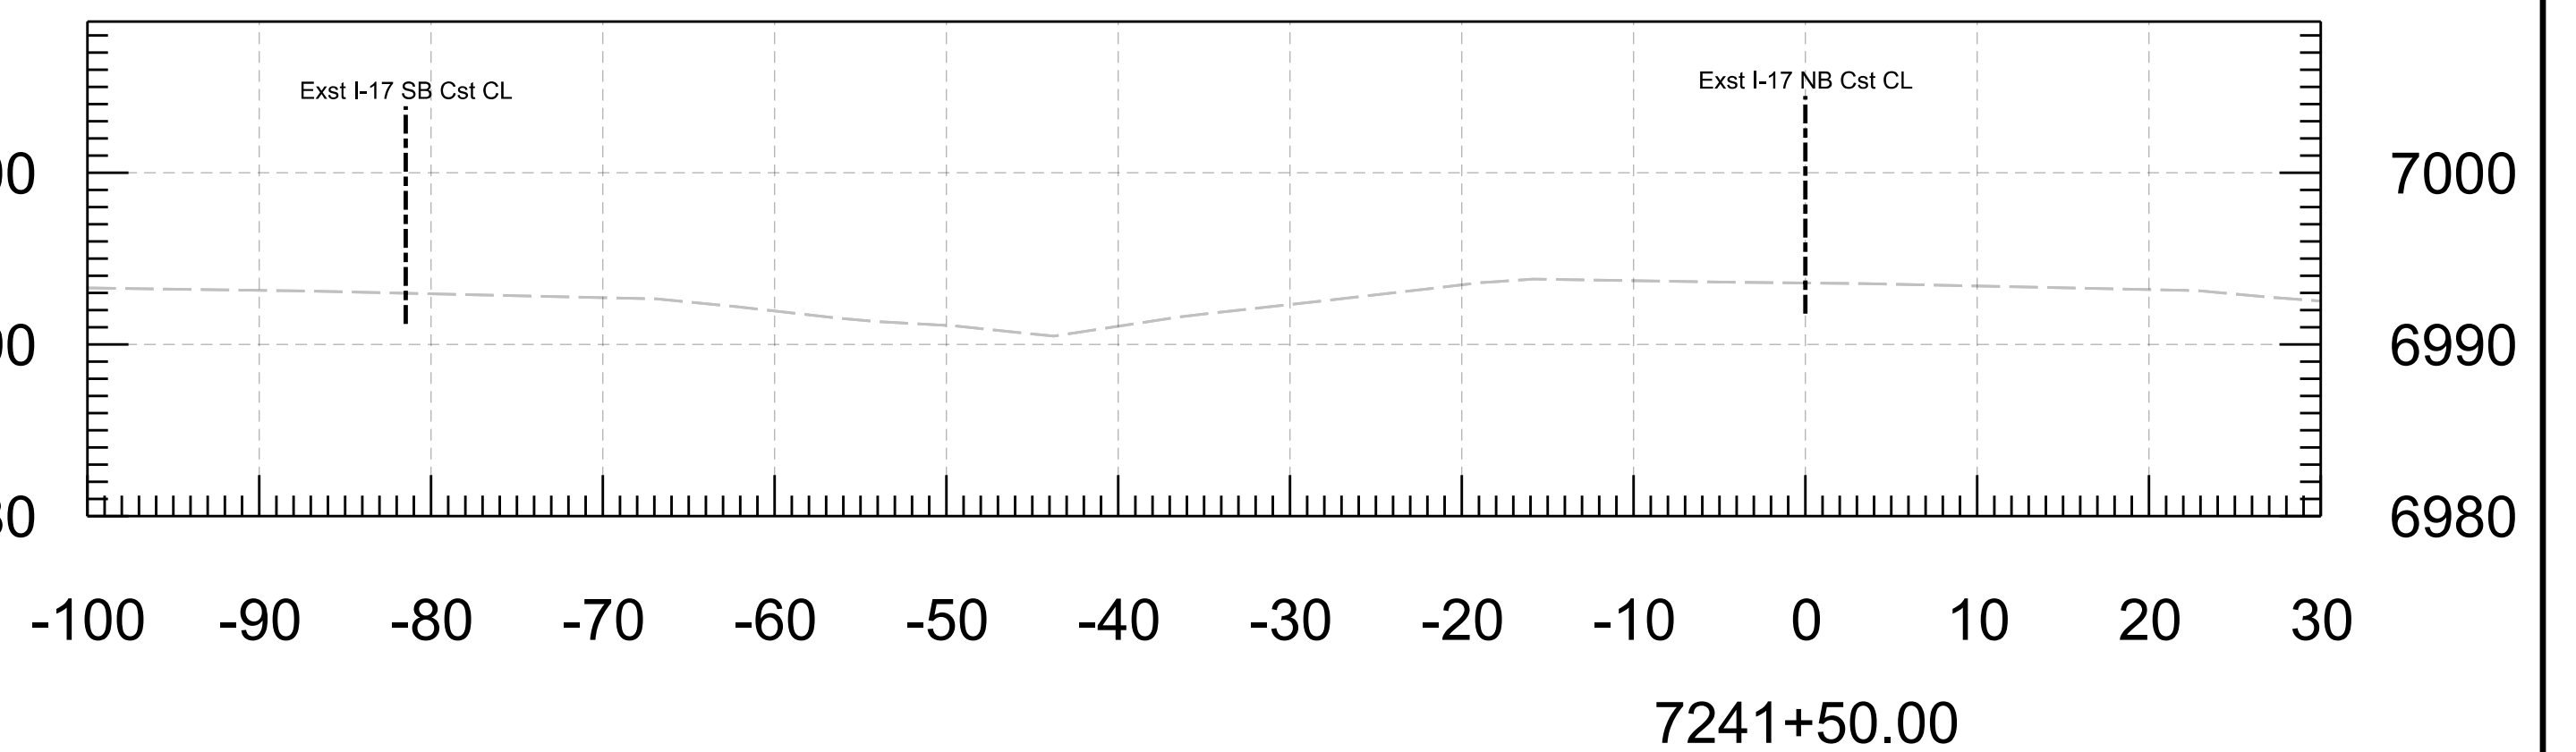
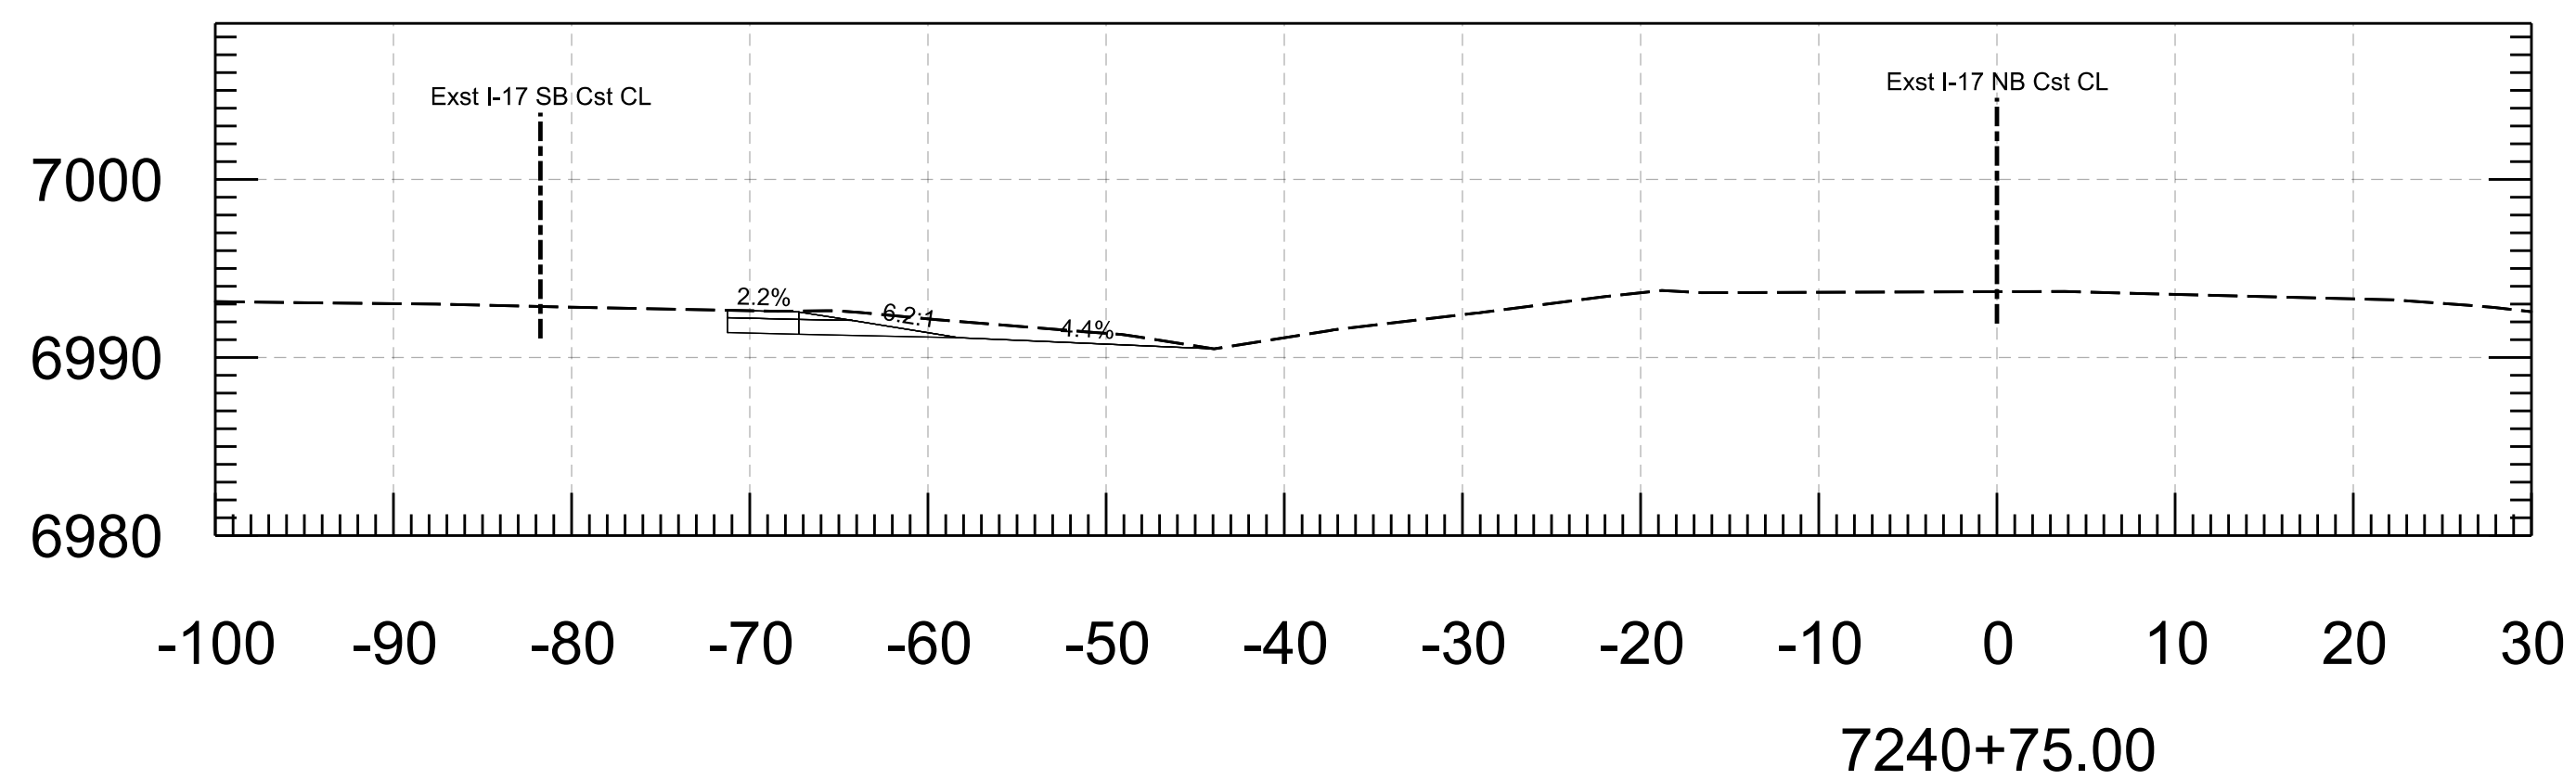
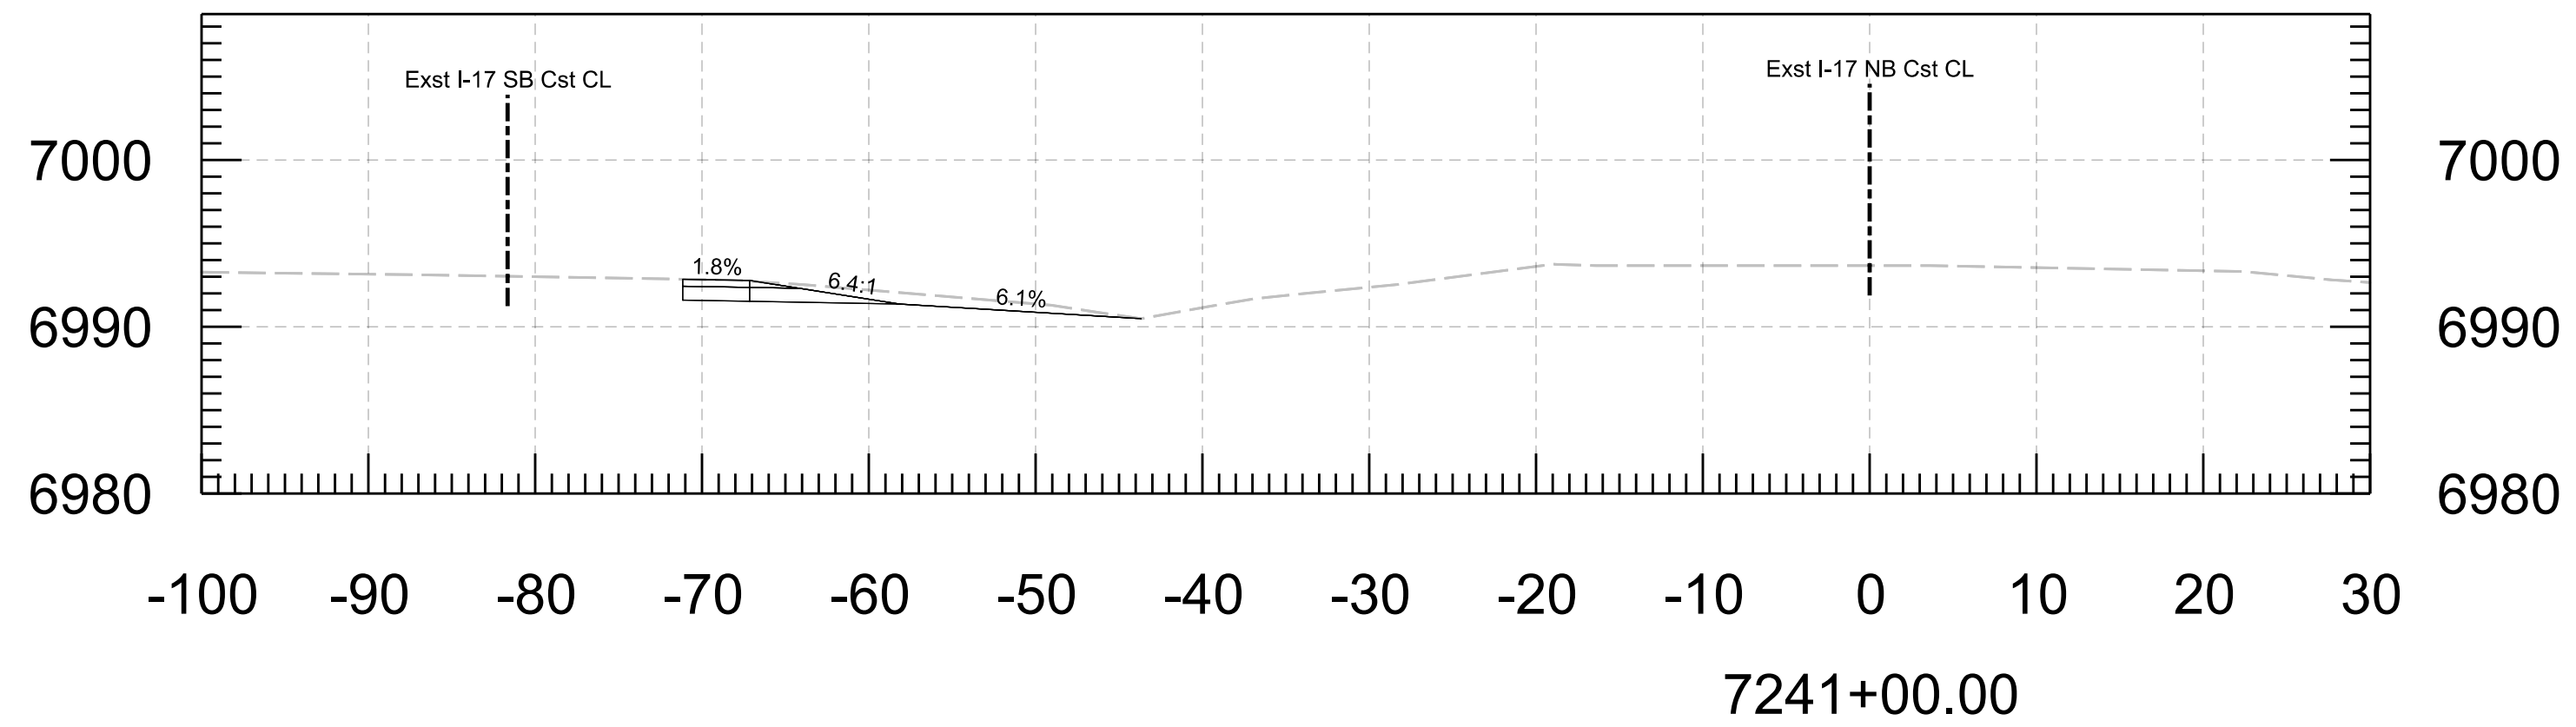
	<table border="1"> <tr><th>NAME</th><th>DATE</th></tr> <tr><td>J.NOYES</td><td>10/23</td></tr> <tr><td>J.NOYES</td><td>10/23</td></tr> <tr><td>L.BUSENBARK</td><td>10/23</td></tr> </table>	NAME	DATE	J.NOYES	10/23	J.NOYES	10/23	L.BUSENBARK	10/23	ARIZONA DEPARTMENT OF TRANSPORTATION INFRASTRUCTURE DELIVERY AND OPERATIONS DIVISION ROADWAY DESIGN SECTION	ROUTE I-17	F.H.W.A. Arizona Division STATE ARIZ.	PROJECT NO. 017 CN 337	FEDERAL ID NO. 017-B(237)T	SHEET NO. 4	TOTAL SHEETS 27	RECORD DRAWING
	NAME	DATE															
	J.NOYES	10/23															
J.NOYES	10/23																
L.BUSENBARK	10/23																
DESIGN DRAWN CHECKED	HDR, INC. 20 E. THOMAS ROAD SUITE 2500 PHOENIX, AZ 85012 TEL. (602) 522-7700	MILEPOST 337.39	LOCATION I-17 AIRPORT RD TI UP				DWG NO. ____ OF ____										
CROSS SECTIONS EXST I-17 NB		STRUCTURE NO.	TRACS NO. F0362 01C														





	DESIGN	J.NOYES	10/23	ARIZONA DEPARTMENT OF TRANSPORTATION INFRASTRUCTURE DELIVERY AND OPERATIONS DIVISION ROADWAY DESIGN SECTION	ROUTE	I-17	F.H.W.A. Arizona Division STATE ARIZ.	PROJECT NO.	017 CN 337	FEDERAL ID NO.	017-B(237)T	SHEET NO.	5	TOTAL SHEETS	27	RECORD DRAWING
	DRAWN	J.NOYES	10/23		MILEPOST	337.39		LOCATION	I-17 AIRPORT RD TI UP				DWG NO.	___ OF ___		
	CHECKED	L.BUSENBARK	10/23		STRUCTURE NO.			TRACS NO.	F0362 01C							
HDR, INC. 20 E. THOMAS ROAD SUITE 2500 PHOENIX, AZ 85012 TEL. (602) 522-7700				CROSS SECTIONS EXST I-17 NB												







	DESIGN	J.NOYES	10/23	ARIZONA DEPARTMENT OF TRANSPORTATION INFRASTRUCTURE DELIVERY AND OPERATIONS DIVISION ROADWAY DESIGN SECTION	ROUTE	I-17	F.H.W.A. Arizona Division STATE ARIZ.	PROJECT NO.	017 CN 337	FEDERAL ID NO.	017-B(237)T	SHEET NO.	6	TOTAL SHEETS	27	RECORD DRAWING
	DRAWN	J.NOYES	10/23		MILEPOST	337.39		LOCATION	I-17 AIRPORT RD TI UP				DWG NO.	___ OF ___		
	CHECKED	L.BUSENBARK	10/23		STRUCTURE NO.			TRACS NO.	F0362 01C							
HDR, INC. 20 E. THOMAS ROAD SUITE 2500 PHOENIX, AZ 85012 TEL: (602) 522-7700				CROSS SECTIONS EXST I-17 NB												



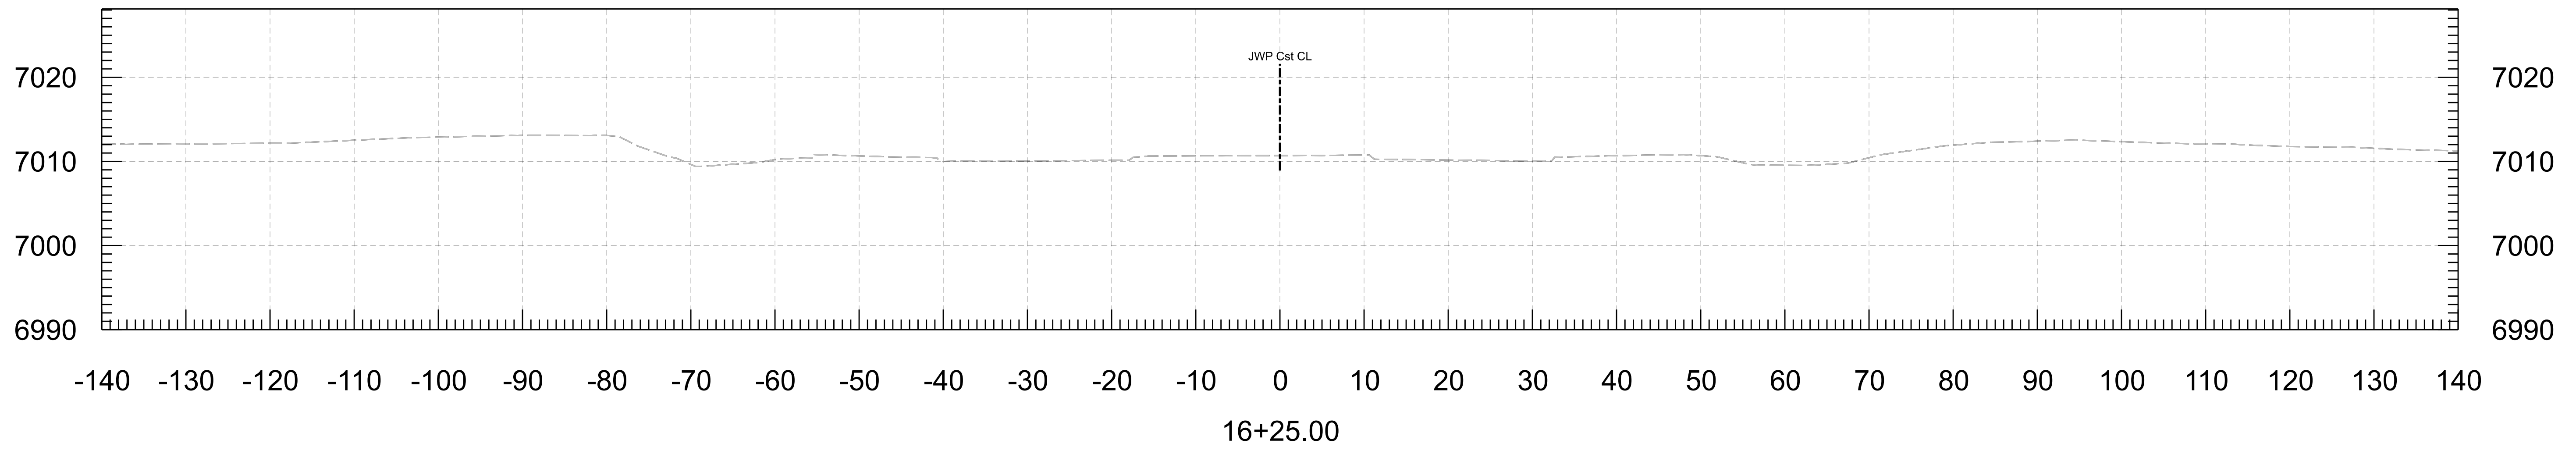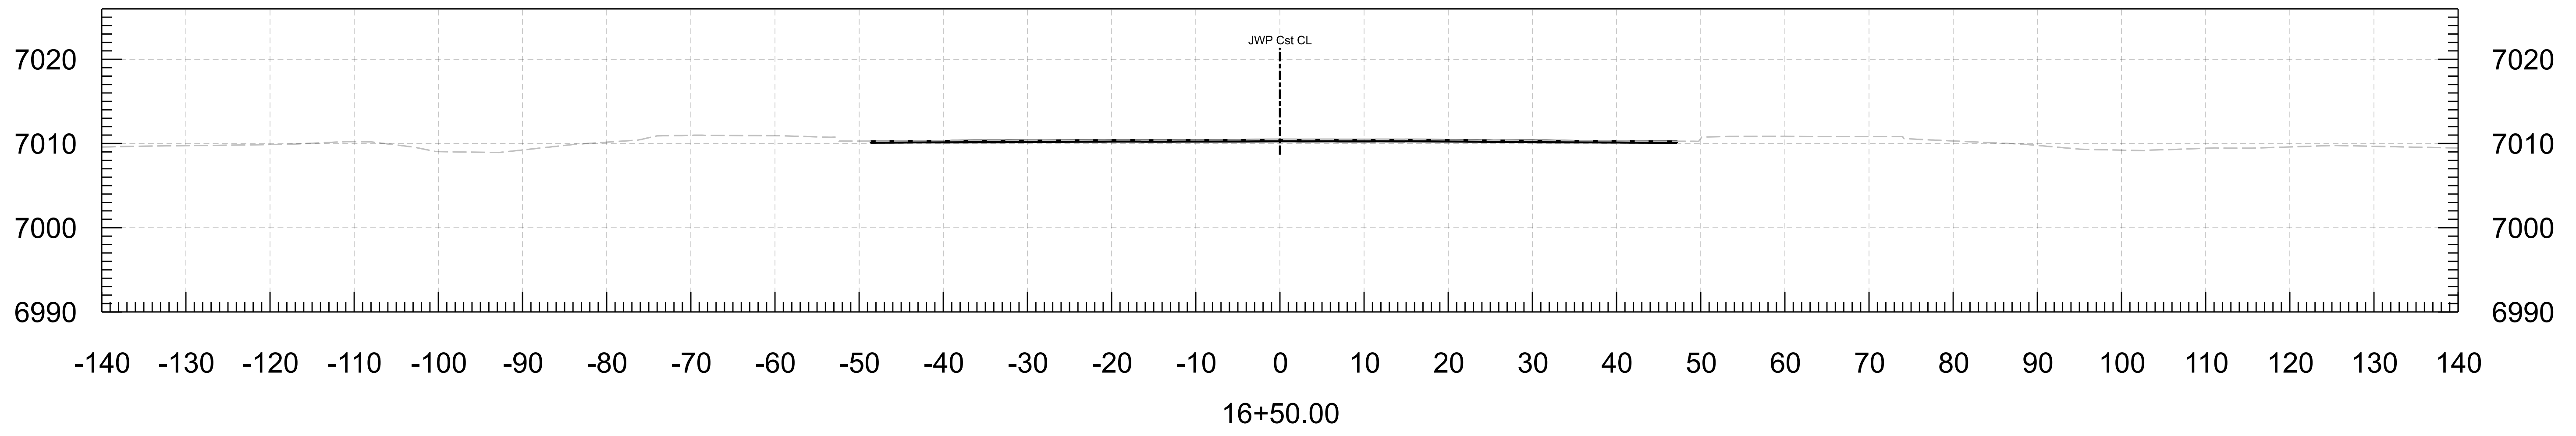



	DESIGN	J.NOYES	10/23	ARIZONA DEPARTMENT OF TRANSPORTATION INFRASTRUCTURE DELIVERY AND OPERATIONS DIVISION ROADWAY DESIGN SECTION	ROUTE	I-17	F.H.W.A. Arizona Division STATE ARIZ.	PROJECT NO.	017 CN 337	FEDERAL ID NO.	017-B(237)T	SHEET NO.	7	TOTAL SHEETS	27	RECORD DRAWING
	DRAWN	J.NOYES	10/23		MILEPOST	337.39		LOCATION	I-17 AIRPORT RD TI UP				DWG NO.	___ OF ___		
	CHECKED	L.BUSENBARK	10/23		STRUCTURE NO.			TRACS NO.	F0362 01C							
				CROSS SECTIONS EXST I-17 NB												



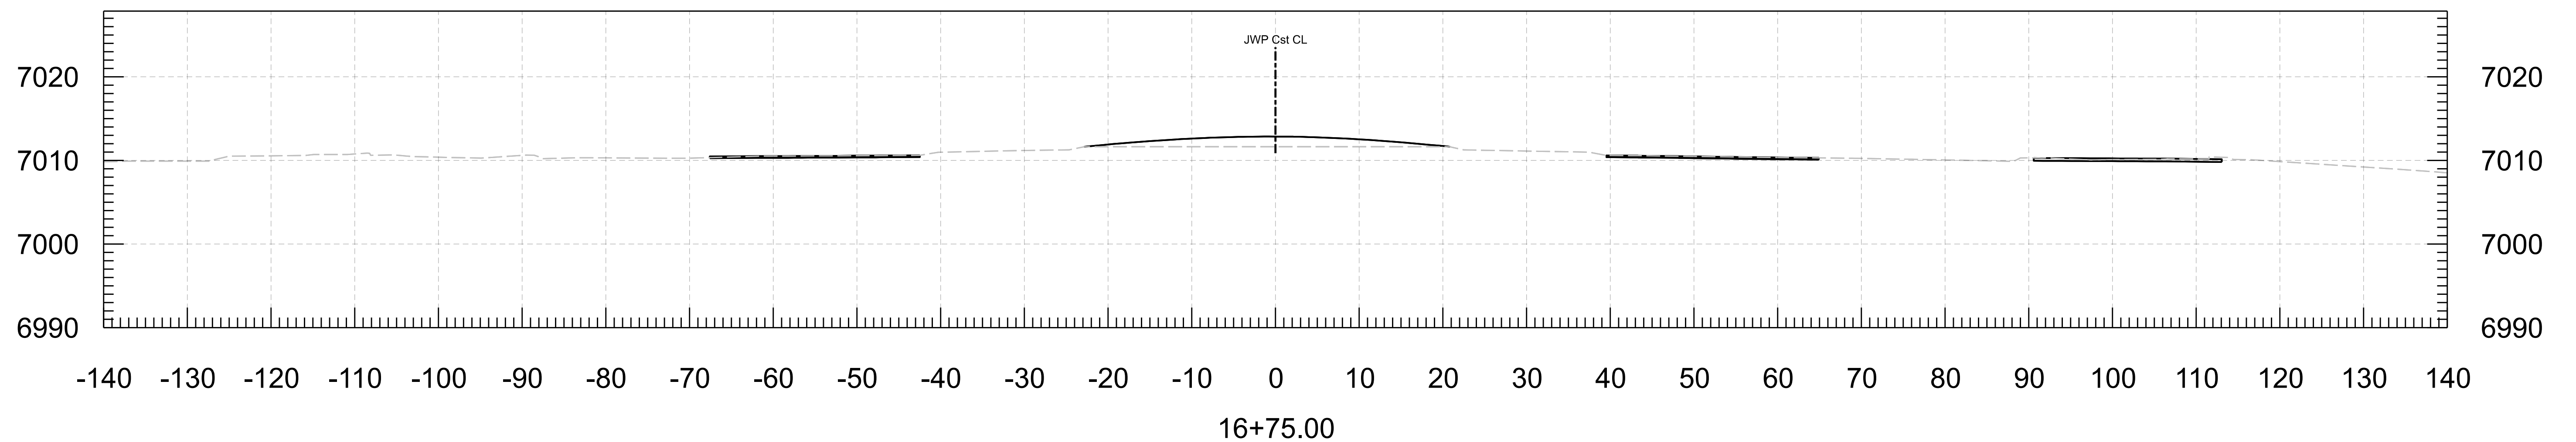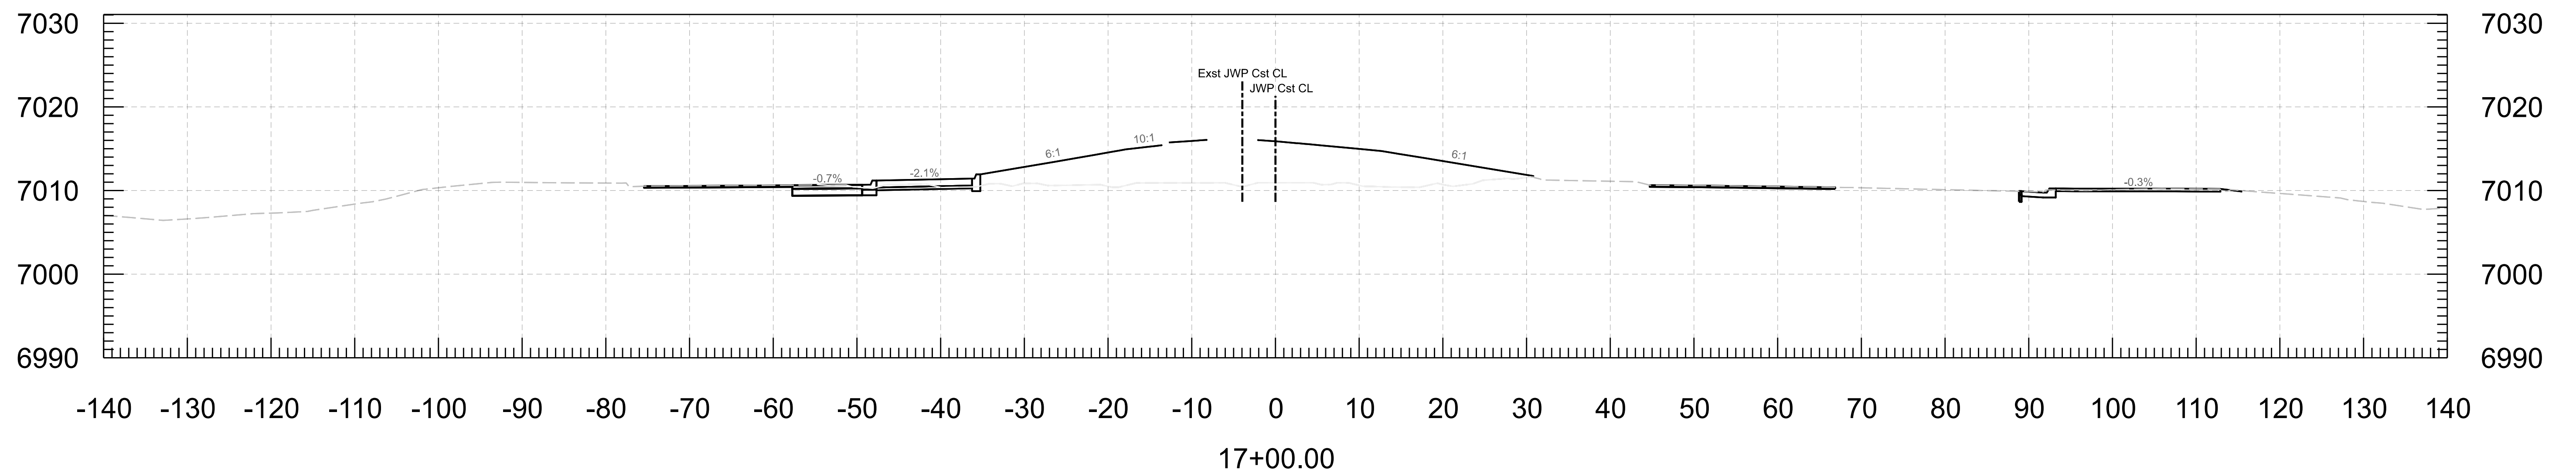



		<table border="1" style="font-size: 8px;"> <tr><th>NAME</th><th>DATE</th></tr> <tr><td>J.NOYES</td><td>10/23</td></tr> <tr><td>J.NOYES</td><td>10/23</td></tr> <tr><td>L.BUSENBARK</td><td>10/23</td></tr> </table>	NAME	DATE	J.NOYES	10/23	J.NOYES	10/23	L.BUSENBARK	10/23	ARIZONA DEPARTMENT OF TRANSPORTATION INFRASTRUCTURE DELIVERY AND OPERATIONS DIVISION ROADWAY DESIGN SECTION	ROUTE I-17	F.H.W.A. Arizona Division	STATE ARIZ.	PROJECT NO. 017 CN 337	FEDERAL ID NO. 017-B(237)T	SHEET NO. 8	TOTAL SHEETS 27	RECORD DRAWING
	NAME	DATE																	
	J.NOYES	10/23																	
J.NOYES	10/23																		
L.BUSENBARK	10/23																		
	HDR, INC. 20 E. THOMAS ROAD SUITE 2500 PHOENIX, AZ 85012 TEL. (602) 522-7700		CROSS SECTIONS JW POWELL BLVD	MILEPOST 337.39	LOCATION I-17 AIRPORT RD TI UP				DWG NO. ____ OF ____										
				STRUCTURE NO.	TRACS NO. F0362 01C														



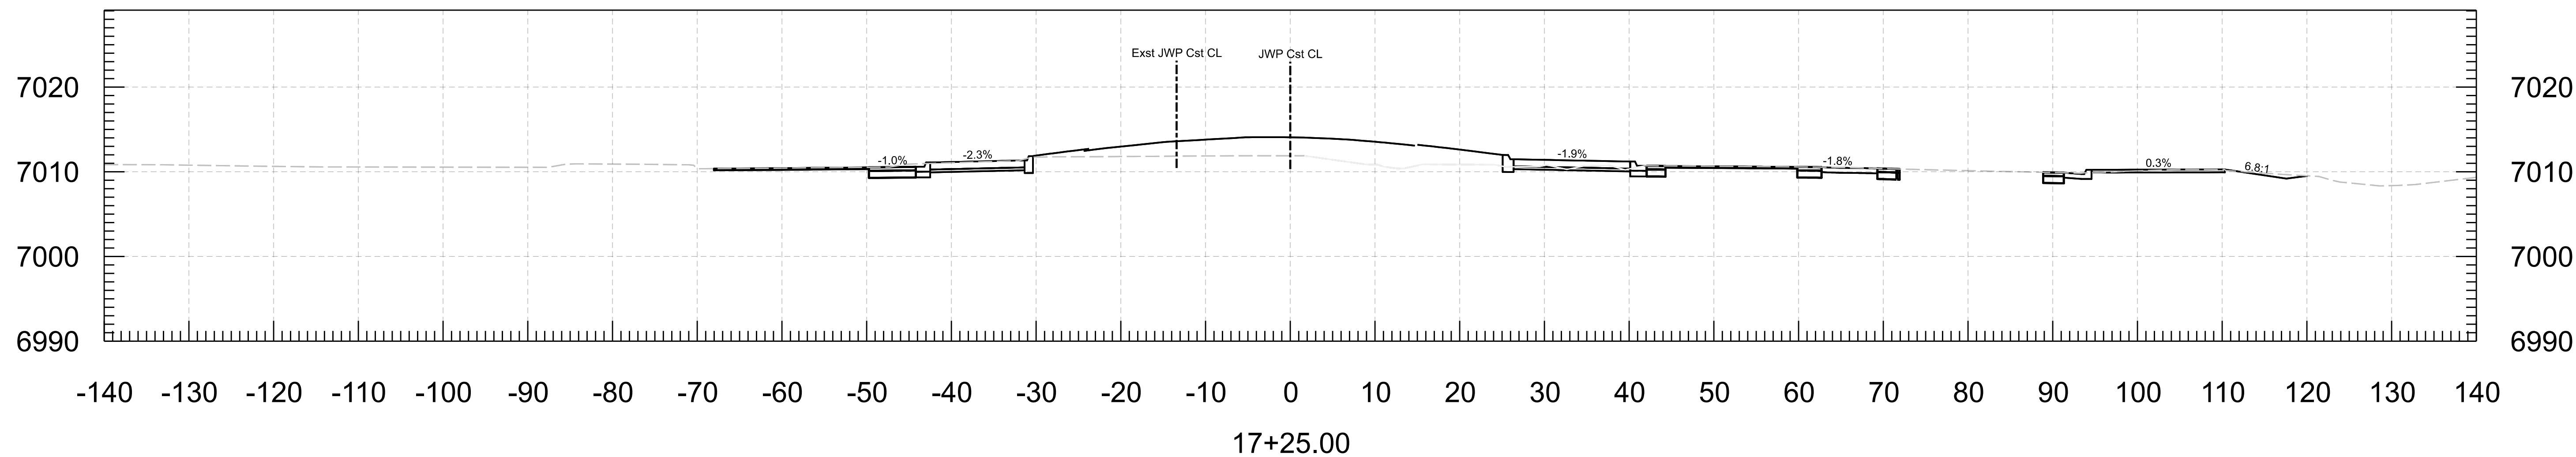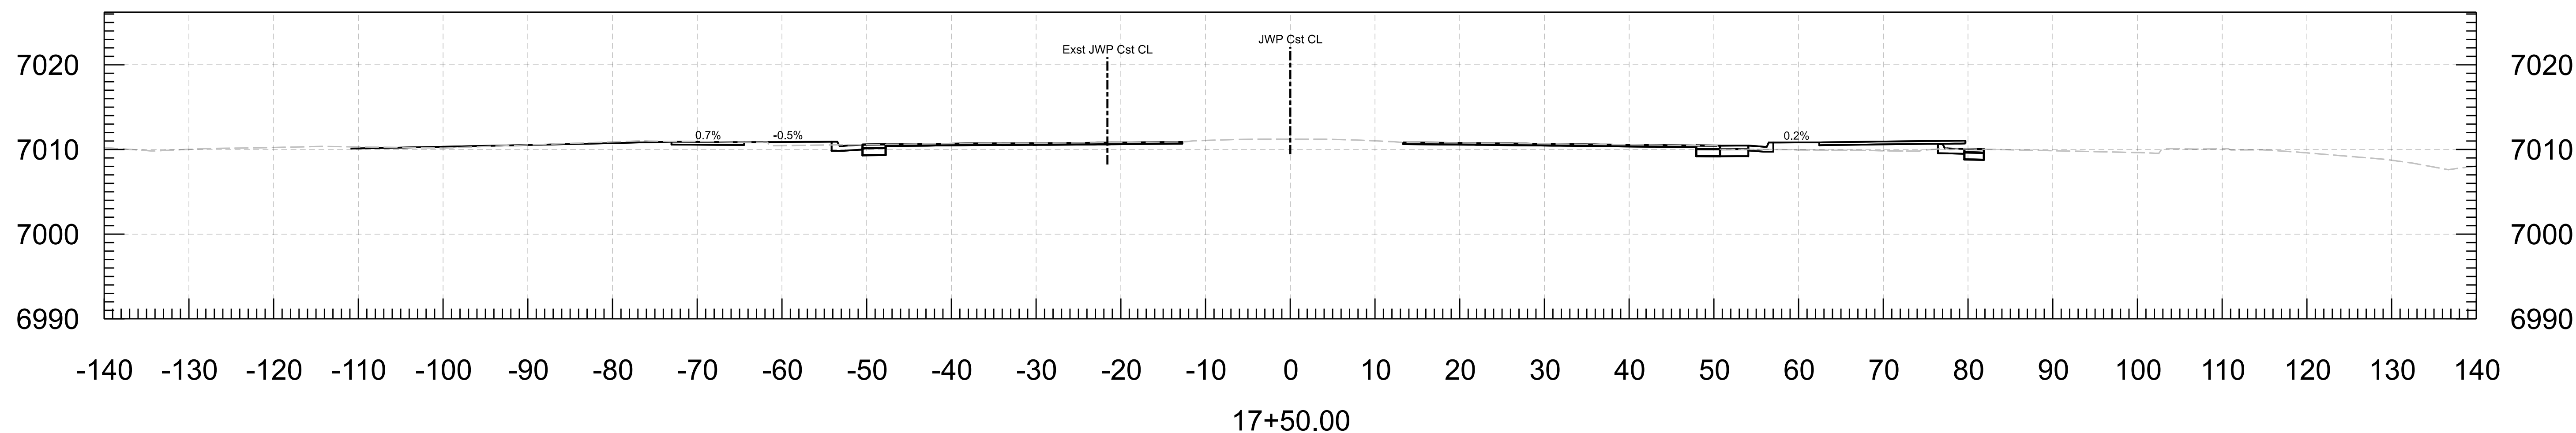



	DESIGN	J.NOYES	10/23	ARIZONA DEPARTMENT OF TRANSPORTATION INFRASTRUCTURE DELIVERY AND OPERATIONS DIVISION ROADWAY DESIGN SECTION	ROUTE	I-17	F.H.W.A. Arizona Division STATE ARIZ.	PROJECT NO.	017 CN 337	FEDERAL ID NO.	017-B(237)T	SHEET NO.	9	TOTAL SHEETS	27	RECORD DRAWING
	DRAWN	J.NOYES	10/23		MILEPOST	337.39		LOCATION	I-17 AIRPORT RD TI UP				DWG NO.	___ OF ___		
	CHECKED	L.BUSENBARK	10/23		STRUCTURE NO.			TRACS NO.	F0362 01C							
 HDR, INC. 20 E. THOMAS ROAD SUITE 2500 PHOENIX, AZ 85012 TEL (602) 522-7700				CROSS SECTIONS JW POWELL BLVD												

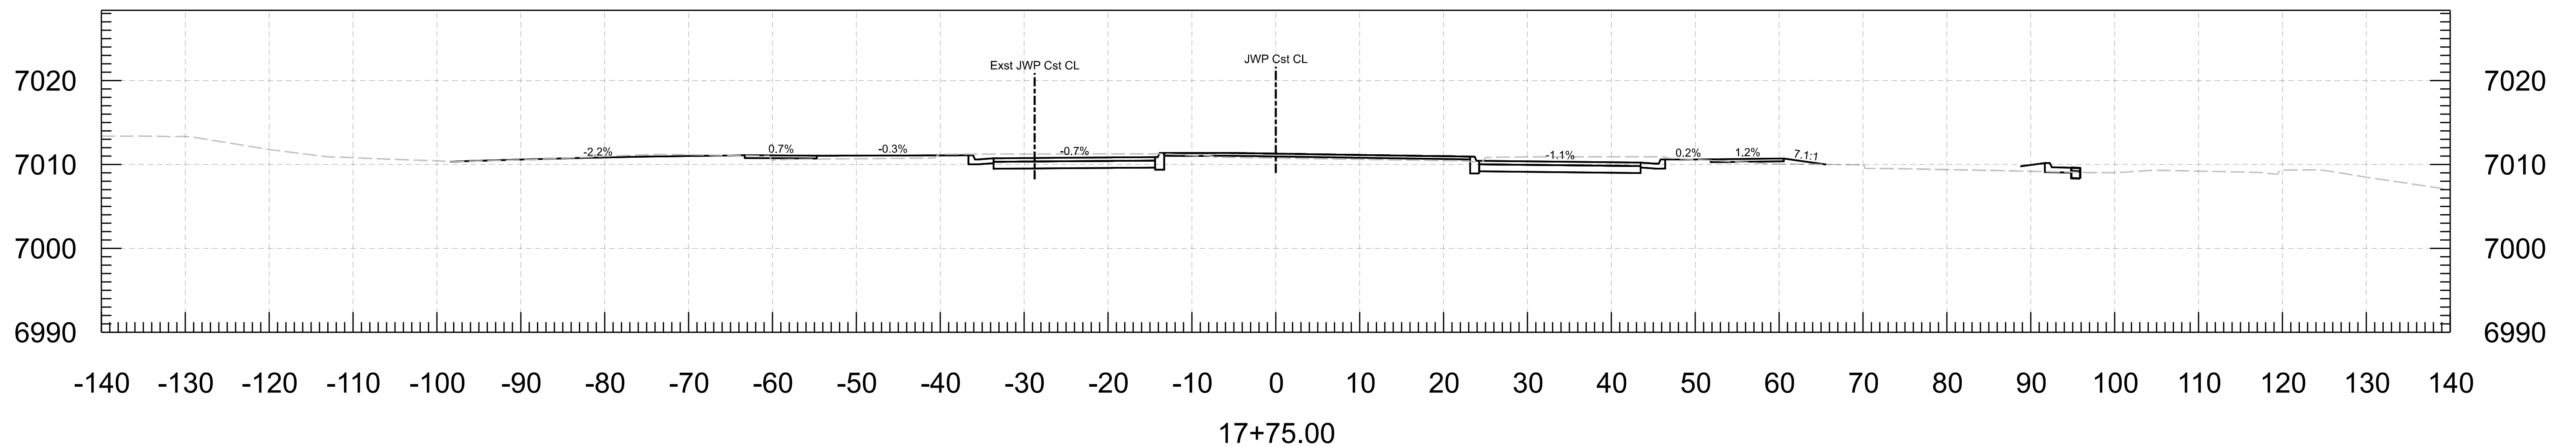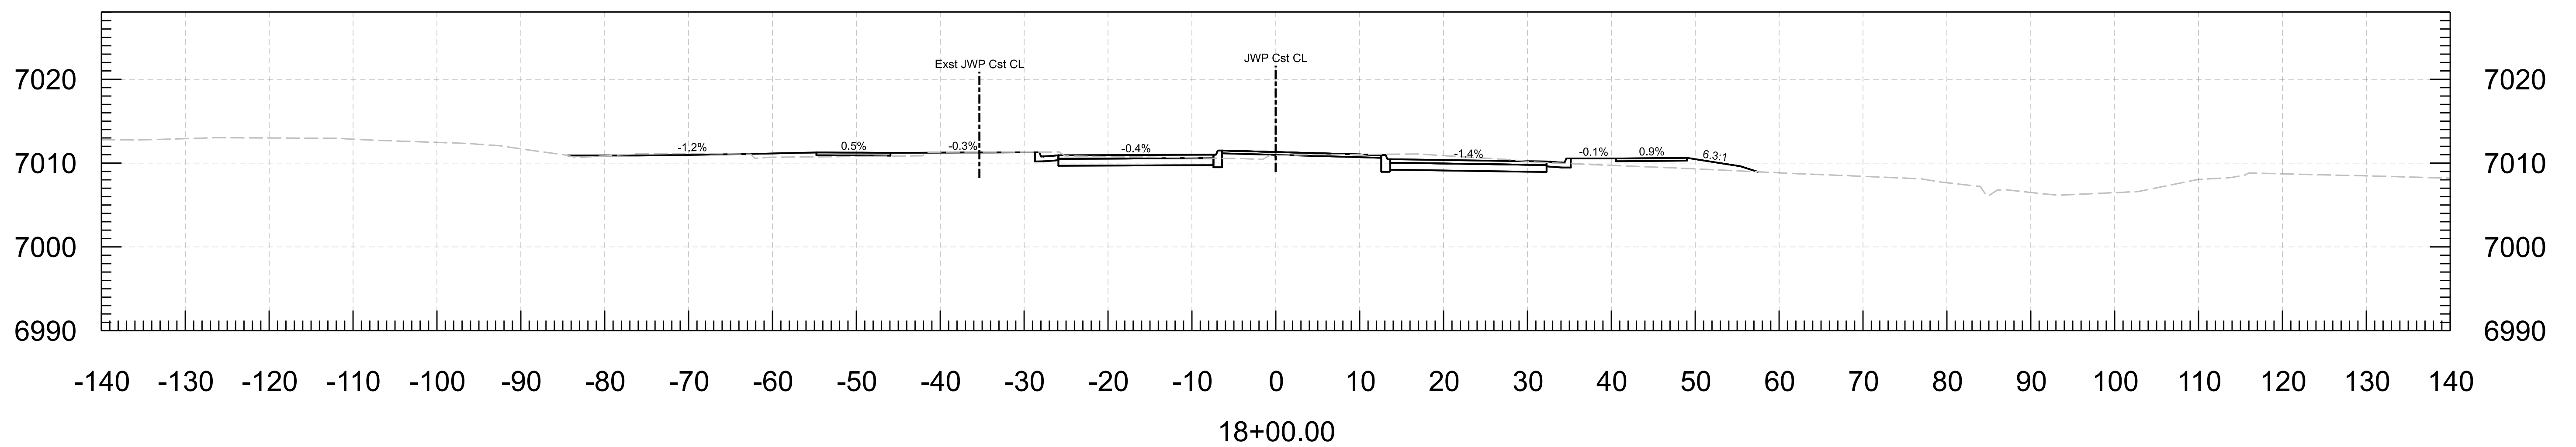


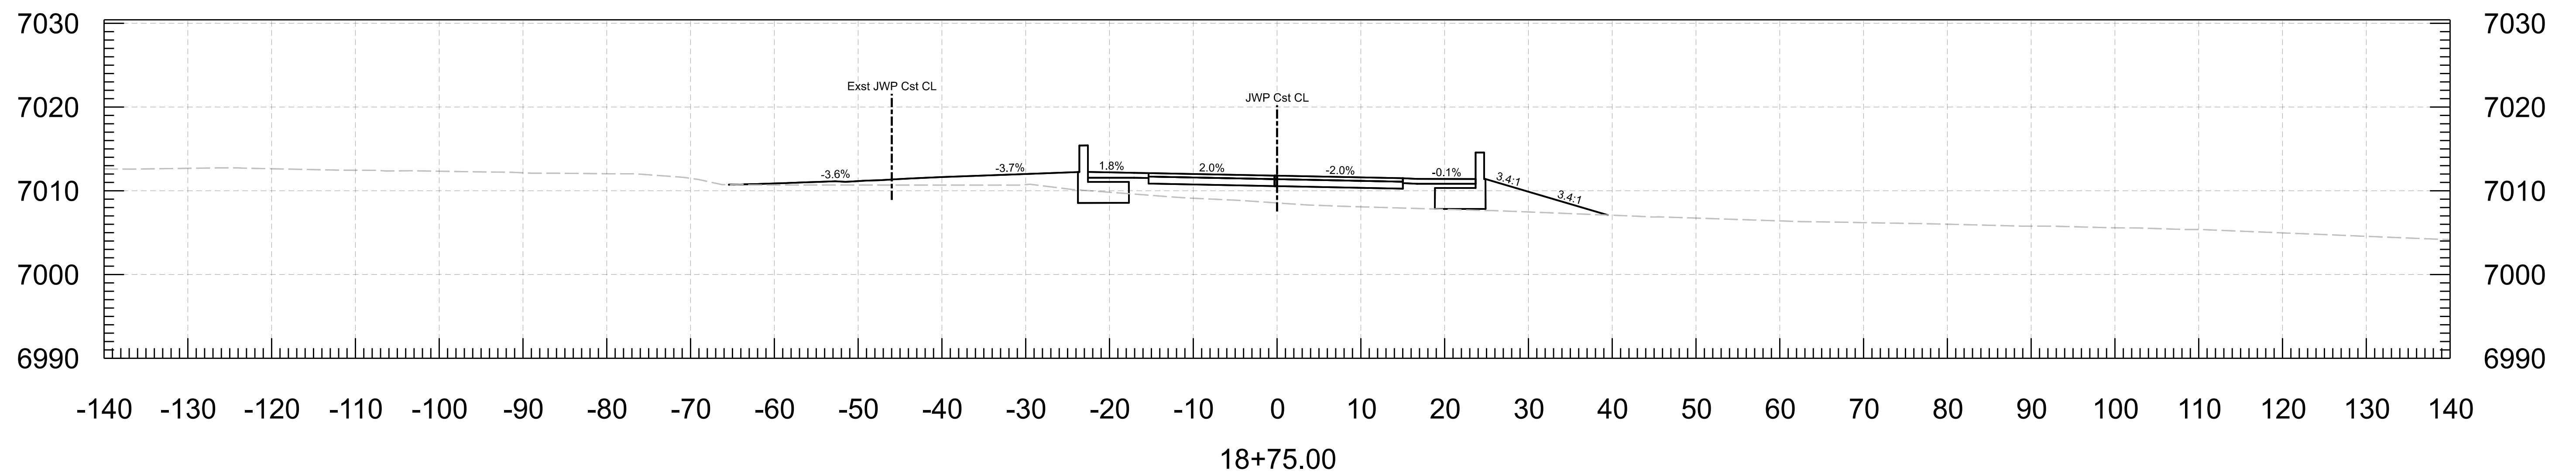
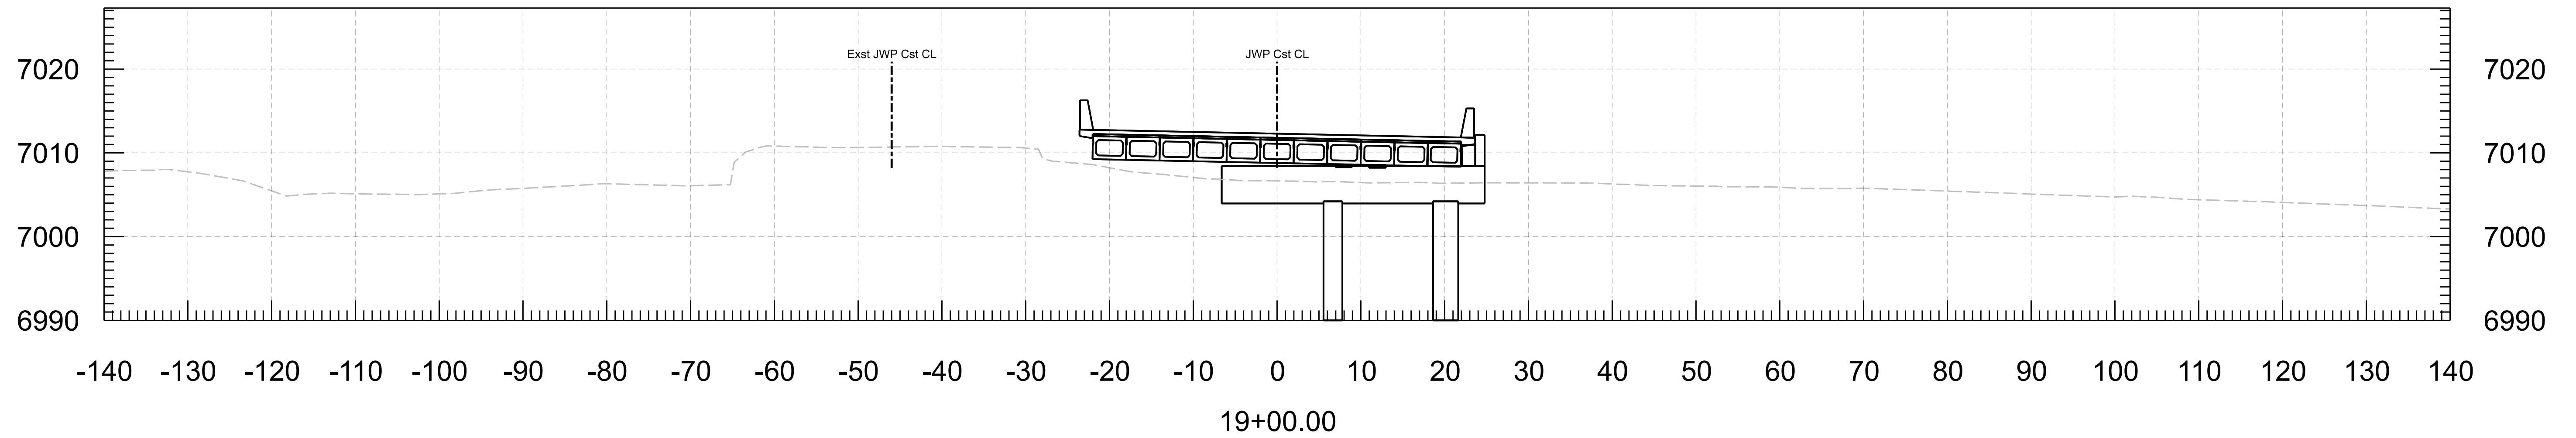
 <p>Contact Arizona 811 at least two full working days before you begin excavation</p>	<table border="1"> <tr><th>NAME</th><th>DATE</th></tr> <tr><td>J.NOYES</td><td>10/23</td></tr> <tr><td>J.NOYES</td><td>10/23</td></tr> <tr><td>L.BUSENBARK</td><td>10/23</td></tr> </table>	NAME	DATE	J.NOYES	10/23	J.NOYES	10/23	L.BUSENBARK	10/23	ARIZONA DEPARTMENT OF TRANSPORTATION INFRASTRUCTURE DELIVERY AND OPERATIONS DIVISION ROADWAY DESIGN SECTION	ROUTE I-17	F.H.W.A. Arizona Division	STATE	PROJECT NO.	FEDERAL ID NO.	SHEET NO.	TOTAL SHEETS	RECORD DRAWING
	NAME	DATE																
	J.NOYES	10/23																
J.NOYES	10/23																	
L.BUSENBARK	10/23																	
ARIZ.		017 CN 337	017-B(237)T	10	27													
 HDR, INC. 20 E. THOMAS ROAD SUITE 2500 PHOENIX, AZ 85012 TEL: (602) 522-7700		CROSS SECTIONS JW POWELL BLVD	MILEPOST 337.39	LOCATION I-17 AIRPORT RD TI UP														
			STRUCTURE NO.	TRACS NO. F0362 01C														
DWG NO. _____ OF _____																		



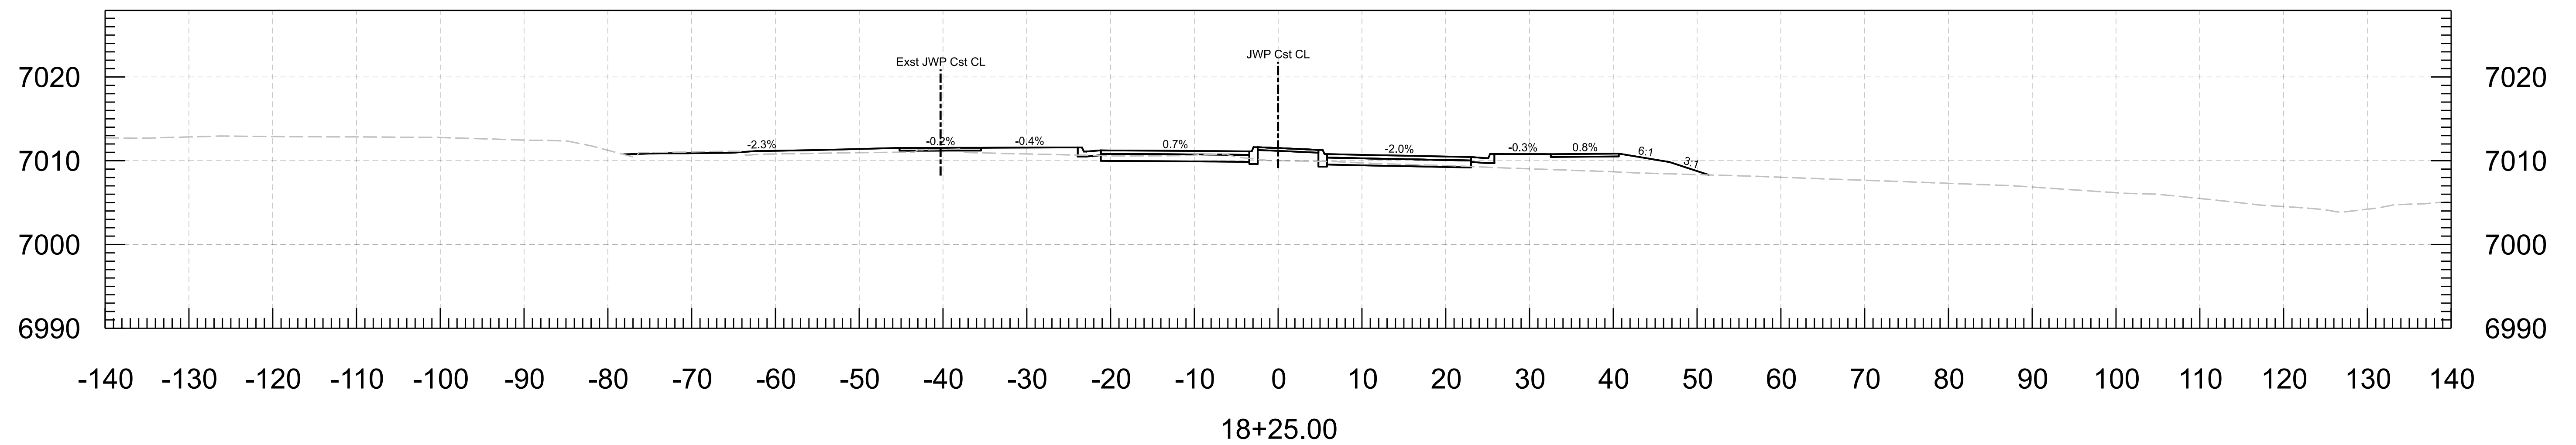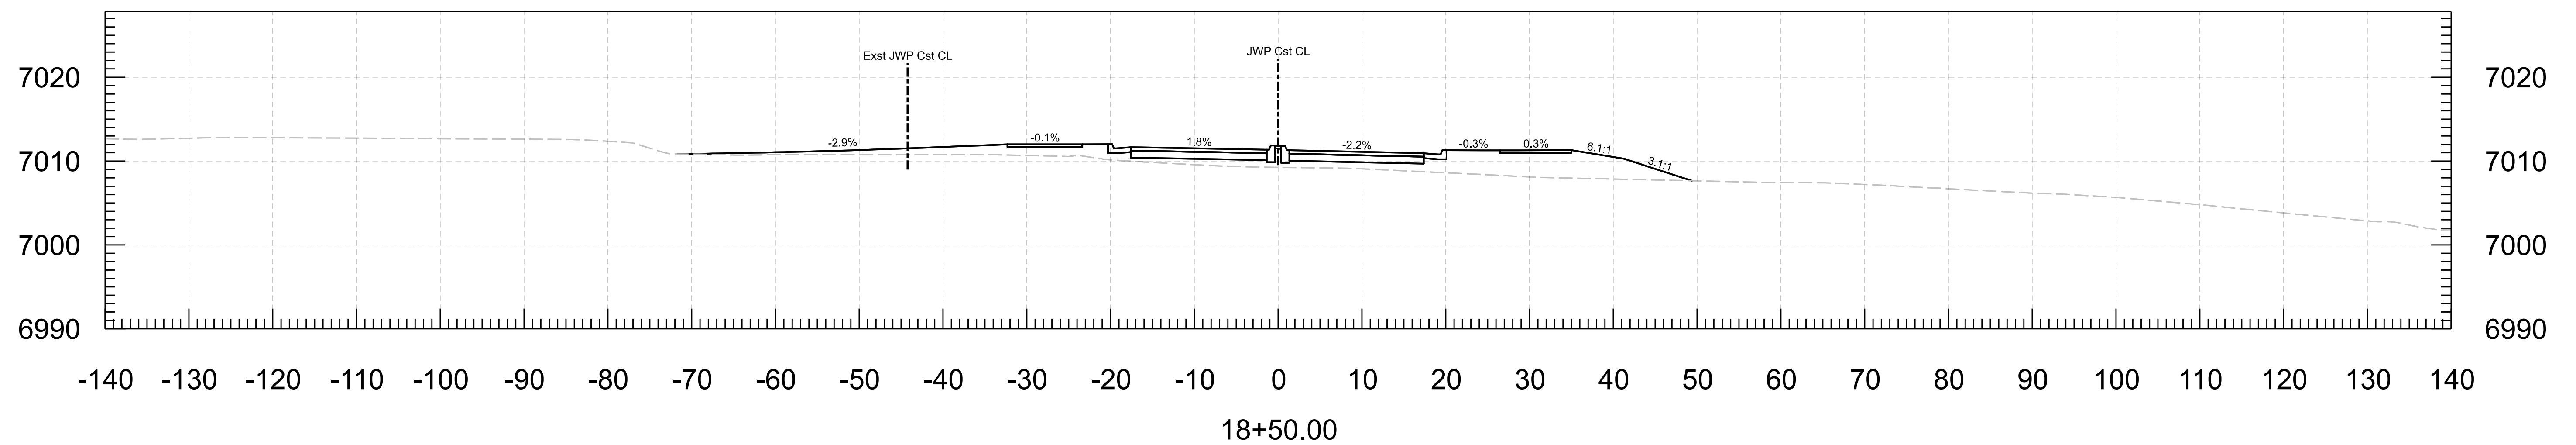



 <p>Contact Arizona 811 at least two full working days before you begin excavation</p>	<table border="1"> <tr><th>NAME</th><th>DATE</th></tr> <tr><td>J.NOYES</td><td>10/23</td></tr> <tr><td>J.NOYES</td><td>10/23</td></tr> <tr><td>L.BUSENBARK</td><td>10/23</td></tr> </table>	NAME	DATE	J.NOYES	10/23	J.NOYES	10/23	L.BUSENBARK	10/23	ARIZONA DEPARTMENT OF TRANSPORTATION INFRASTRUCTURE DELIVERY AND OPERATIONS DIVISION ROADWAY DESIGN SECTION	ROUTE I-17	F.H.W.A. Arizona Division STATE ARIZ.	PROJECT NO. 017 CN 337	FEDERAL ID NO. 017-B(237)T	SHEET NO. 11	TOTAL SHEETS 27	RECORD DRAWING
	NAME	DATE															
	J.NOYES	10/23															
J.NOYES	10/23																
L.BUSENBARK	10/23																
DESIGN DRAWN CHECKED	CROSS SECTIONS JW POWELL BLVD	MILEPOST 337.39	LOCATION I-17 AIRPORT RD TI UP				DWG NO. ____ OF ____										
 HDR, INC. 20 E. THOMAS ROAD SUITE 2500 PHOENIX, AZ 85012 TEL (602) 522-7700	TRACS NO. F0362 01C																







 <p>Contact Arizona 811 at least two full working days before you begin excavation</p>	<table border="1"> <tr><th>DESIGN</th><td>J.NOYES</td><td>10/23</td></tr> <tr><th>DRAWN</th><td>J.NOYES</td><td>10/23</td></tr> <tr><th>CHECKED</th><td>L.BUSENBARK</td><td>10/23</td></tr> </table>	DESIGN	J.NOYES	10/23	DRAWN	J.NOYES	10/23	CHECKED	L.BUSENBARK	10/23	<p>HDR, INC. 20 E. THOMAS ROAD SUITE 2500 PHOENIX, AZ 85012 TEL (602) 522-7700</p>	<p>ARIZONA DEPARTMENT OF TRANSPORTATION INFRASTRUCTURE DELIVERY AND OPERATIONS DIVISION ROADWAY DESIGN SECTION</p>	<table border="1"> <tr><th>ROUTE</th><td>I-17</td></tr> <tr><th>MILEPOST</th><td>337.39</td></tr> <tr><th>STRUCTURE NO.</th><td></td></tr> </table>	ROUTE	I-17	MILEPOST	337.39	STRUCTURE NO.		<table border="1"> <tr><th>STATE</th><td>ARIZ.</td></tr> <tr><th>PROJECT NO.</th><td>017 CN 337</td></tr> <tr><th>FEDERAL ID NO.</th><td>017-B(237)T</td></tr> </table>	STATE	ARIZ.	PROJECT NO.	017 CN 337	FEDERAL ID NO.	017-B(237)T	<table border="1"> <tr><th>SHEET NO.</th><td>12</td></tr> <tr><th>TOTAL SHEETS</th><td>27</td></tr> </table>	SHEET NO.	12	TOTAL SHEETS	27	<table border="1"> <tr><th>RECORD DRAWING</th><td></td></tr> </table>	RECORD DRAWING	
	DESIGN	J.NOYES	10/23																															
	DRAWN	J.NOYES	10/23																															
CHECKED	L.BUSENBARK	10/23																																
ROUTE	I-17																																	
MILEPOST	337.39																																	
STRUCTURE NO.																																		
STATE	ARIZ.																																	
PROJECT NO.	017 CN 337																																	
FEDERAL ID NO.	017-B(237)T																																	
SHEET NO.	12																																	
TOTAL SHEETS	27																																	
RECORD DRAWING																																		
<p>CROSS SECTIONS JW POWELL BLVD</p>				<p>LOCATION I-17 AIRPORT RD TI UP</p>			<p>DWG NO.</p>																											
				<p>TRACS NO. F0362 01C</p>			<p>___ OF ___</p>																											



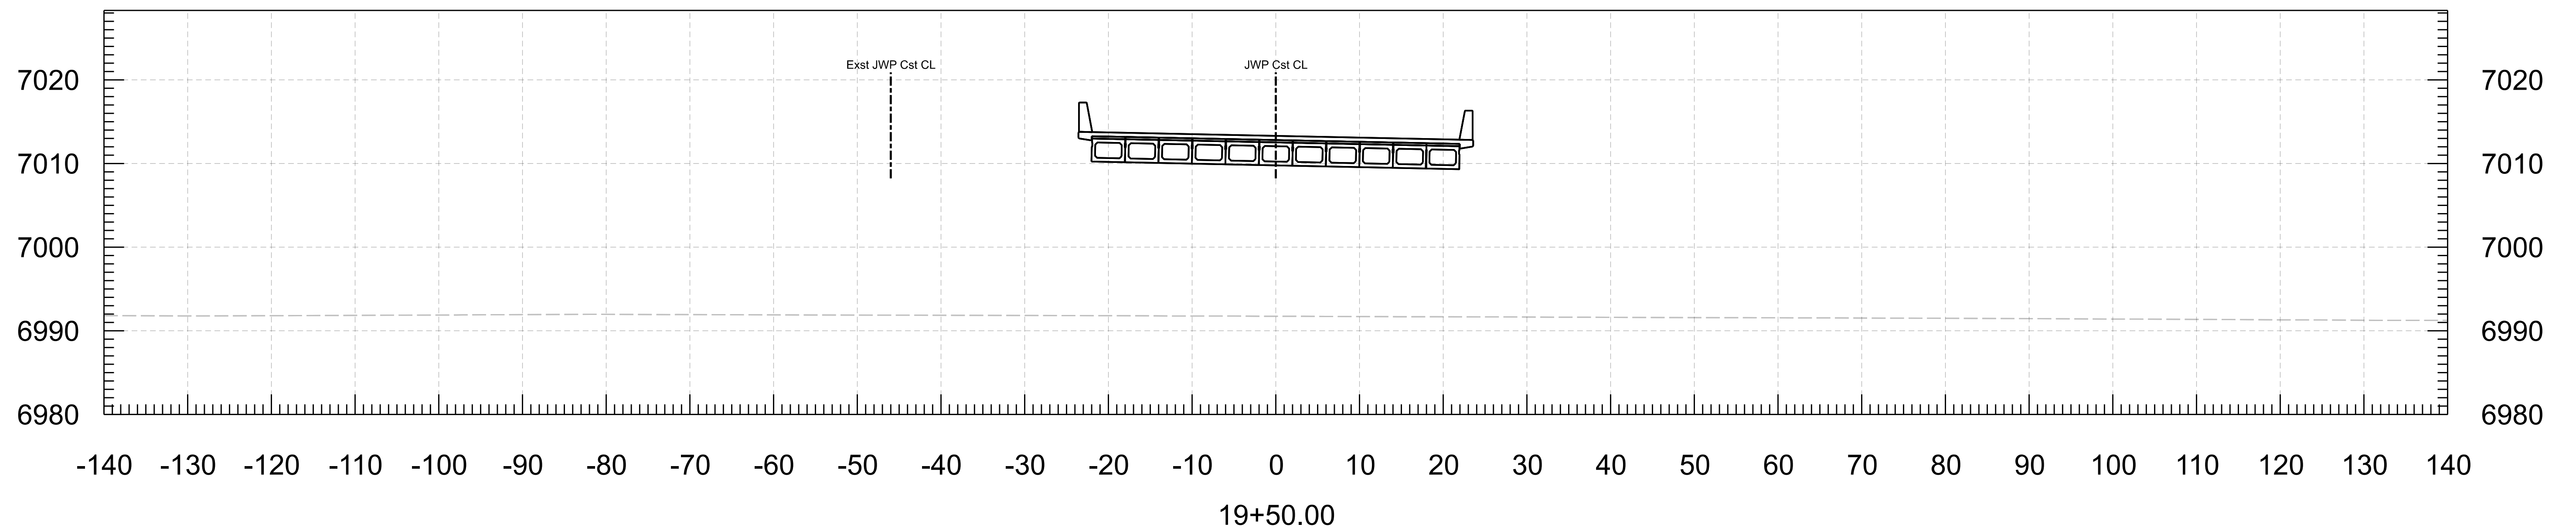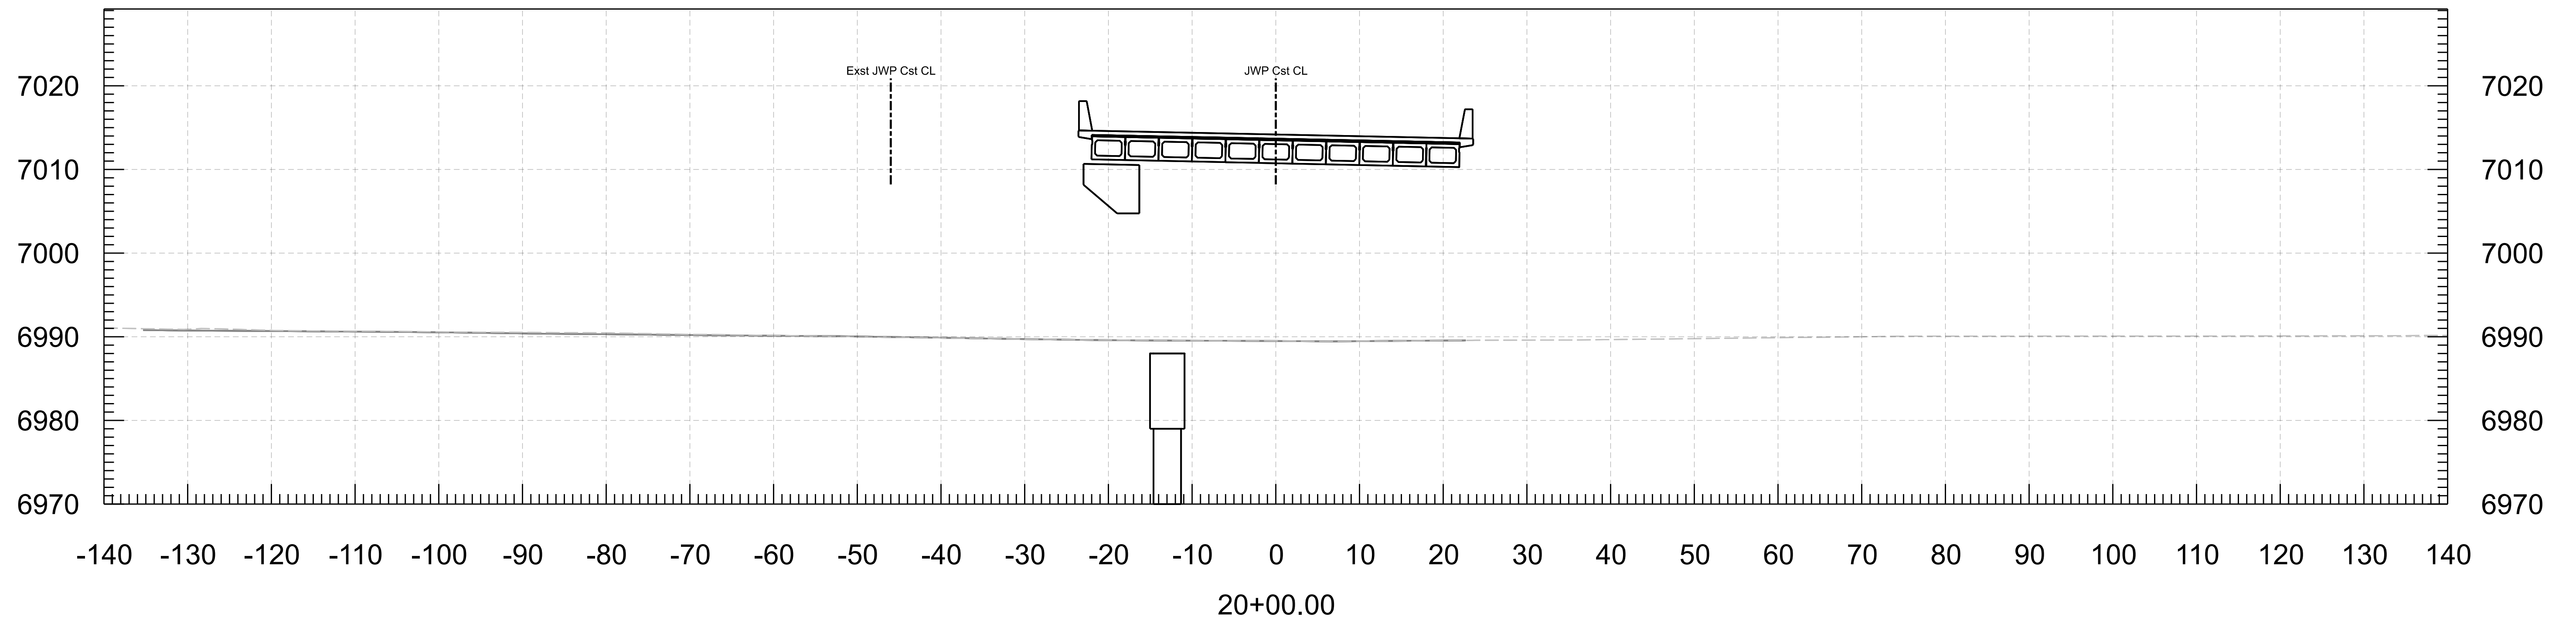


	DESIGN	J.NOYES	10/23	ARIZONA DEPARTMENT OF TRANSPORTATION INFRASTRUCTURE DELIVERY AND OPERATIONS DIVISION ROADWAY DESIGN SECTION	ROUTE	I-17	F.H.W.A. Arizona Division STATE ARIZ.	PROJECT NO.	017 CN 337	FEDERAL ID NO.	017-B(237)T	SHEET NO.	13	TOTAL SHEETS	27	RECORD DRAWING
	DRAWN	J.NOYES	10/23		MILEPOST	337.39		LOCATION	I-17 AIRPORT RD TI UP				DWG NO.	___ OF ___		
	CHECKED	L.BUSENBARK	10/23		STRUCTURE NO.			TRACS NO.	F0362 01C							
 HDR, INC. 20 E. THOMAS ROAD SUITE 2500 PHOENIX, AZ 85012 TEL (602) 522-7700				CROSS SECTIONS JW POWELL BLVD												

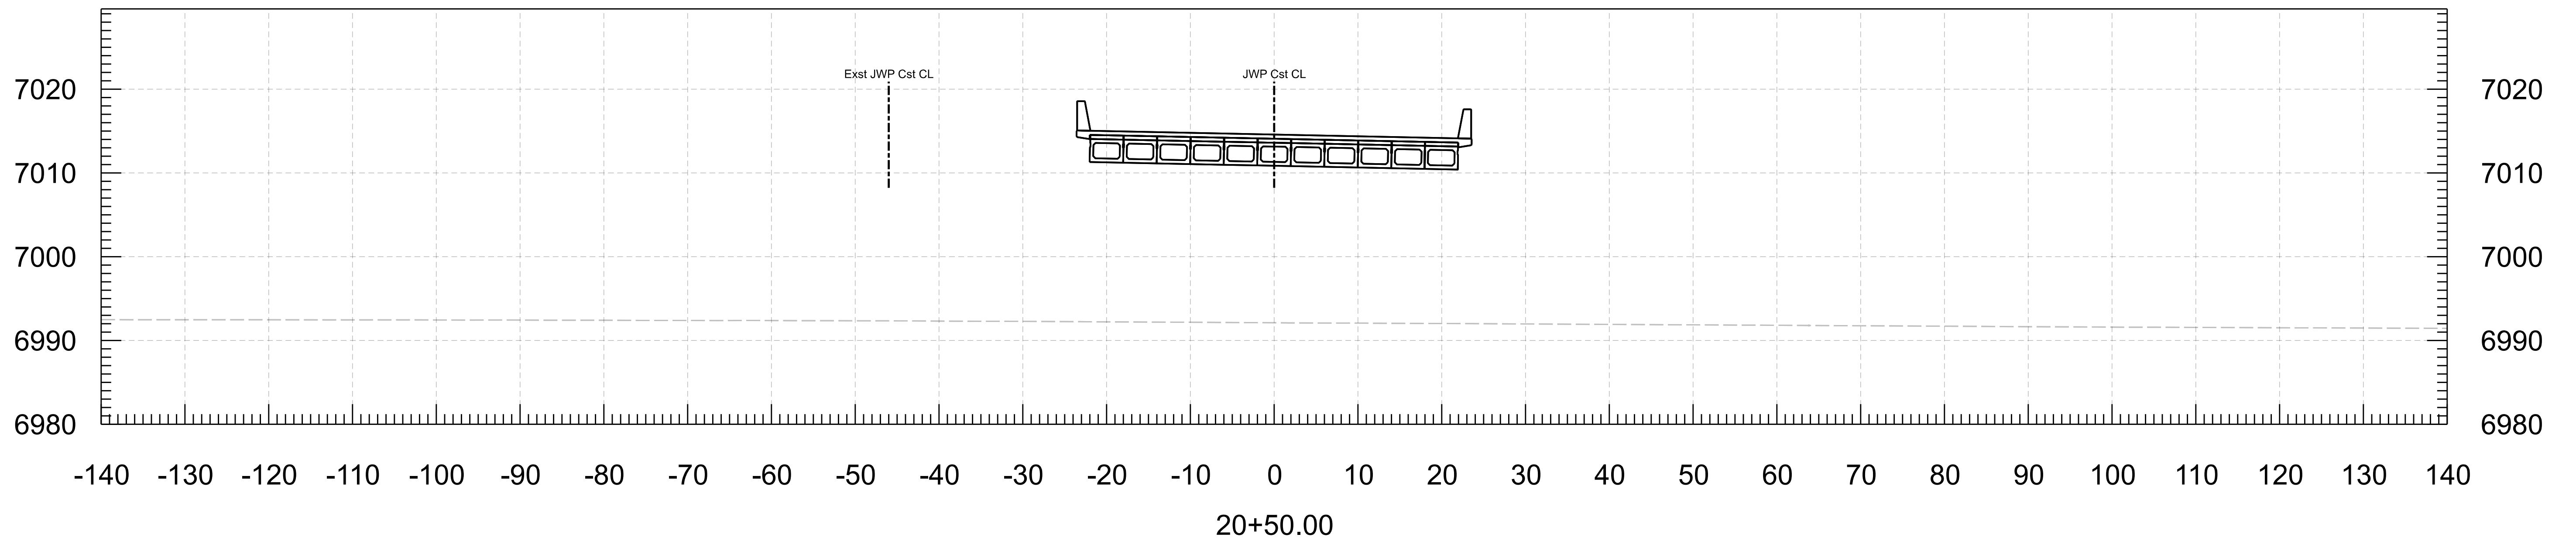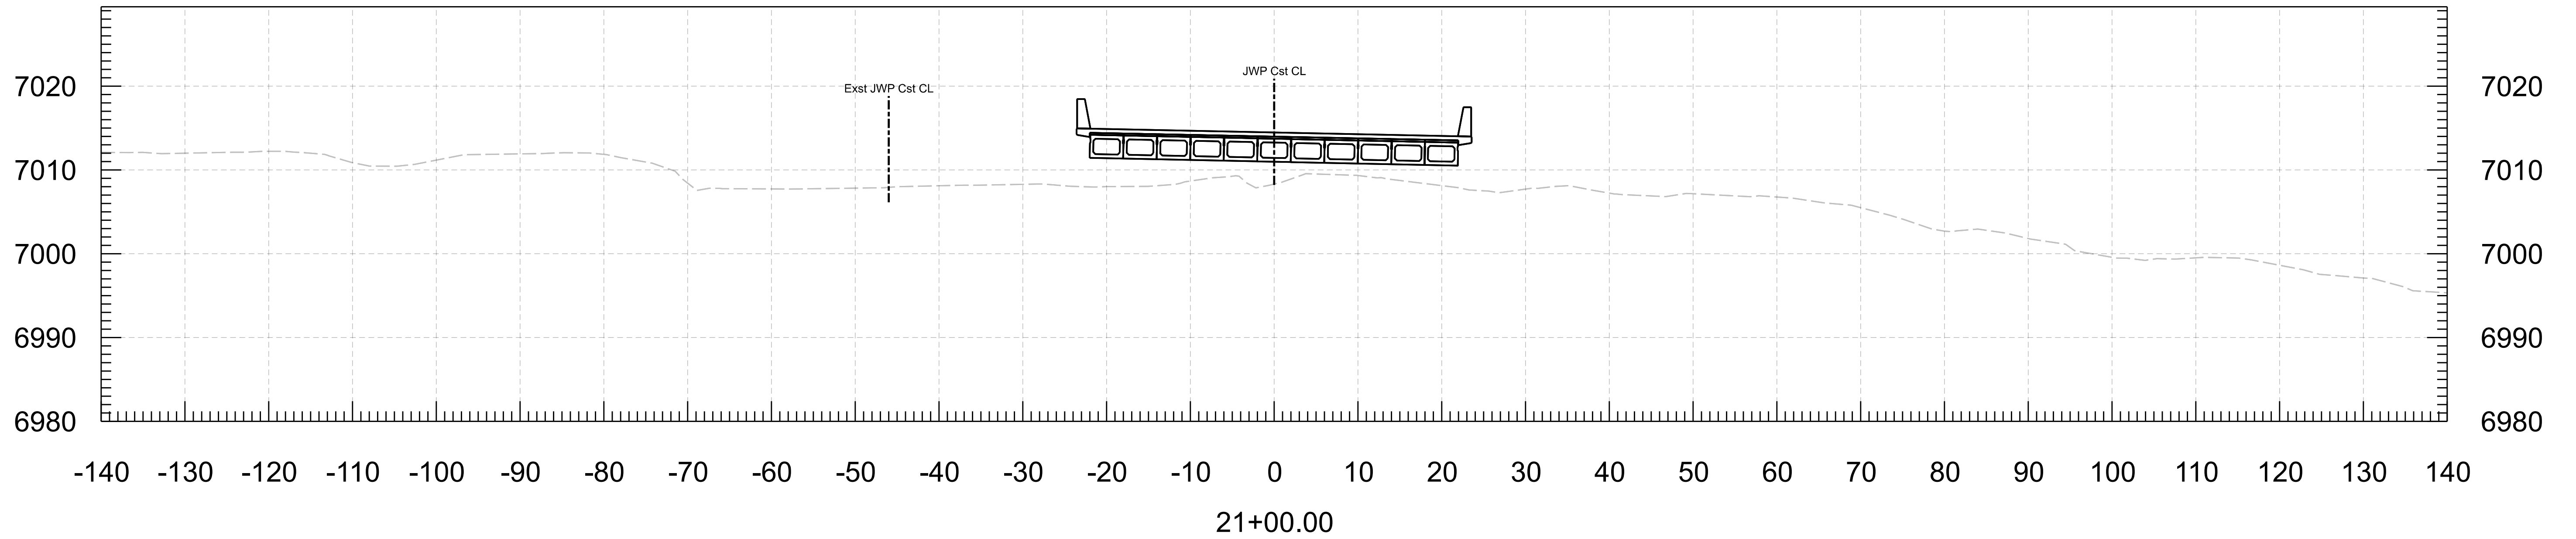


 <p>Contact Arizona 811 at least two full working days before you begin excavation</p>	<table border="1"> <thead> <tr> <th>DESIGN</th> <th>NAME</th> <th>DATE</th> </tr> </thead> <tbody> <tr> <td>J.NOYES</td> <td>J.NOYES</td> <td>10/23</td> </tr> <tr> <td>DRAWN</td> <td>J.NOYES</td> <td>10/23</td> </tr> <tr> <td>CHECKED</td> <td>L.BUSENBARK</td> <td>10/23</td> </tr> </tbody> </table>	DESIGN	NAME	DATE	J.NOYES	J.NOYES	10/23	DRAWN	J.NOYES	10/23	CHECKED	L.BUSENBARK	10/23	<p>ARIZONA DEPARTMENT OF TRANSPORTATION INFRASTRUCTURE DELIVERY AND OPERATIONS DIVISION ROADWAY DESIGN SECTION</p>	<table border="1"> <tr> <td>ROUTE</td> <td>I-17</td> </tr> <tr> <td>MILEPOST</td> <td>337.39</td> </tr> <tr> <td>STRUCTURE NO.</td> <td></td> </tr> </table>	ROUTE	I-17	MILEPOST	337.39	STRUCTURE NO.		<table border="1"> <tr> <td>F.H.W.A. Arizona Division</td> <td>STATE</td> <td>ARIZ.</td> <td>PROJECT NO.</td> <td>017 CN 337</td> <td>FEDERAL ID NO.</td> <td>017-B(237)T</td> <td>SHEET NO.</td> <td>14</td> <td>TOTAL SHEETS</td> <td>27</td> <td>RECORD DRAWING</td> </tr> </table>	F.H.W.A. Arizona Division	STATE	ARIZ.	PROJECT NO.	017 CN 337	FEDERAL ID NO.	017-B(237)T	SHEET NO.	14	TOTAL SHEETS	27	RECORD DRAWING
	DESIGN	NAME	DATE																															
	J.NOYES	J.NOYES	10/23																															
DRAWN	J.NOYES	10/23																																
CHECKED	L.BUSENBARK	10/23																																
ROUTE	I-17																																	
MILEPOST	337.39																																	
STRUCTURE NO.																																		
F.H.W.A. Arizona Division	STATE	ARIZ.	PROJECT NO.	017 CN 337	FEDERAL ID NO.	017-B(237)T	SHEET NO.	14	TOTAL SHEETS	27	RECORD DRAWING																							
 <p>HDR, INC. 20 E. THOMAS ROAD SUITE 2500 PHOENIX, AZ 85012 TEL (602) 522-7700</p>	<p>CROSS SECTIONS JW POWELL BLVD</p>	<table border="1"> <tr> <td>LOCATION</td> <td colspan="2">I-17 AIRPORT RD TI UP</td> </tr> <tr> <td>TRACS NO.</td> <td colspan="2">F0362 01C</td> </tr> </table>	LOCATION	I-17 AIRPORT RD TI UP		TRACS NO.	F0362 01C		<table border="1"> <tr> <td>DWG NO.</td> <td>___ OF ___</td> </tr> </table>	DWG NO.	___ OF ___																							
LOCATION	I-17 AIRPORT RD TI UP																																	
TRACS NO.	F0362 01C																																	
DWG NO.	___ OF ___																																	
<p>LBUSENBA 8/2/2023 4:20:08 PM c:\pwworking\west01\d2513136\0362xs02.dgn \ Model Name: 02A_GEO_JWP - 19+50.00 [Sheet]</p>																																		




	DESIGN	J.NOYES	10/23	ARIZONA DEPARTMENT OF TRANSPORTATION INFRASTRUCTURE DELIVERY AND OPERATIONS DIVISION ROADWAY DESIGN SECTION	ROUTE	I-17	F.H.W.A. Arizona Division STATE ARIZ.	PROJECT NO.	017 CN 337	FEDERAL ID NO.	017-B(237)T	SHEET NO.	15	TOTAL SHEETS	27	RECORD DRAWING
	DRAWN	J.NOYES	10/23		MILEPOST	337.39		LOCATION	I-17 AIRPORT RD TI UP				DWG NO.	___ OF ___		
	CHECKED	L.BUSENBARK	10/23		STRUCTURE NO.			TRACS NO.	F0362 01C							
 HDR, INC. 20 E. THOMAS ROAD SUITE 2500 PHOENIX, AZ 85012 TEL (602) 522-7700				CROSS SECTIONS JW POWELL BLVD												

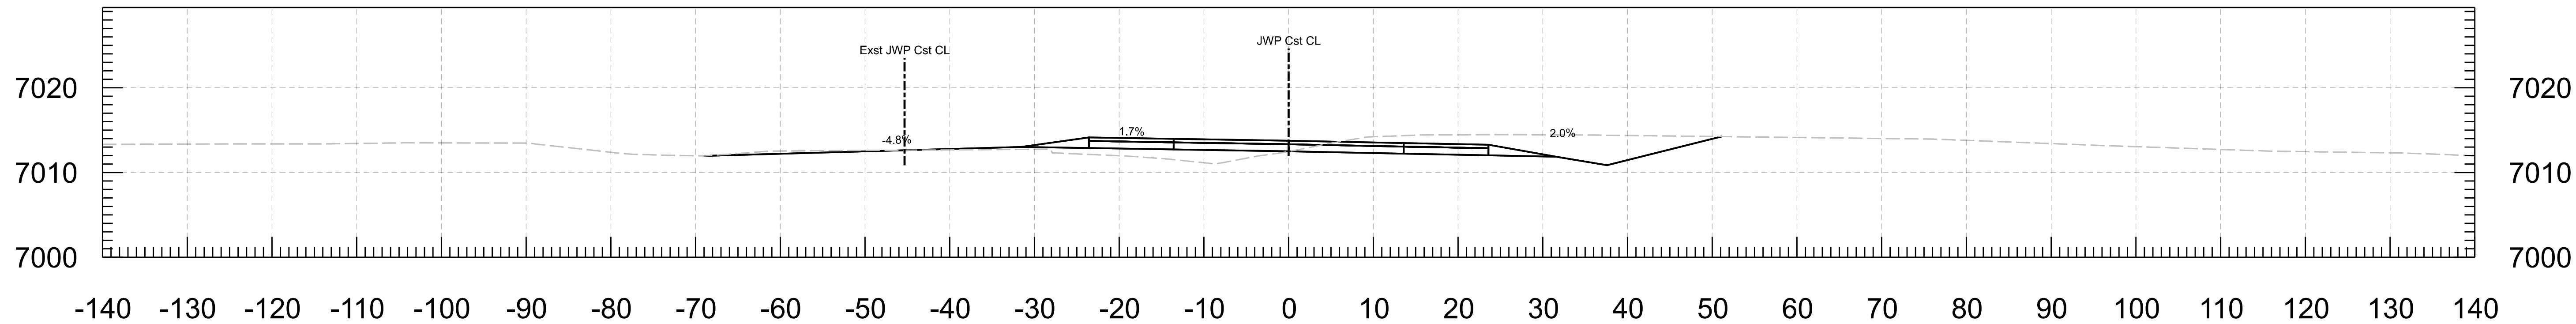

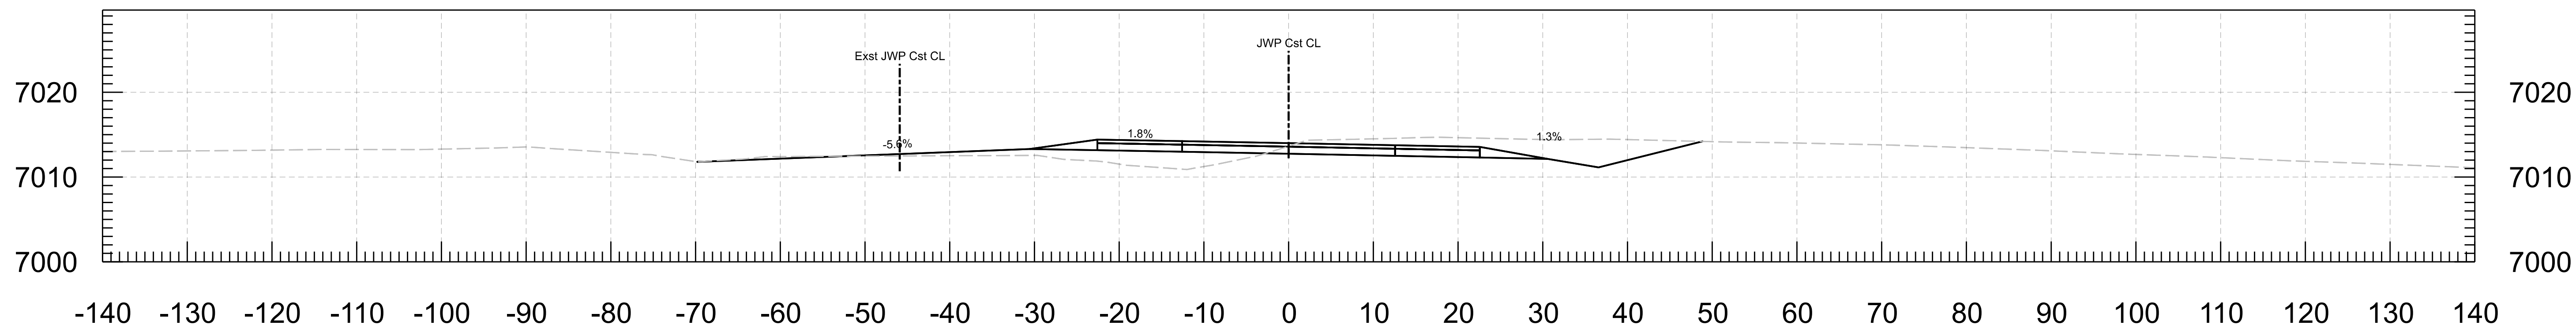

21+75.00






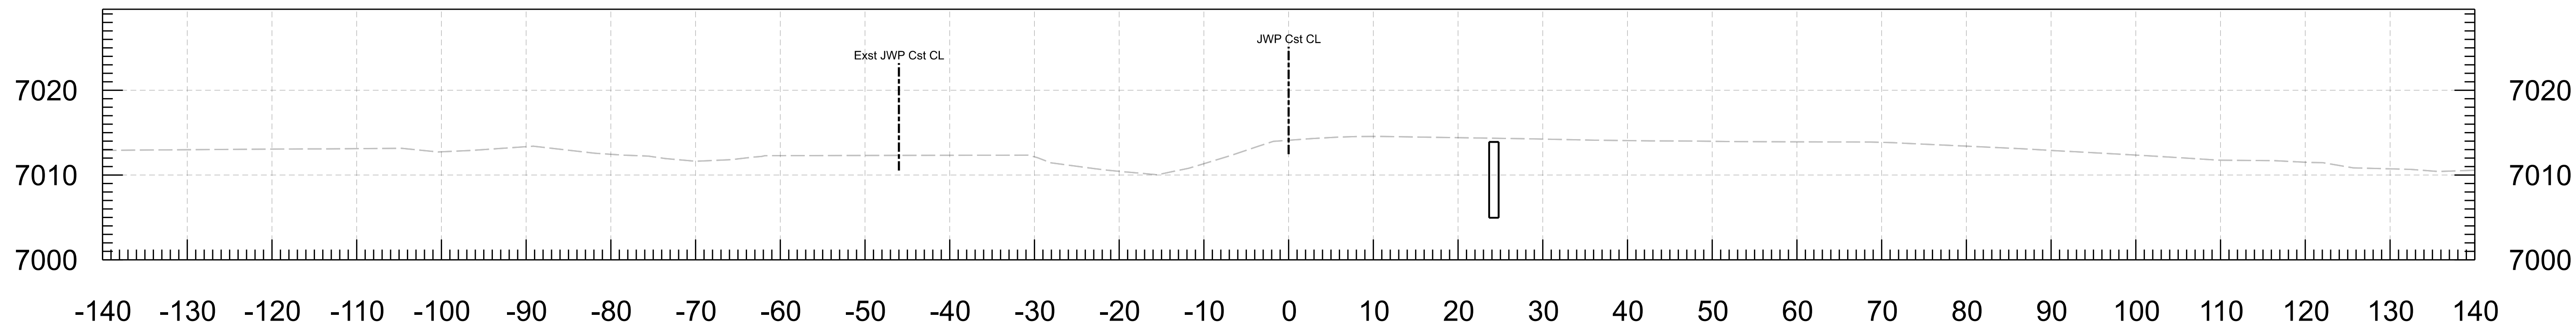

21+50.00






21+25.00

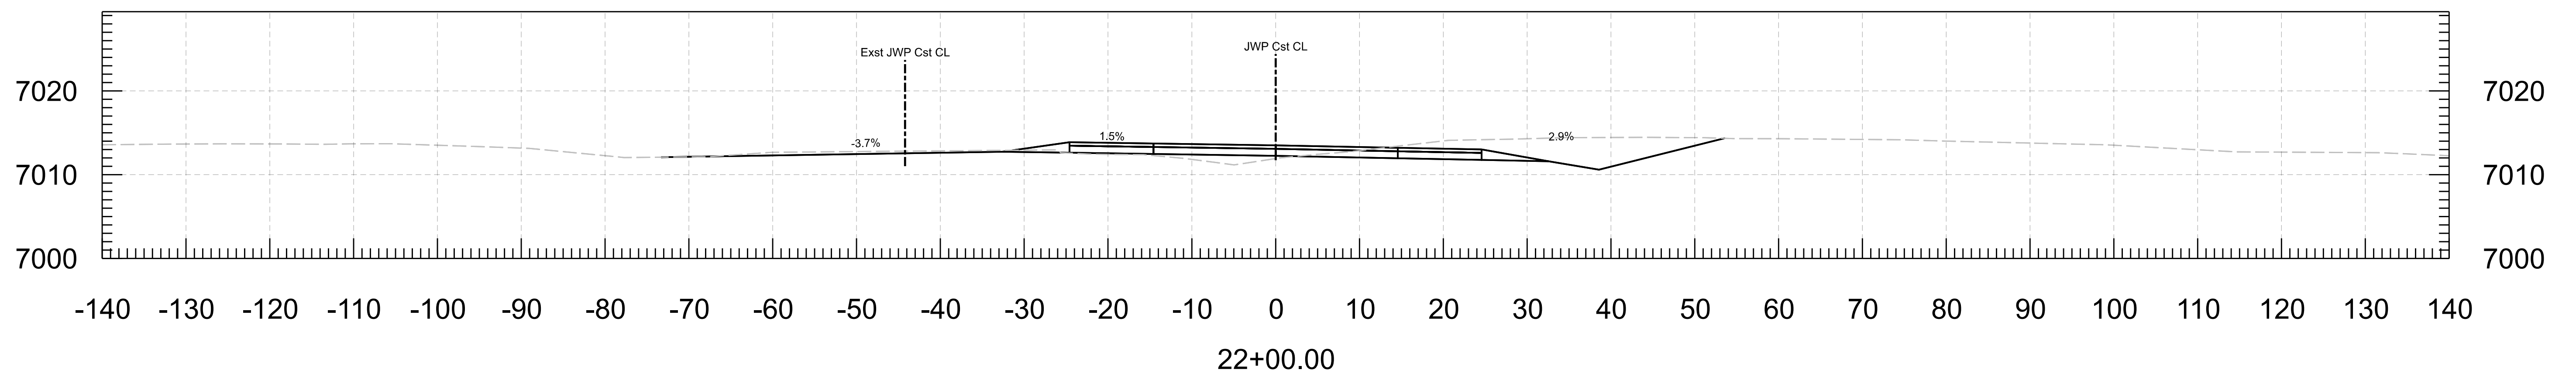
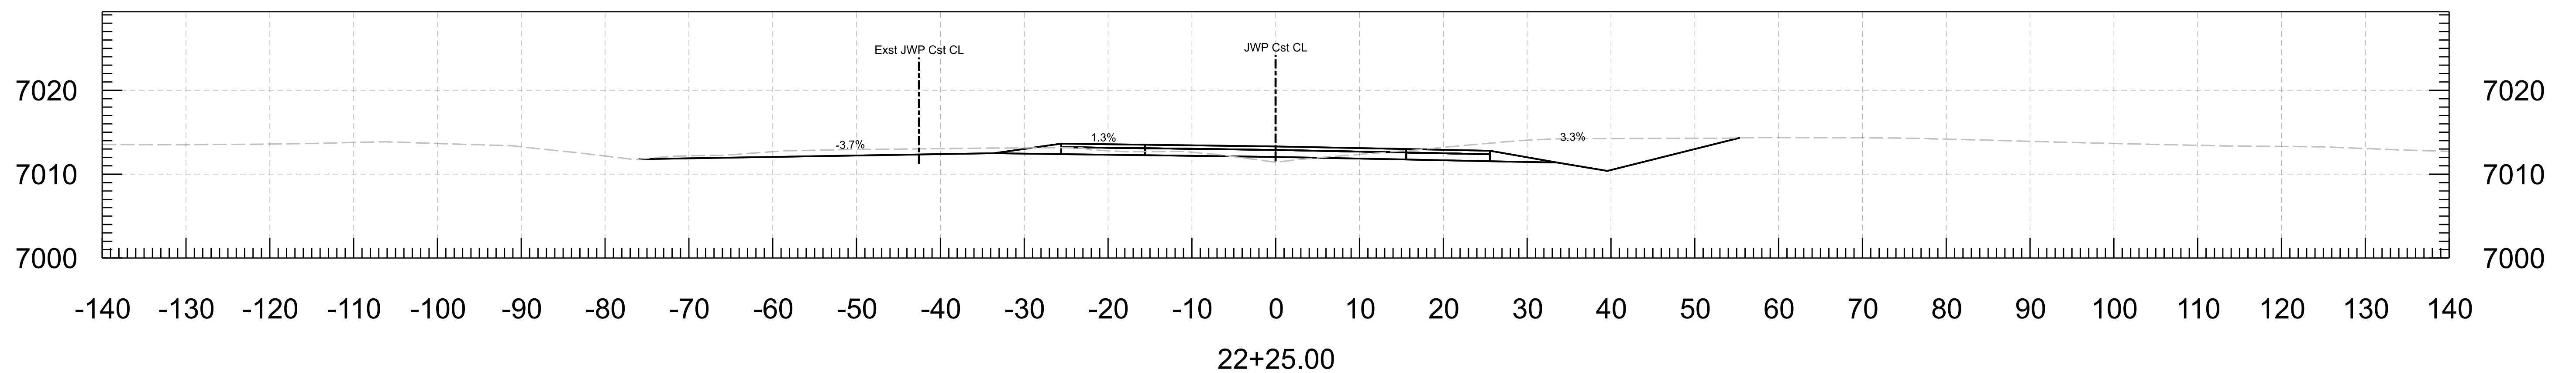
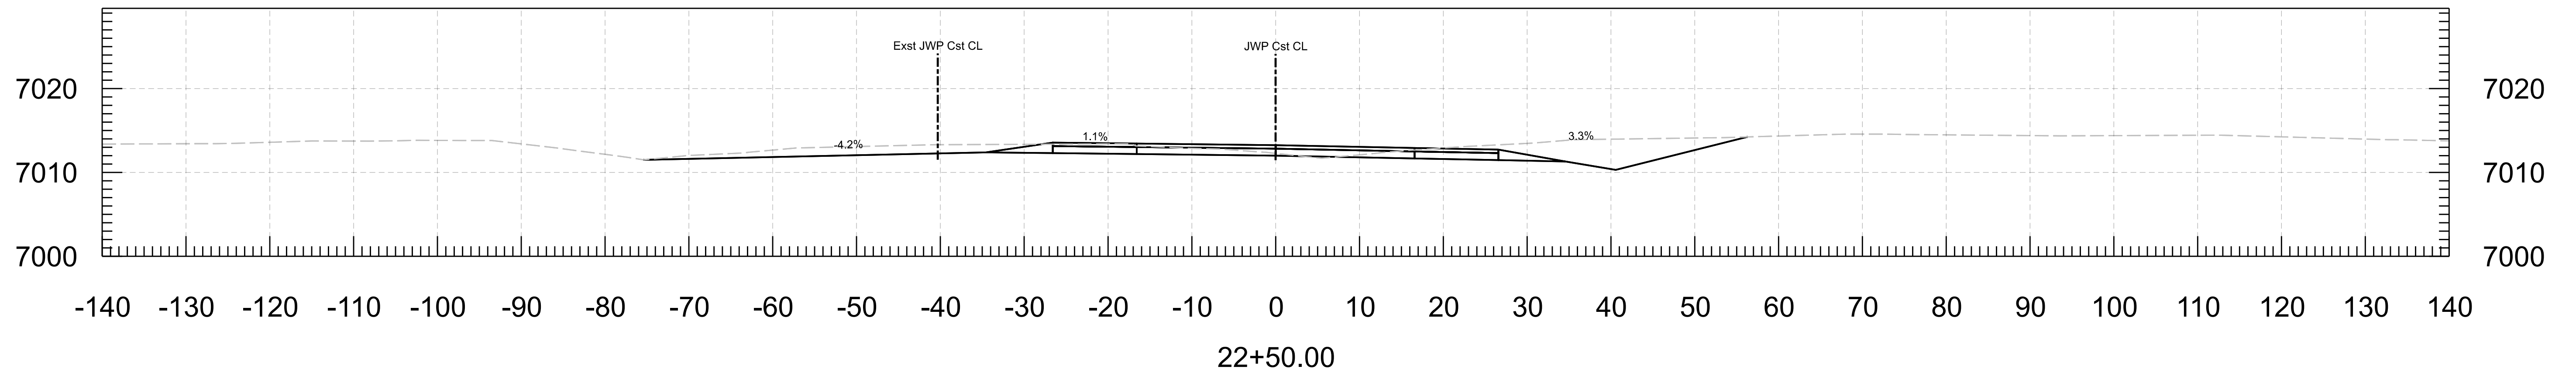
 <p>Contact Arizona 811 at least two full working days before you begin excavation</p>	<table border="1"> <tr><th>DESIGN</th><td>J.NOYES</td><td>10/23</td></tr> <tr><th>DRAWN</th><td>J.NOYES</td><td>10/23</td></tr> <tr><th>CHECKED</th><td>L.BUSENBARK</td><td>10/23</td></tr> </table>	DESIGN	J.NOYES	10/23	DRAWN	J.NOYES	10/23	CHECKED	L.BUSENBARK	10/23	<table border="1"> <tr><th>NAME</th><td>J.NOYES</td><td>10/23</td></tr> <tr><th>DATE</th><td>J.NOYES</td><td>10/23</td></tr> <tr><th>DATE</th><td>L.BUSENBARK</td><td>10/23</td></tr> </table>	NAME	J.NOYES	10/23	DATE	J.NOYES	10/23	DATE	L.BUSENBARK	10/23	<p>ARIZONA DEPARTMENT OF TRANSPORTATION INFRASTRUCTURE DELIVERY AND OPERATIONS DIVISION ROADWAY DESIGN SECTION</p>	<table border="1"> <tr><th>ROUTE</th><td>I-17</td></tr> <tr><th>MILEPOST</th><td>337.39</td></tr> <tr><th>STRUCTURE NO.</th><td></td></tr> </table>	ROUTE	I-17	MILEPOST	337.39	STRUCTURE NO.		<table border="1"> <tr><th>STATE</th><td>ARIZ.</td></tr> <tr><th>PROJECT NO.</th><td>017 CN 337</td></tr> <tr><th>FEDERAL ID NO.</th><td>017-B(237)T</td></tr> <tr><th>SHEET NO.</th><td>16</td></tr> <tr><th>TOTAL SHEETS</th><td>27</td></tr> </table>	STATE	ARIZ.	PROJECT NO.	017 CN 337	FEDERAL ID NO.	017-B(237)T	SHEET NO.	16	TOTAL SHEETS	27	<table border="1"> <tr><th>RECORD DRAWING</th><td></td></tr> </table>	RECORD DRAWING	
	DESIGN	J.NOYES	10/23																																							
	DRAWN	J.NOYES	10/23																																							
CHECKED	L.BUSENBARK	10/23																																								
NAME	J.NOYES	10/23																																								
DATE	J.NOYES	10/23																																								
DATE	L.BUSENBARK	10/23																																								
ROUTE	I-17																																									
MILEPOST	337.39																																									
STRUCTURE NO.																																										
STATE	ARIZ.																																									
PROJECT NO.	017 CN 337																																									
FEDERAL ID NO.	017-B(237)T																																									
SHEET NO.	16																																									
TOTAL SHEETS	27																																									
RECORD DRAWING																																										
 <p>HDR, INC. 20 E. THOMAS ROAD SUITE 2500 PHOENIX, AZ 85012 TEL (602) 522-7700</p>	<p>CROSS SECTIONS JW POWELL BLVD</p>			<p>LOCATION I-17 AIRPORT RD TI UP</p>			<table border="1"> <tr><th>DWG NO.</th><td>___ OF ___</td></tr> </table>	DWG NO.	___ OF ___																																	
	DWG NO.	___ OF ___																																								
<p>TRACS NO. F0362 01C</p>																																										



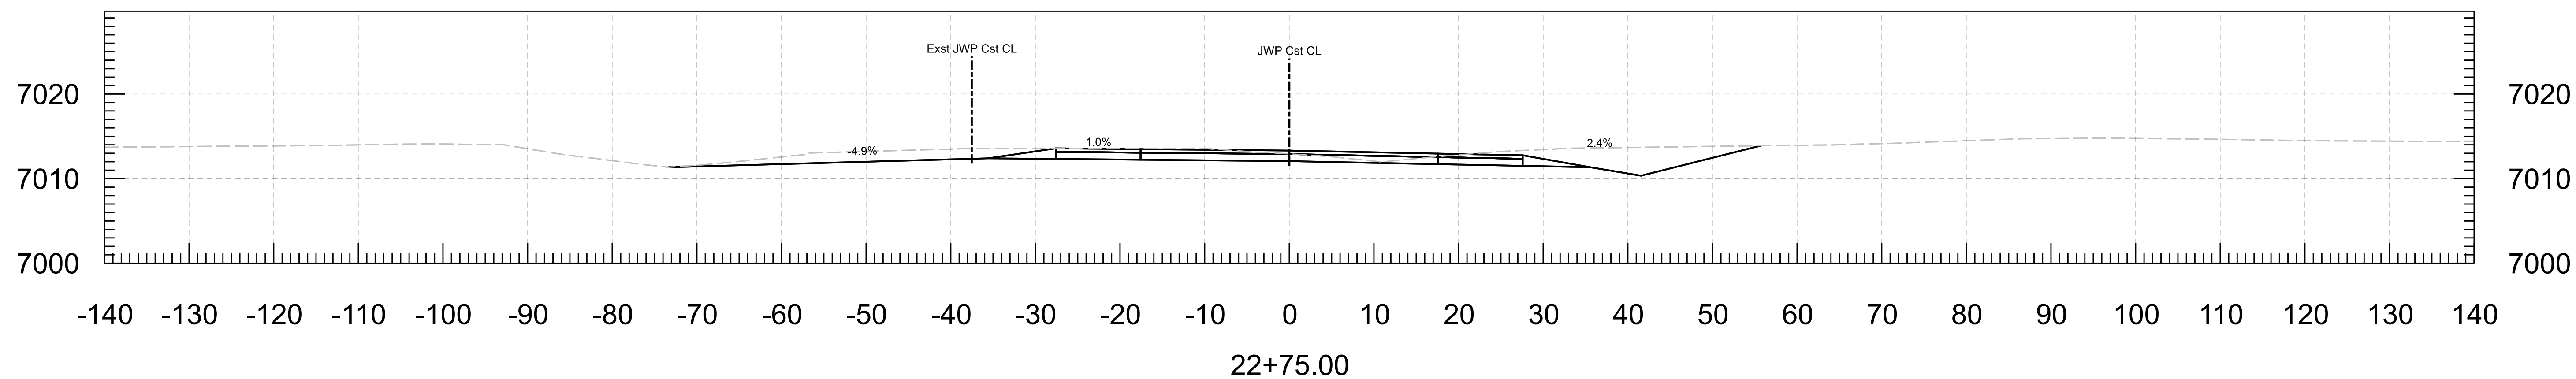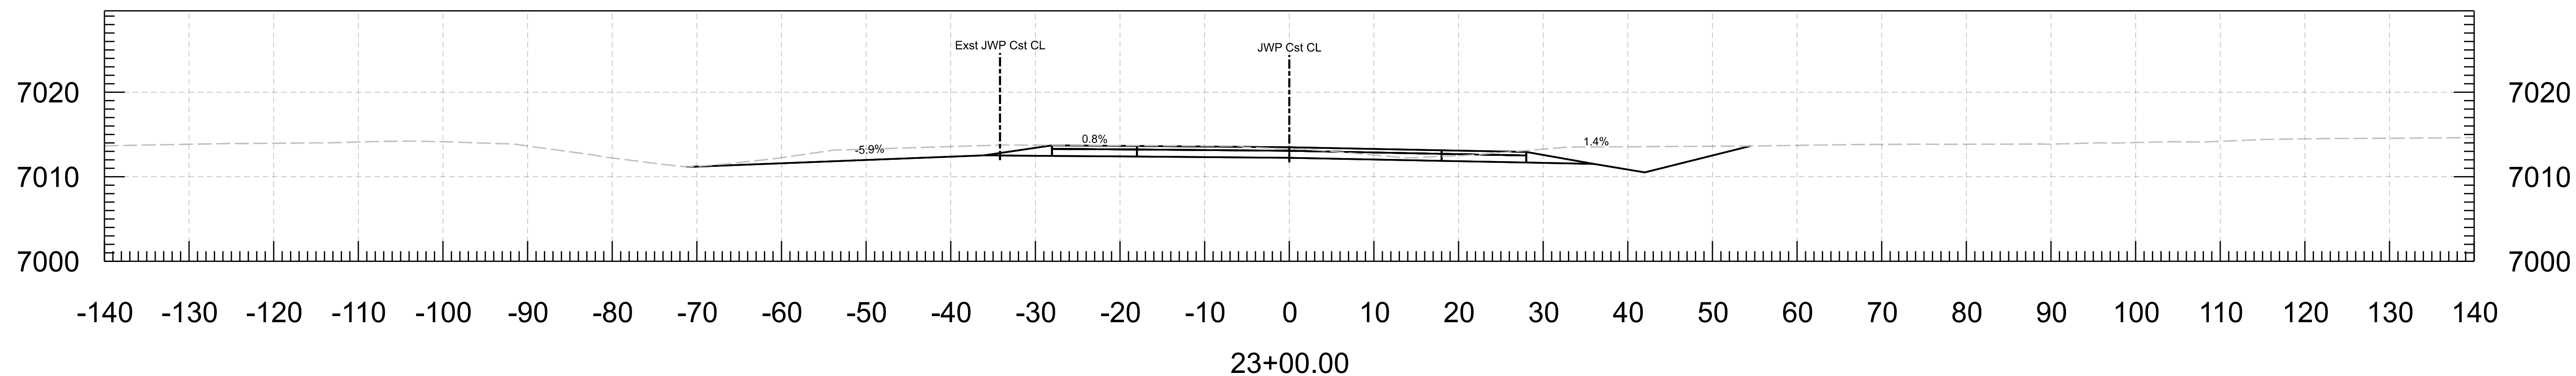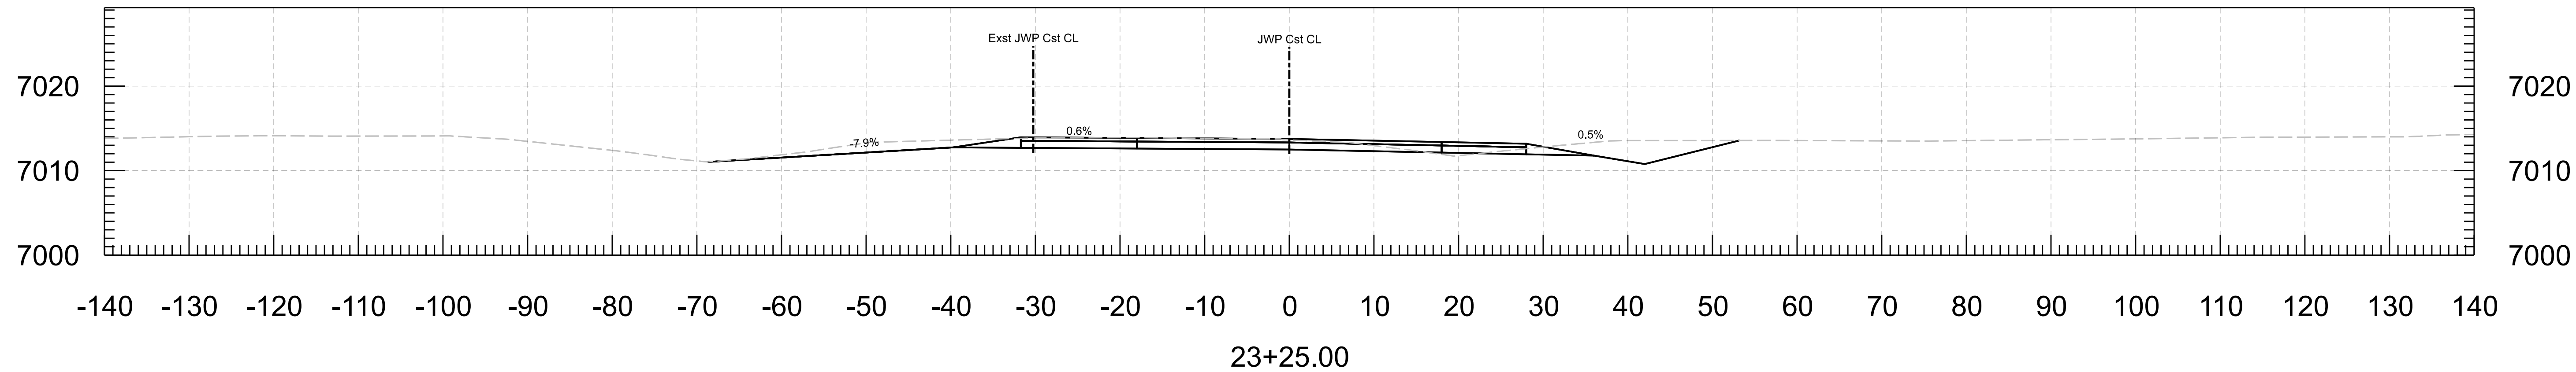


 <p>Contact Arizona 811 at least two full working days before you begin excavation Call 811 or click Arizona811.com</p>	<table border="1"> <thead> <tr> <th>DESIGN</th> <th>NAME</th> <th>DATE</th> </tr> </thead> <tbody> <tr> <td>J.NOYES</td> <td>J.NOYES</td> <td>10/23</td> </tr> <tr> <td>DRAWN</td> <td>J.NOYES</td> <td>10/23</td> </tr> <tr> <td>CHECKED</td> <td>L.BUSENBARK</td> <td>10/23</td> </tr> </tbody> </table>	DESIGN	NAME	DATE	J.NOYES	J.NOYES	10/23	DRAWN	J.NOYES	10/23	CHECKED	L.BUSENBARK	10/23	<p>ARIZONA DEPARTMENT OF TRANSPORTATION INFRASTRUCTURE DELIVERY AND OPERATIONS DIVISION ROADWAY DESIGN SECTION</p>	<table border="1"> <tr> <td>ROUTE</td> <td>I-17</td> </tr> <tr> <td>MILEPOST</td> <td>337.39</td> </tr> <tr> <td>STRUCTURE NO.</td> <td></td> </tr> </table>	ROUTE	I-17	MILEPOST	337.39	STRUCTURE NO.		<table border="1"> <tr> <td>F.H.W.A. Arizona Division</td> <td>STATE</td> <td>ARIZ.</td> <td>PROJECT NO.</td> <td>017 CN 337</td> <td>FEDERAL ID NO.</td> <td>017-B(237)T</td> <td>SHEET NO.</td> <td>17</td> <td>TOTAL SHEETS</td> <td>27</td> <td>RECORD DRAWING</td> </tr> </table>	F.H.W.A. Arizona Division	STATE	ARIZ.	PROJECT NO.	017 CN 337	FEDERAL ID NO.	017-B(237)T	SHEET NO.	17	TOTAL SHEETS	27	RECORD DRAWING
	DESIGN	NAME	DATE																															
	J.NOYES	J.NOYES	10/23																															
DRAWN	J.NOYES	10/23																																
CHECKED	L.BUSENBARK	10/23																																
ROUTE	I-17																																	
MILEPOST	337.39																																	
STRUCTURE NO.																																		
F.H.W.A. Arizona Division	STATE	ARIZ.	PROJECT NO.	017 CN 337	FEDERAL ID NO.	017-B(237)T	SHEET NO.	17	TOTAL SHEETS	27	RECORD DRAWING																							
 <p>HDR, INC. 20 E. THOMAS ROAD SUITE 2500 PHOENIX, AZ 85012 TEL (602) 522-7700</p>	<p>CROSS SECTIONS JW POWELL BLVD</p>	<table border="1"> <tr> <td>LOCATION</td> <td colspan="2">I-17 AIRPORT RD TI UP</td> <td>DWG NO.</td> <td>___ OF ___</td> </tr> <tr> <td>TRACS NO.</td> <td colspan="2">F0362 01C</td> <td colspan="2"></td> </tr> </table>	LOCATION	I-17 AIRPORT RD TI UP		DWG NO.	___ OF ___	TRACS NO.	F0362 01C																									
LOCATION	I-17 AIRPORT RD TI UP		DWG NO.	___ OF ___																														
TRACS NO.	F0362 01C																																	

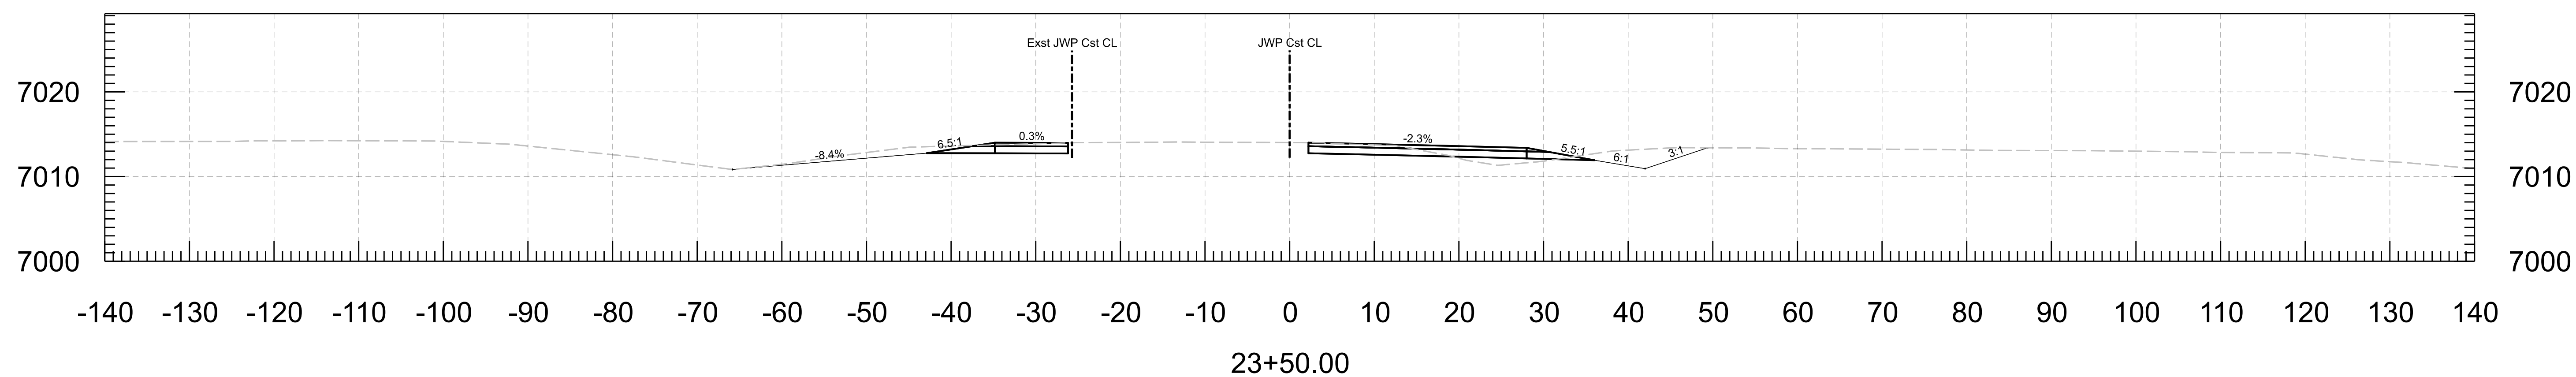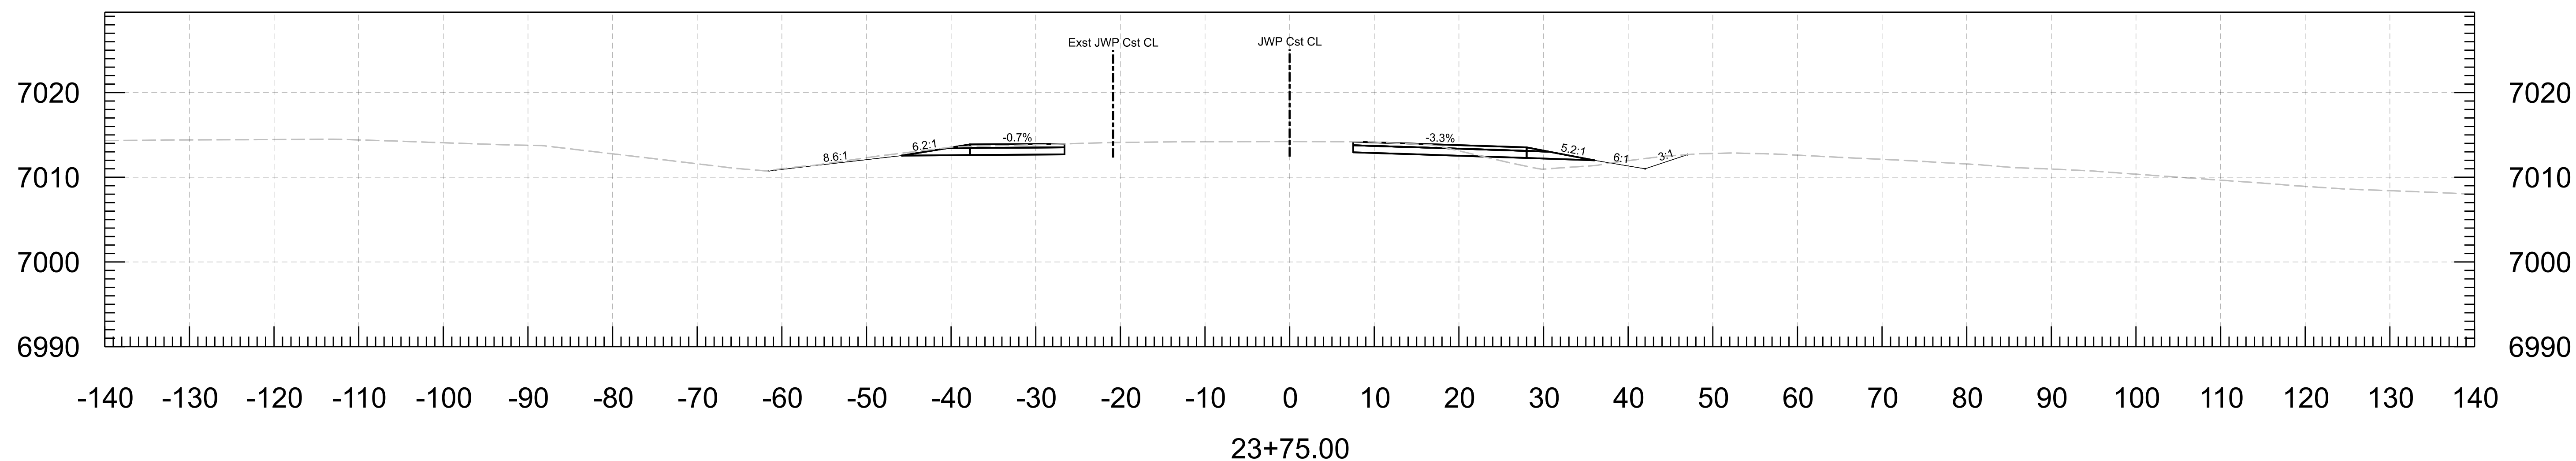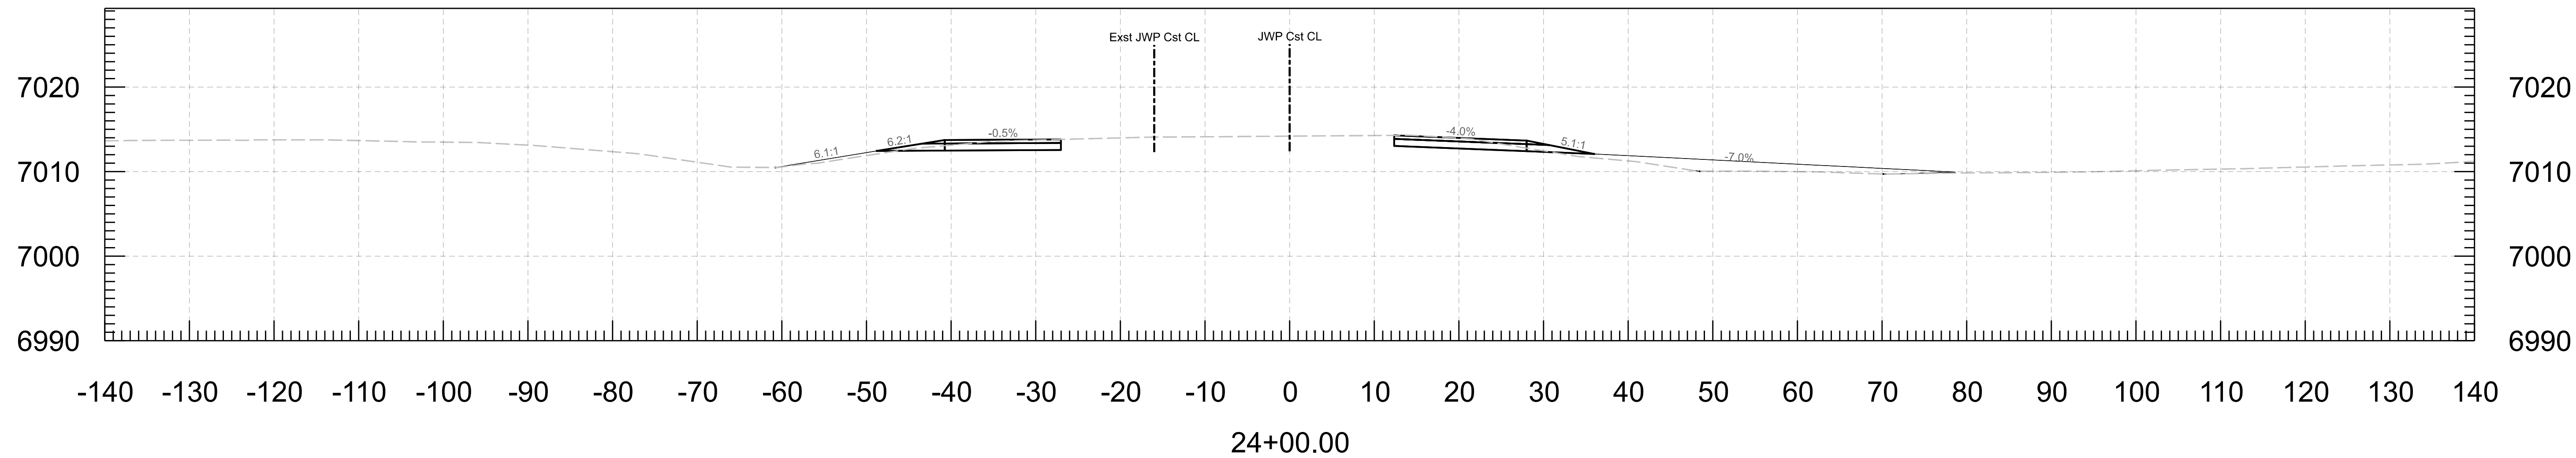


	DESIGN	J.NOYES	10/23	ARIZONA DEPARTMENT OF TRANSPORTATION INFRASTRUCTURE DELIVERY AND OPERATIONS DIVISION ROADWAY DESIGN SECTION	ROUTE	I-17	F.H.W.A. Arizona Division STATE ARIZ.	PROJECT NO.	017 CN 337	FEDERAL ID NO.	017-B(237)T	SHEET NO.	18	TOTAL SHEETS	27	RECORD DRAWING
	DRAWN	J.NOYES	10/23		MILEPOST	337.39		LOCATION	I-17 AIRPORT RD TI UP				DWG NO.	___ OF ___		
	CHECKED	L.BUSENBARK	10/23		STRUCTURE NO.			TRACS NO.	F0362 01C							
HDR, INC. 20 E. THOMAS ROAD SUITE 2500 PHOENIX, AZ 85012 TEL. (602) 522-7700				CROSS SECTIONS JW POWELL BLVD												




	DESIGN	J.NOYES	10/23	ARIZONA DEPARTMENT OF TRANSPORTATION INFRASTRUCTURE DELIVERY AND OPERATIONS DIVISION ROADWAY DESIGN SECTION	ROUTE	I-17	F.H.W.A. Arizona Division STATE ARIZ.	PROJECT NO.	017 CN 337	FEDERAL ID NO.	017-B(237)T	SHEET NO.	19	TOTAL SHEETS	27	RECORD DRAWING
	DRAWN	J.NOYES	10/23		MILEPOST	337.39		LOCATION	I-17 AIRPORT RD TI UP				DWG NO.	___ OF ___		
	CHECKED	L.BUSENBARK	10/23		STRUCTURE NO.			TRACS NO.	F0362 01C							
 HDR, INC. 20 E. THOMAS ROAD SUITE 2500 PHOENIX, AZ 85012 TEL: (602) 522-7700				CROSS SECTIONS JW POWELL BLVD												

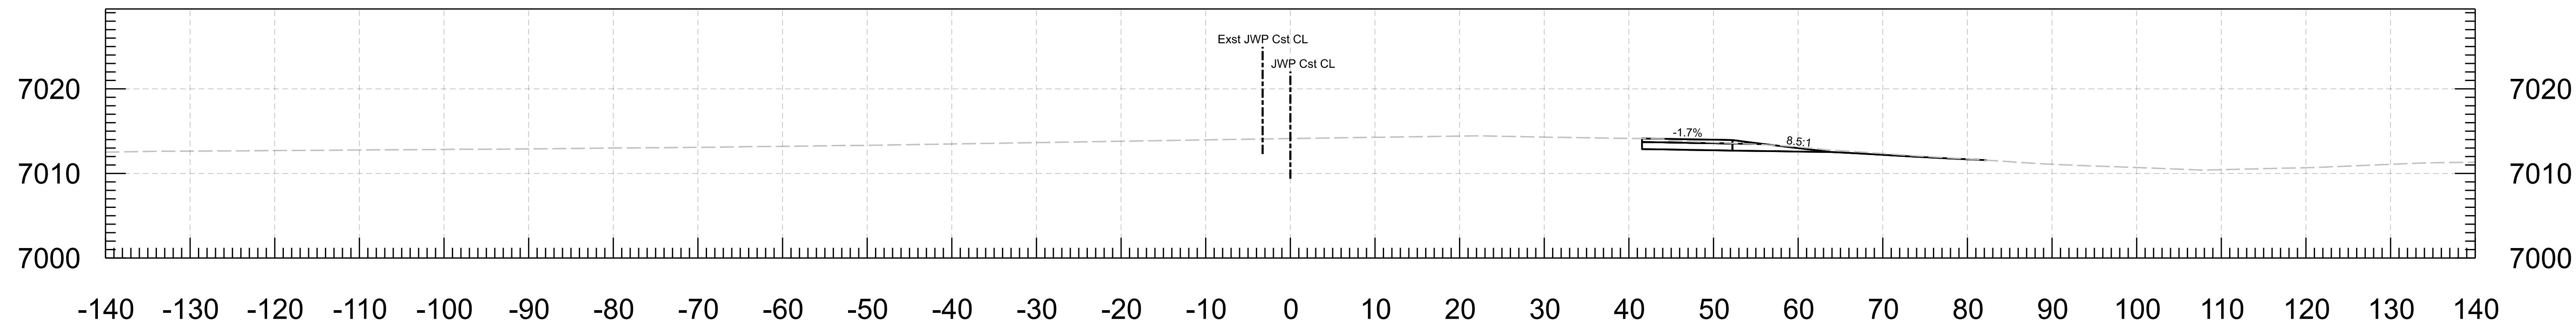

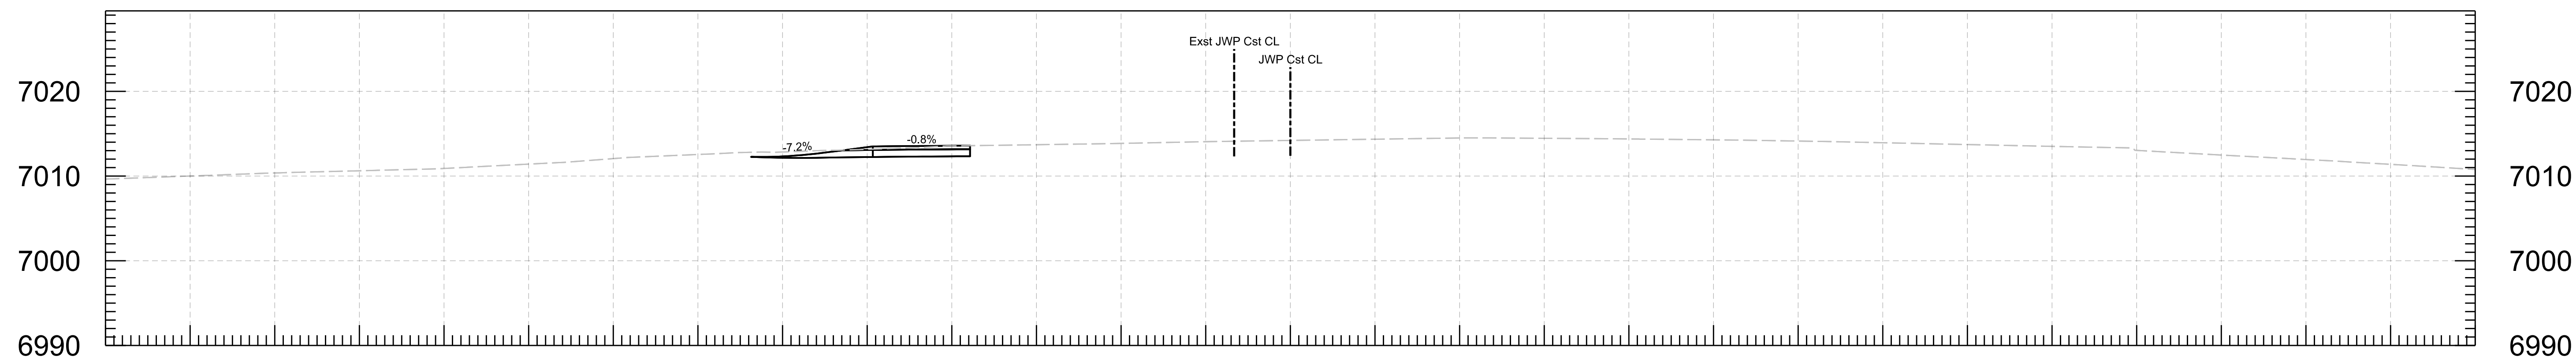

24+75.00





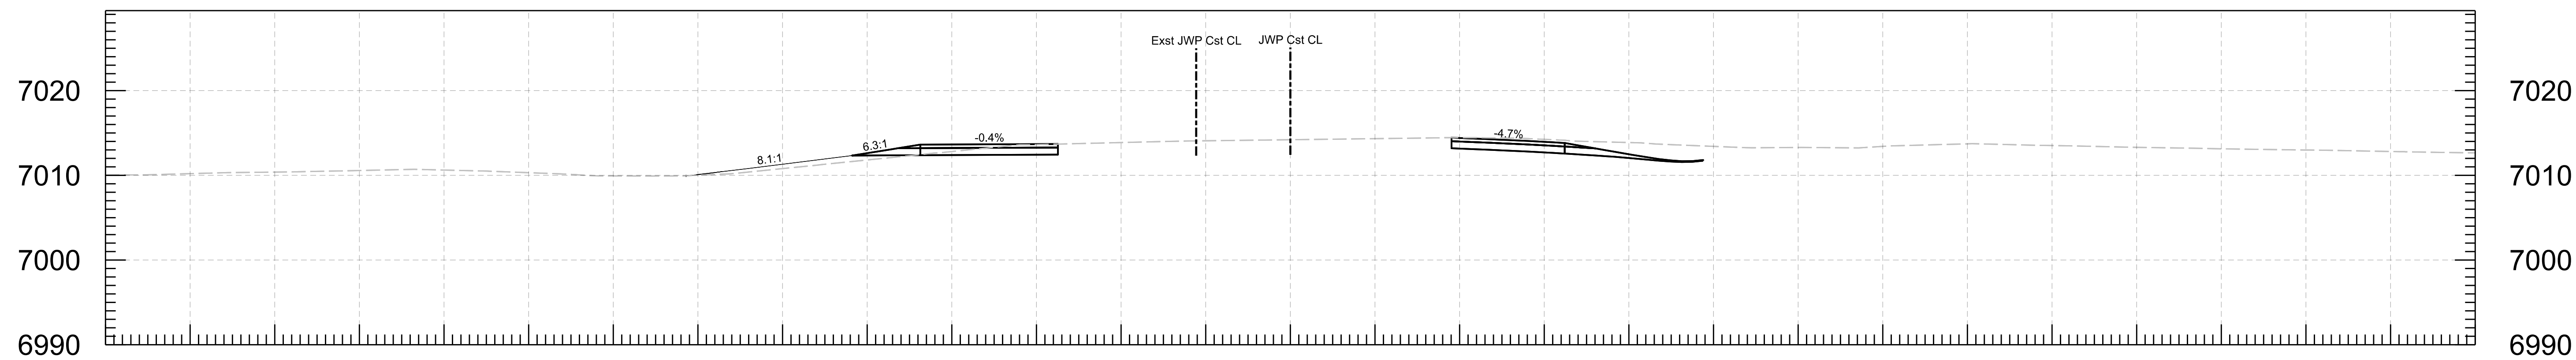

24+50.00






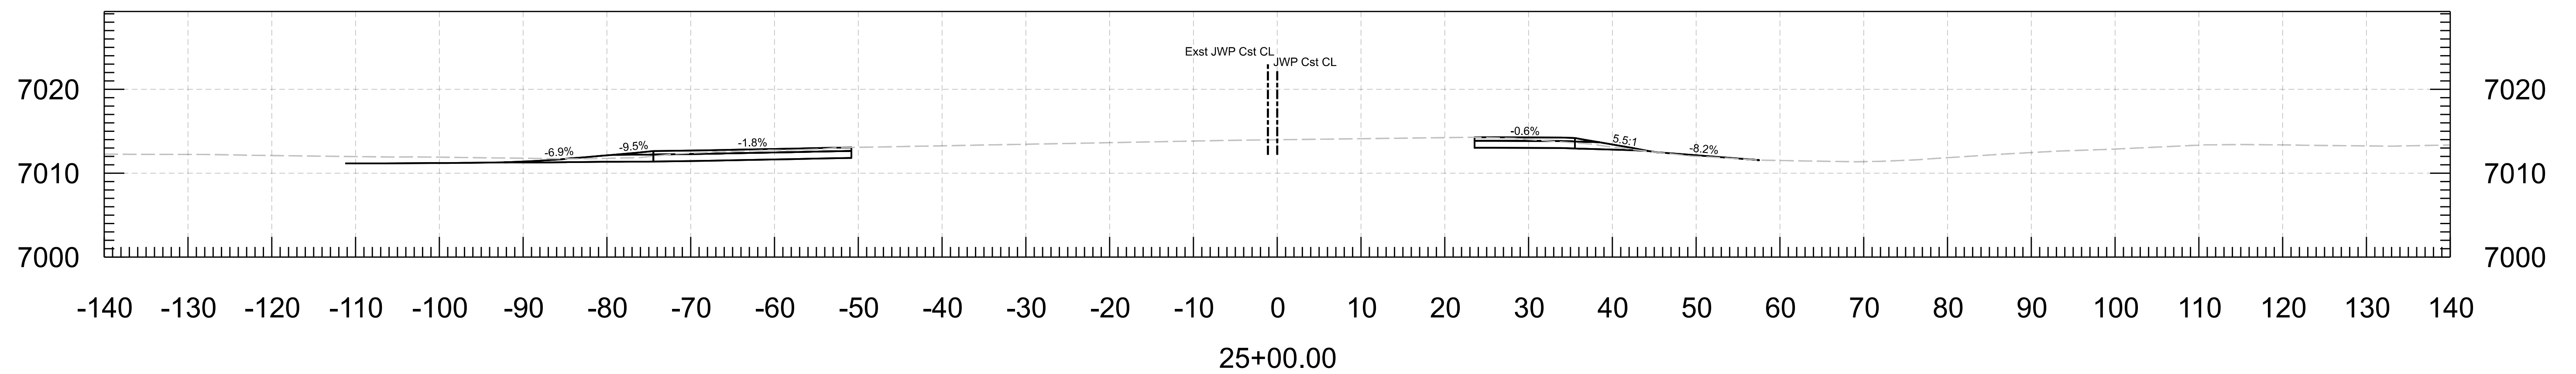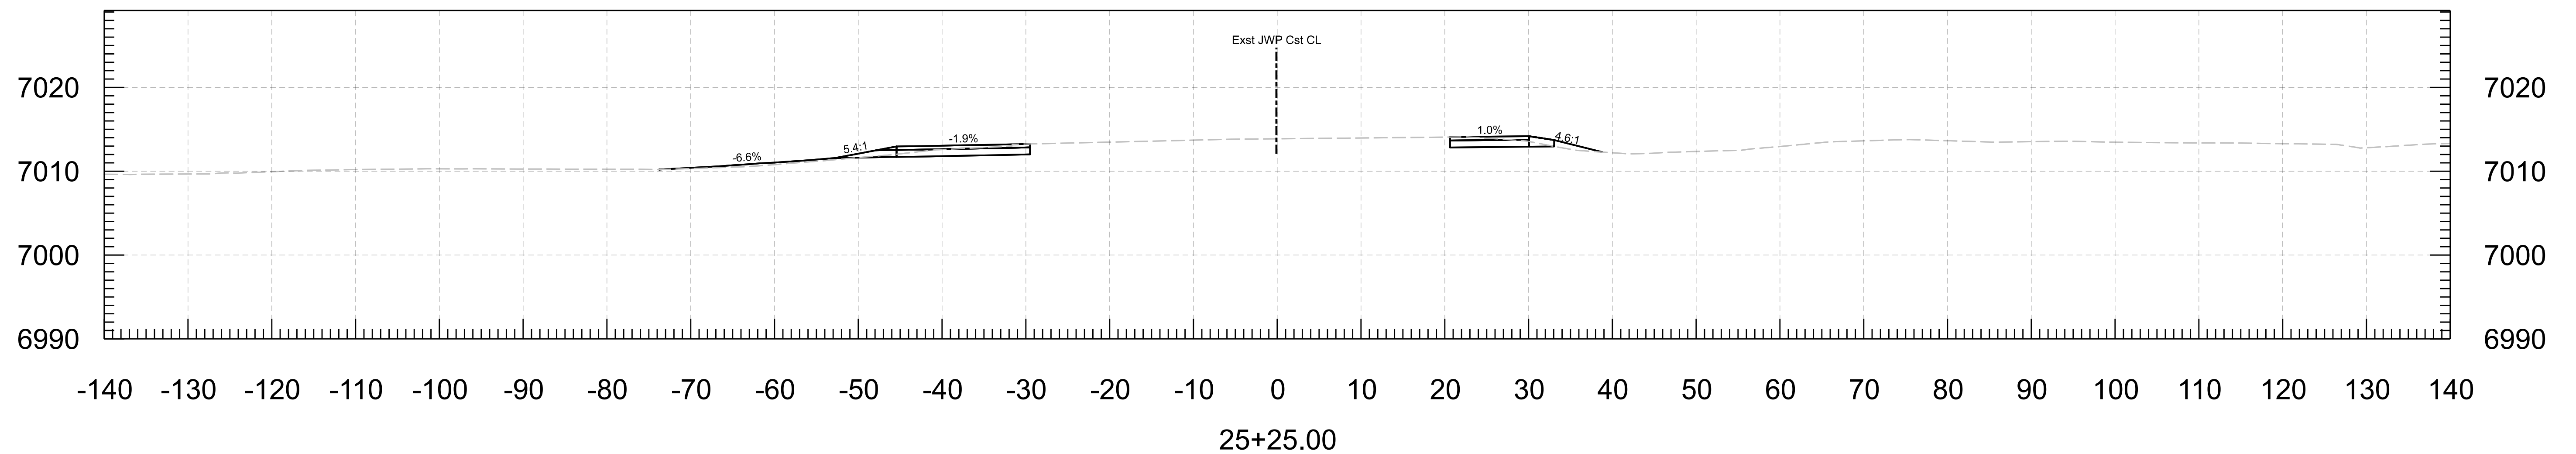

24+25.00




	DESIGN	J.NOYES	10/23	ARIZONA DEPARTMENT OF TRANSPORTATION INFRASTRUCTURE DELIVERY AND OPERATIONS DIVISION ROADWAY DESIGN SECTION	ROUTE	I-17	F.H.W.A. Arizona Division STATE ARIZ.	PROJECT NO.	017 CN 337	FEDERAL ID NO.	017-B(237)T	SHEET NO.	20	TOTAL SHEETS	27	RECORD DRAWING
	DRAWN	J.NOYES	10/23		MILEPOST	337.39		LOCATION	I-17 AIRPORT RD TI UP				DWG NO.	___ OF ___		
	CHECKED	L.BUSENBARK	10/23		STRUCTURE NO.			TRACS NO.	F0362 01C							
 HDR, INC. 20 E. THOMAS ROAD SUITE 2500 PHOENIX, AZ 85012 TEL: (602) 522-7700				CROSS SECTIONS JW POWELL BLVD												



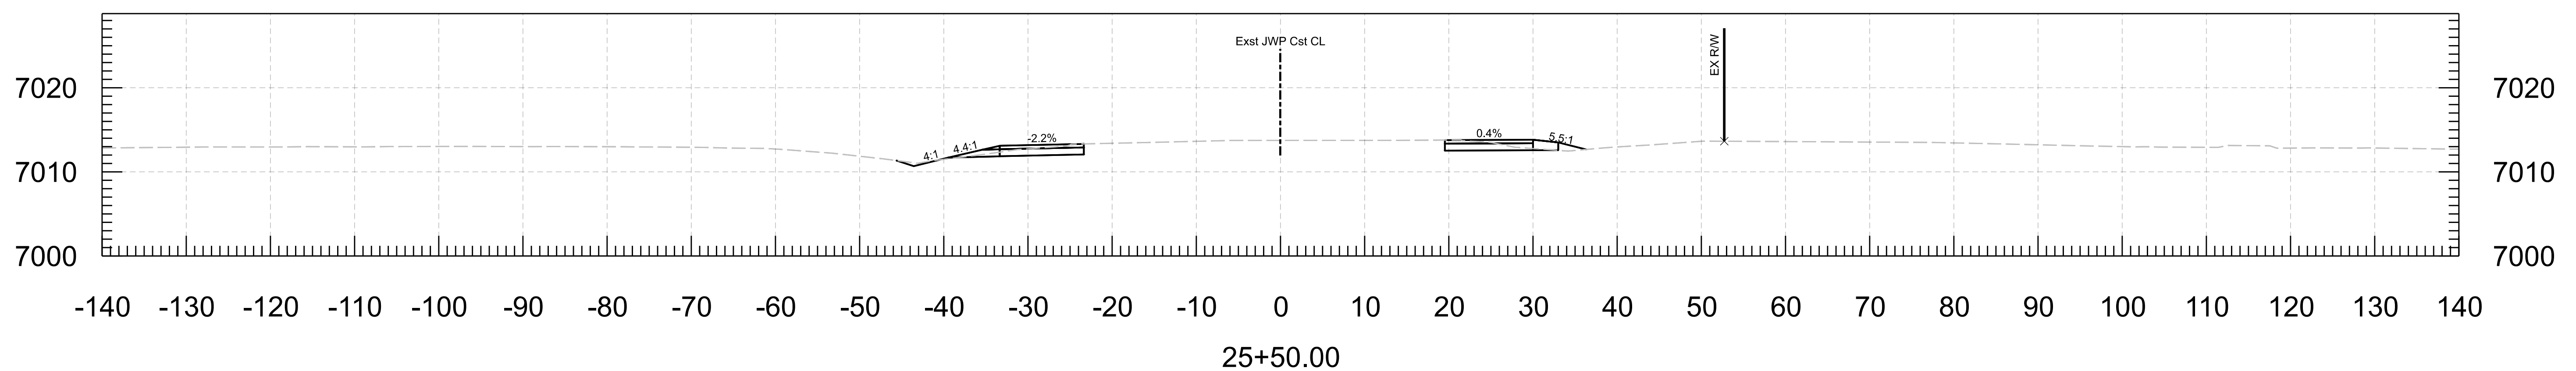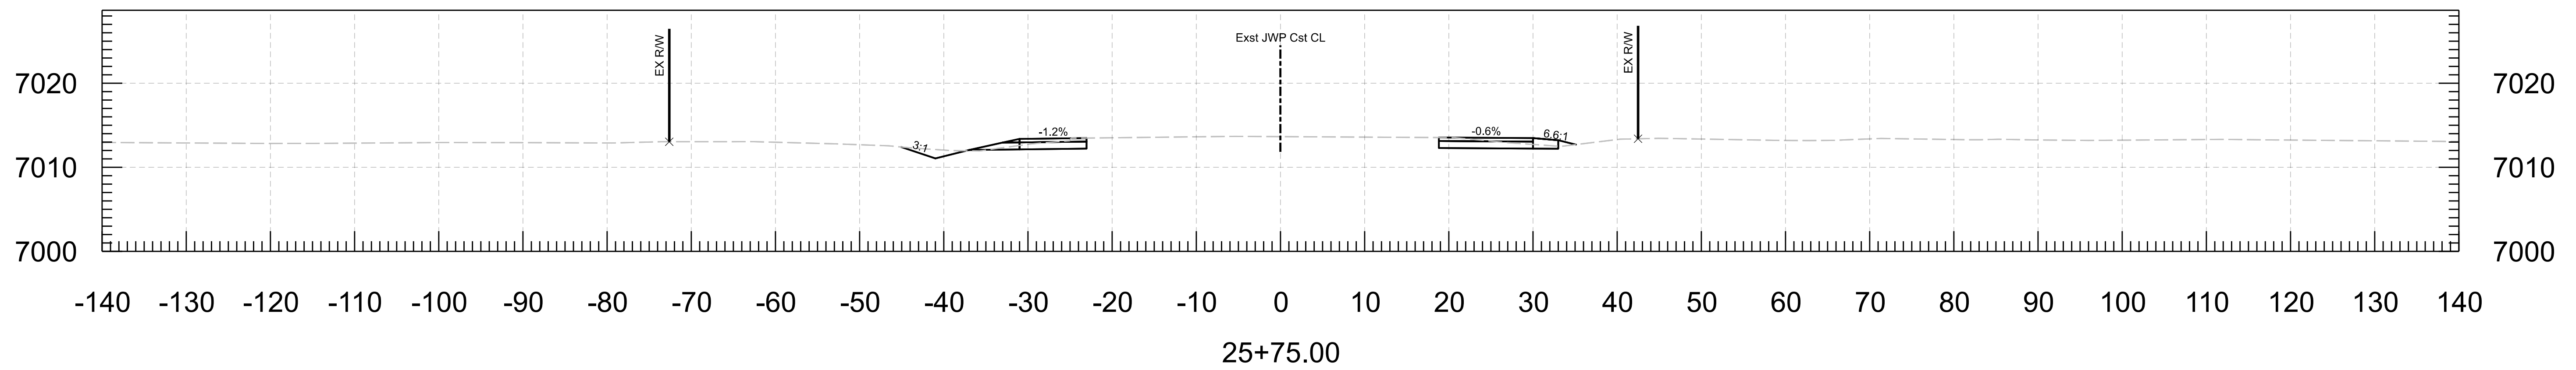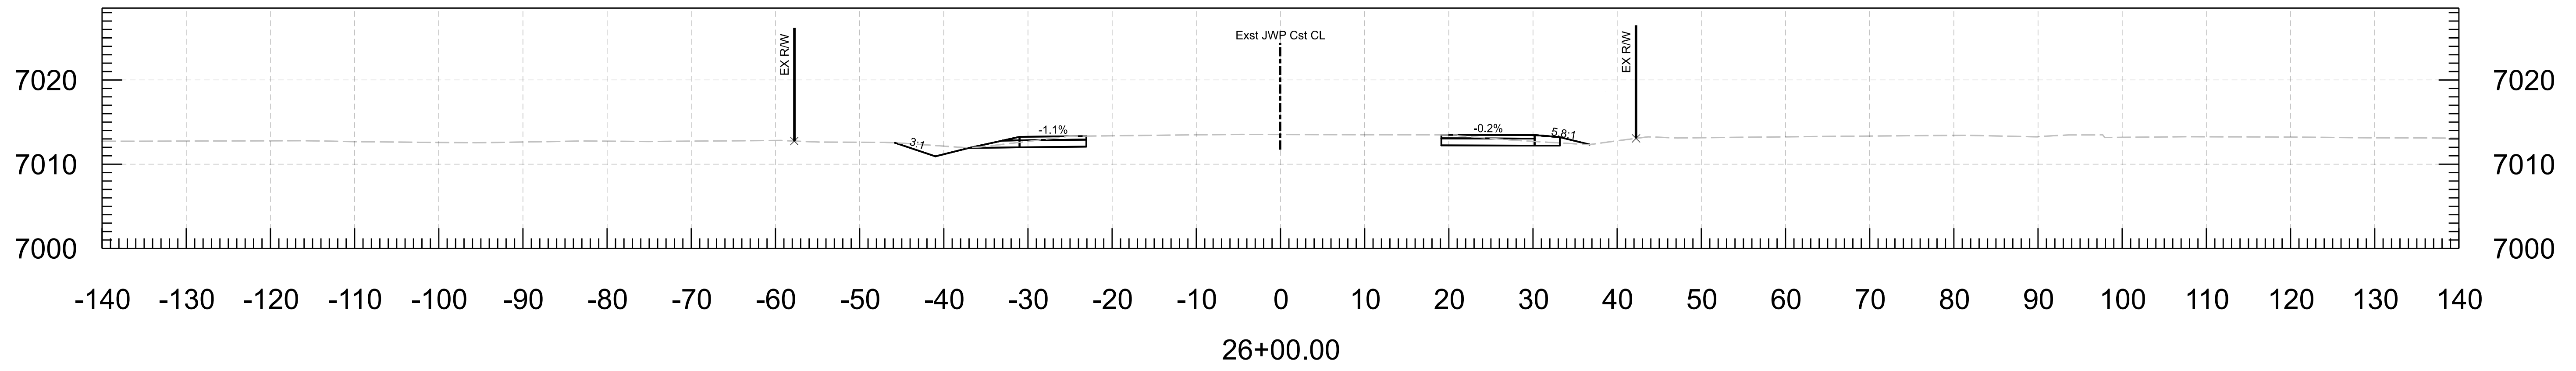



	DESIGN	J.NOYES	10/23	ARIZONA DEPARTMENT OF TRANSPORTATION INFRASTRUCTURE DELIVERY AND OPERATIONS DIVISION ROADWAY DESIGN SECTION	ROUTE	I-17	F.H.W.A. Arizona Division STATE ARIZ.	PROJECT NO.	017 CN 337	FEDERAL ID NO.	017-B(237)T	SHEET NO.	21	TOTAL SHEETS	27	RECORD DRAWING
	DRAWN	J.NOYES	10/23		MILEPOST	337.39		LOCATION	I-17 AIRPORT RD TI UP				DWG NO.	___ OF ___		
	CHECKED	L.BUSENBARK	10/23		STRUCTURE NO.			TRACS NO.	F0362 01C							
 HDR, INC. 20 E. THOMAS ROAD SUITE 2500 PHOENIX, AZ 85012 TEL (602) 522-7700				CROSS SECTIONS JW POWELL BLVD												



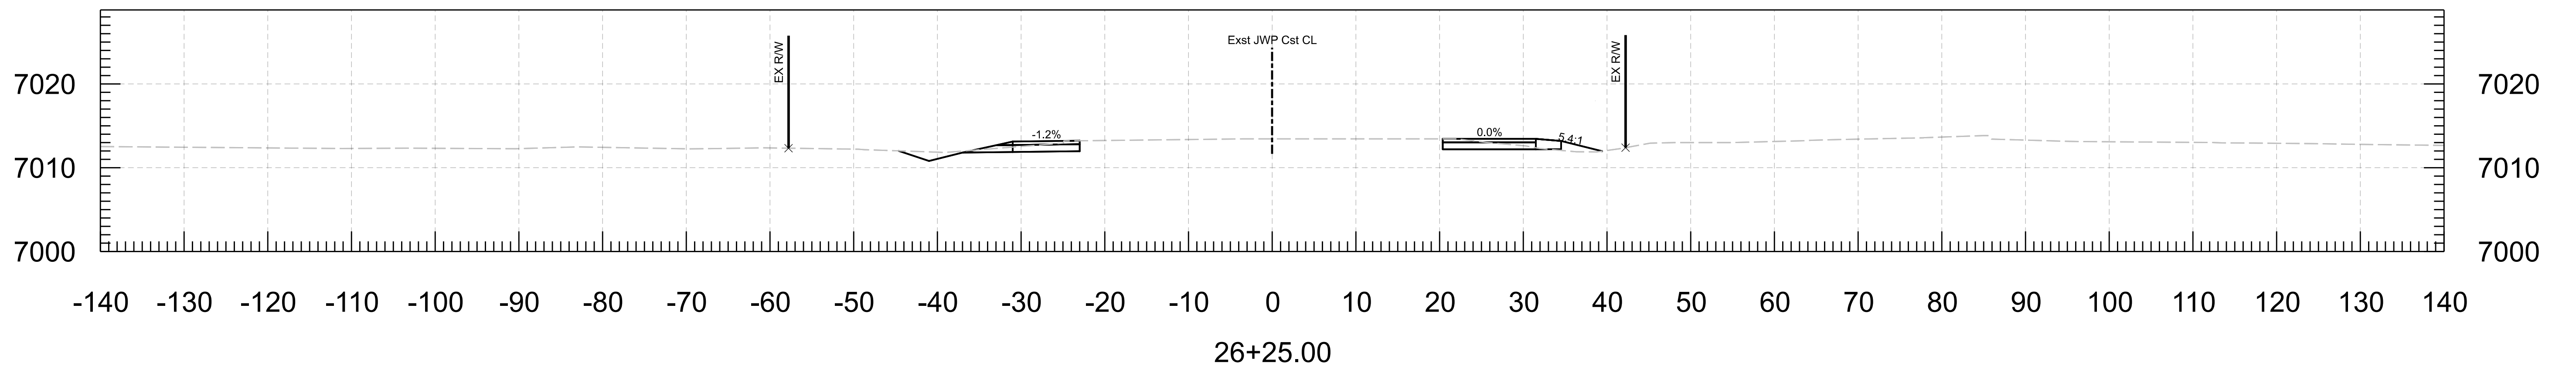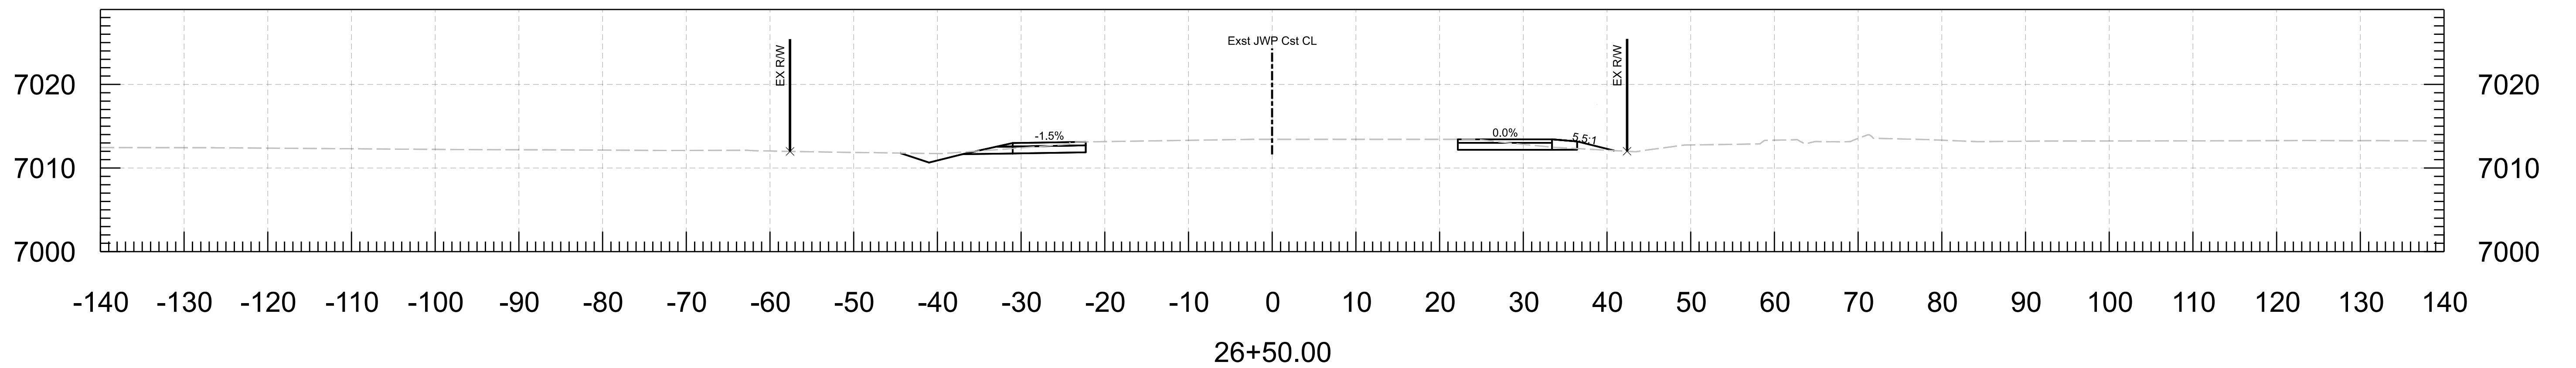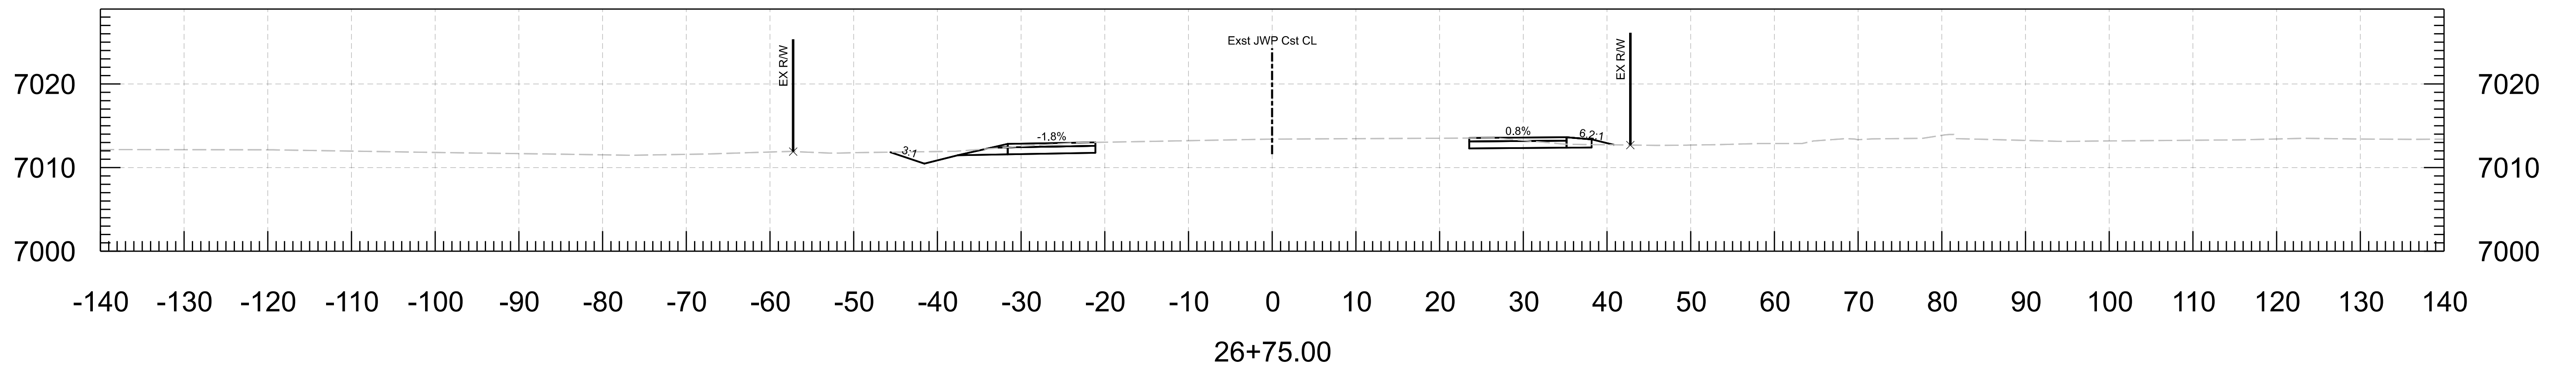




	DESIGN	J.NOYES	10/23	ARIZONA DEPARTMENT OF TRANSPORTATION INFRASTRUCTURE DELIVERY AND OPERATIONS DIVISION ROADWAY DESIGN SECTION	ROUTE	I-17	F.H.W.A. Arizona Division STATE ARIZ.	PROJECT NO.	017 CN 337	FEDERAL ID NO.	017-B(237)T	SHEET NO.	22	TOTAL SHEETS	27	RECORD DRAWING
	DRAWN	J.NOYES	10/23		MILEPOST	337.39		LOCATION	I-17 AIRPORT RD TI UP				DWG NO.	___ OF ___		
	CHECKED	L.BUSENBARK	10/23		STRUCTURE NO.			TRACS NO.	F0362 01C							
 HDR, INC. 20 E. THOMAS ROAD SUITE 2500 PHOENIX, AZ 85012 TEL (602) 522-7700				CROSS SECTIONS EXST JW POWELL BLVD												

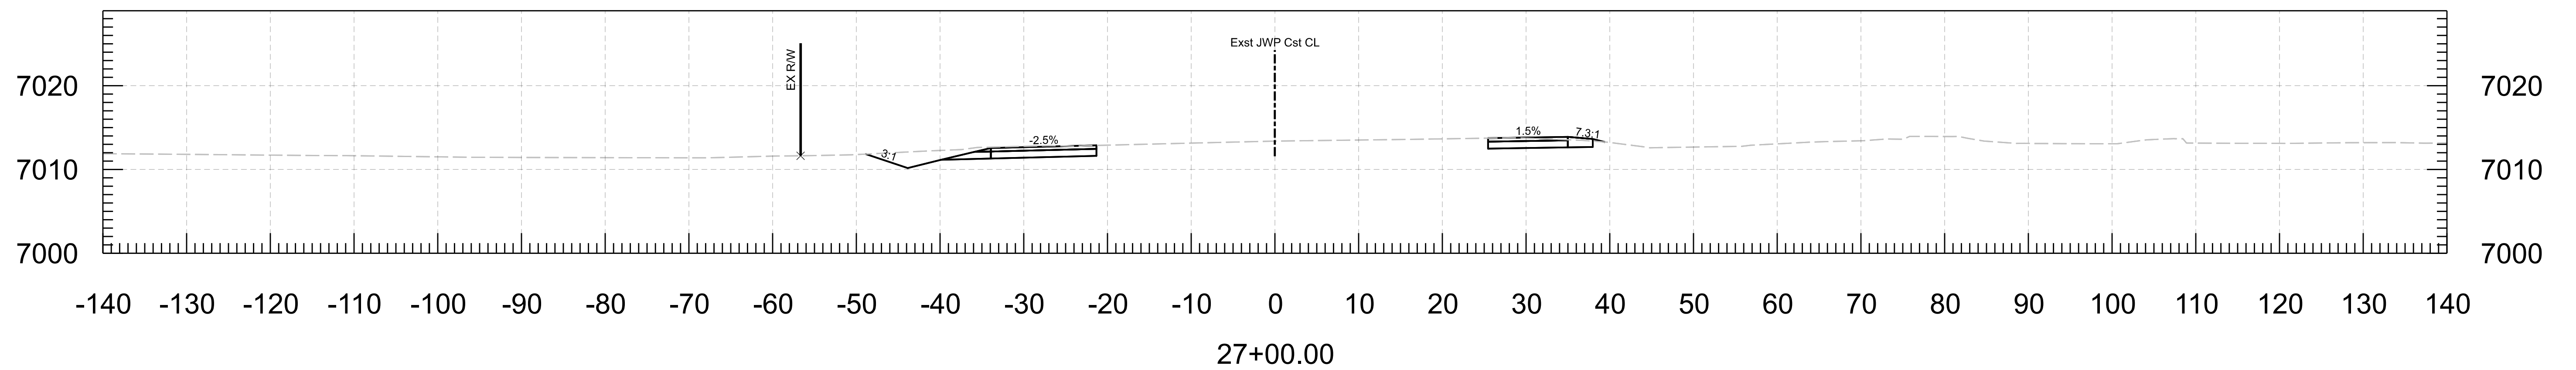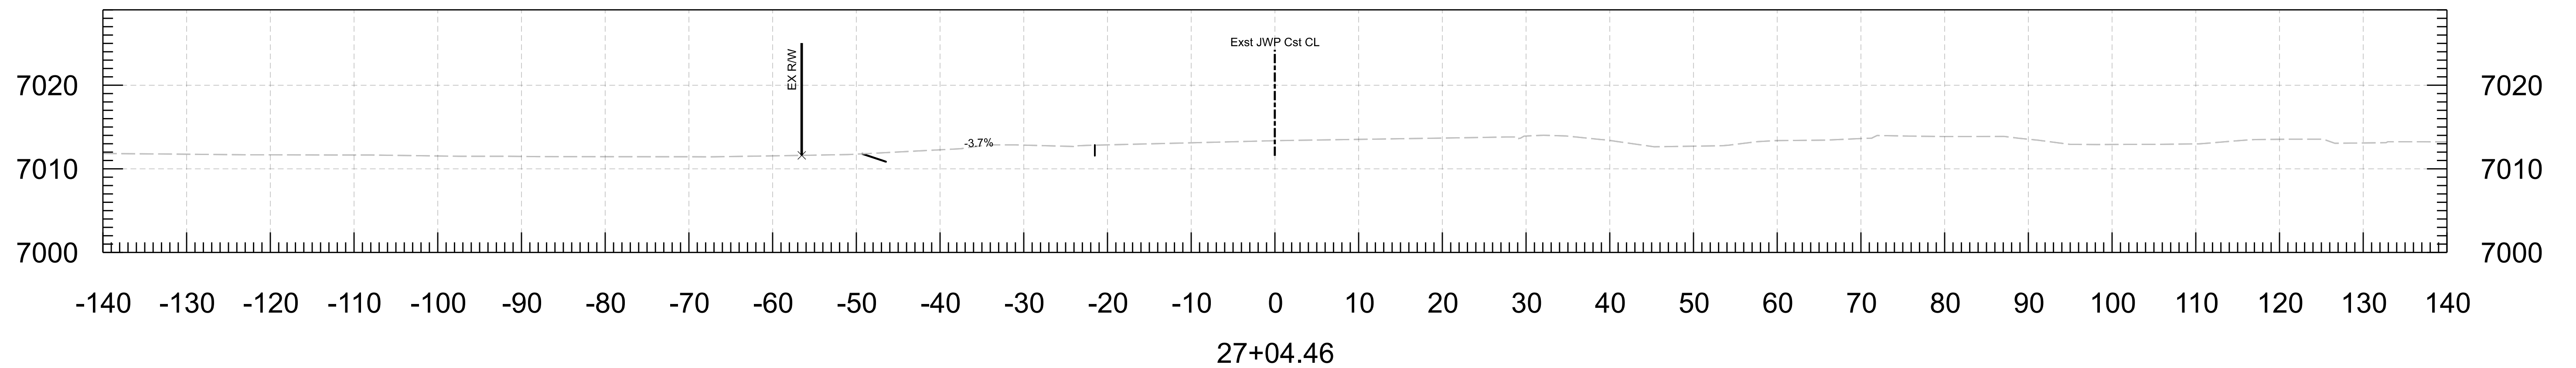

	DESIGN	J.NOYES	10/23	ARIZONA DEPARTMENT OF TRANSPORTATION INFRASTRUCTURE DELIVERY AND OPERATIONS DIVISION ROADWAY DESIGN SECTION	ROUTE	I-17	F.H.W.A. Arizona Division STATE ARIZ.	PROJECT NO.	017 CN 337	FEDERAL ID NO.	017-B(237)T	SHEET NO.	23	TOTAL SHEETS	27	RECORD DRAWING
	DRAWN	J.NOYES	10/23		MILEPOST	337.39		LOCATION	I-17 AIRPORT RD TI UP				DWG NO.	___ OF ___		
	CHECKED	L.BUSENBARK	10/23		STRUCTURE NO.			TRACS NO.	F0362 01C							
 HDR, INC. 20 E. THOMAS ROAD SUITE 2500 PHOENIX, AZ 85012 TEL: (602) 522-7700				CROSS SECTIONS EXST JW POWELL BLVD												



	DESIGN	J.NOYES	10/23	ARIZONA DEPARTMENT OF TRANSPORTATION INFRASTRUCTURE DELIVERY AND OPERATIONS DIVISION ROADWAY DESIGN SECTION	ROUTE	I-17	F.H.W.A. Arizona Division STATE ARIZ.	PROJECT NO.	017 CN 337	FEDERAL ID NO.	017-B(237)T	SHEET NO.	24	TOTAL SHEETS	27	RECORD DRAWING
	DRAWN	J.NOYES	10/23		MILEPOST	337.39		LOCATION	I-17 AIRPORT RD TI UP				DWG NO.	___ OF ___		
	CHECKED	L.BUSENBARK	10/23		STRUCTURE NO.			TRACS NO.	F0362 01C							
 HDR, INC. 20 E. THOMAS ROAD SUITE 2500 PHOENIX, AZ 85012 TEL (602) 522-7700				CROSS SECTIONS EXST JW POWELL BLVD												




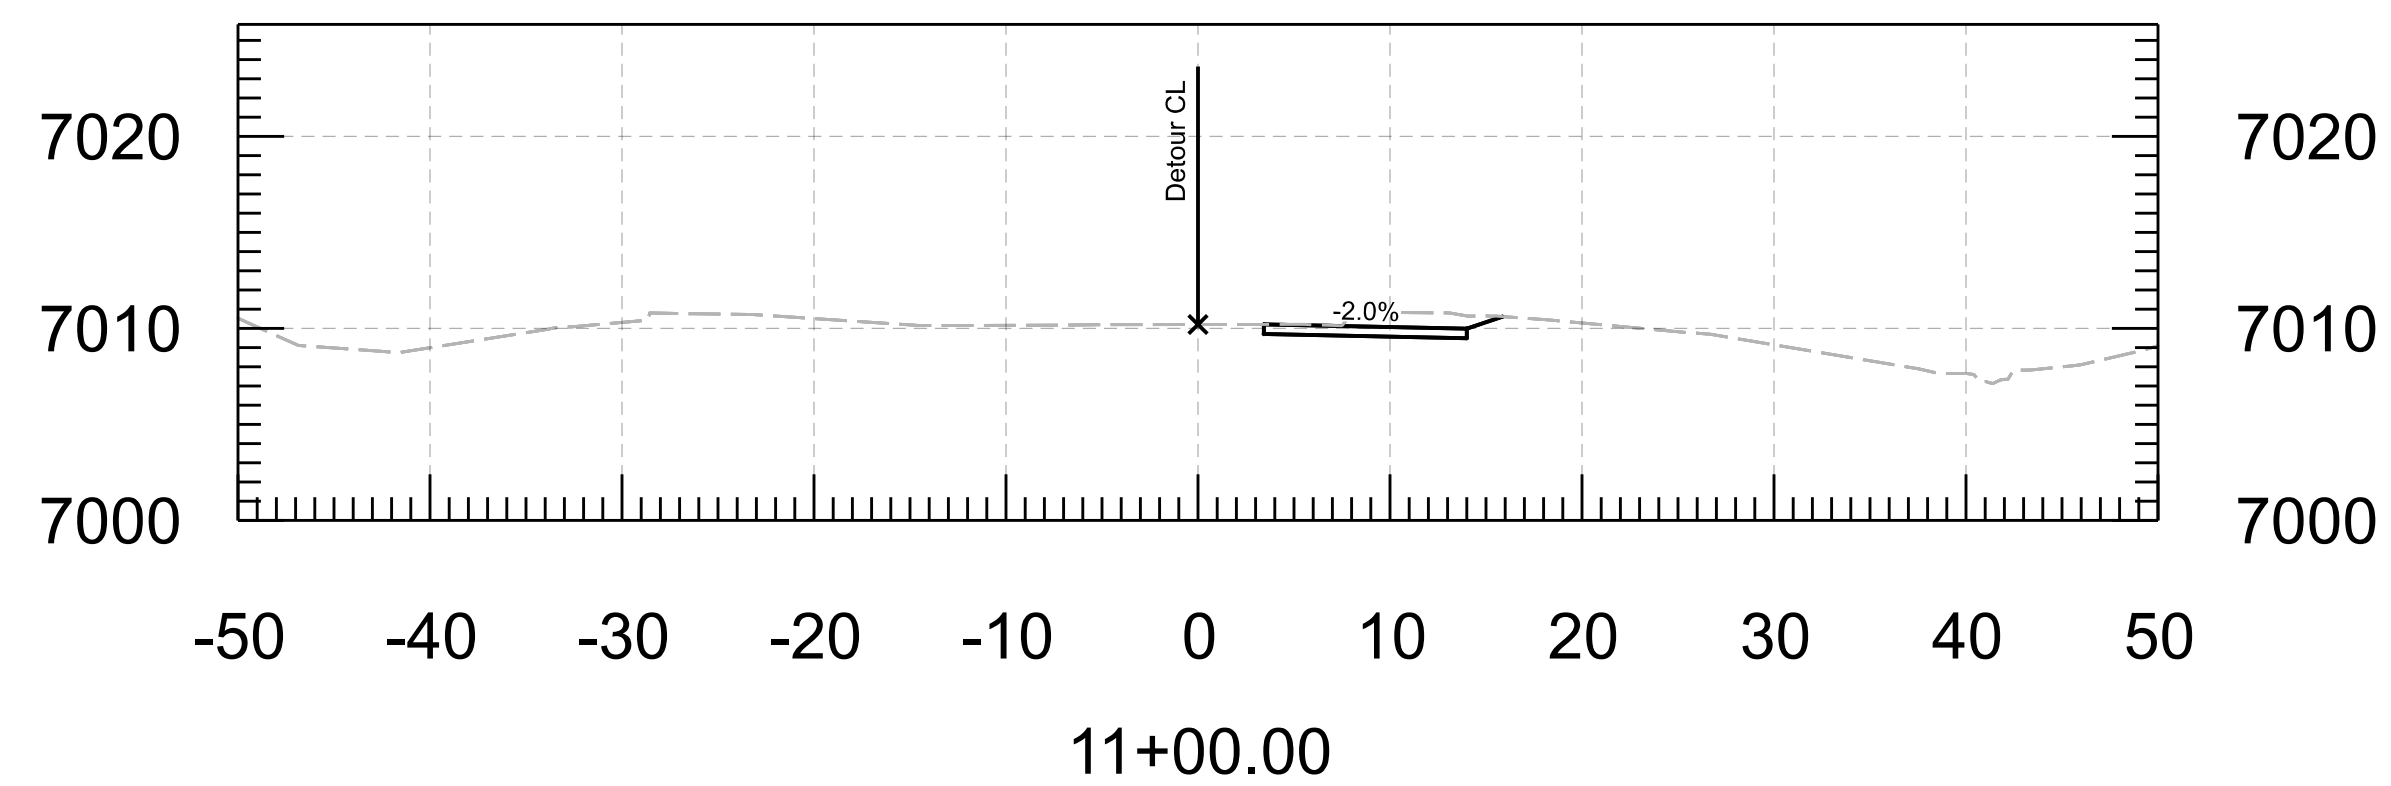
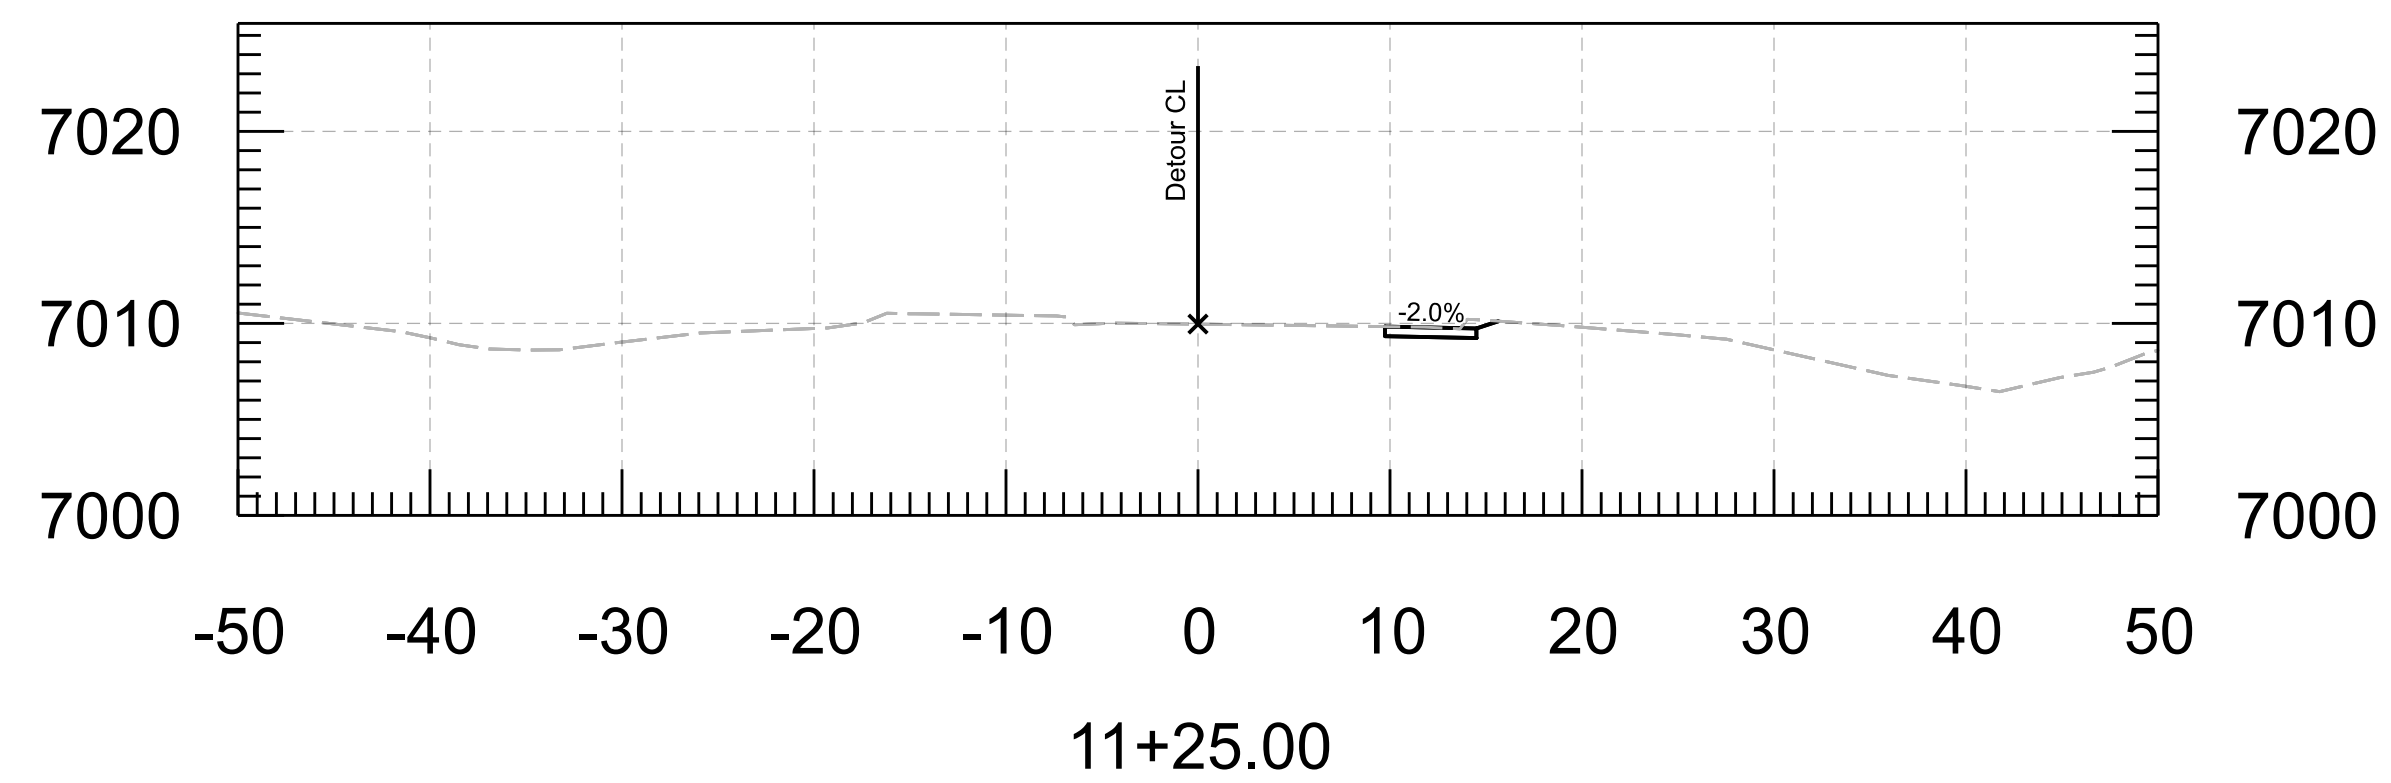
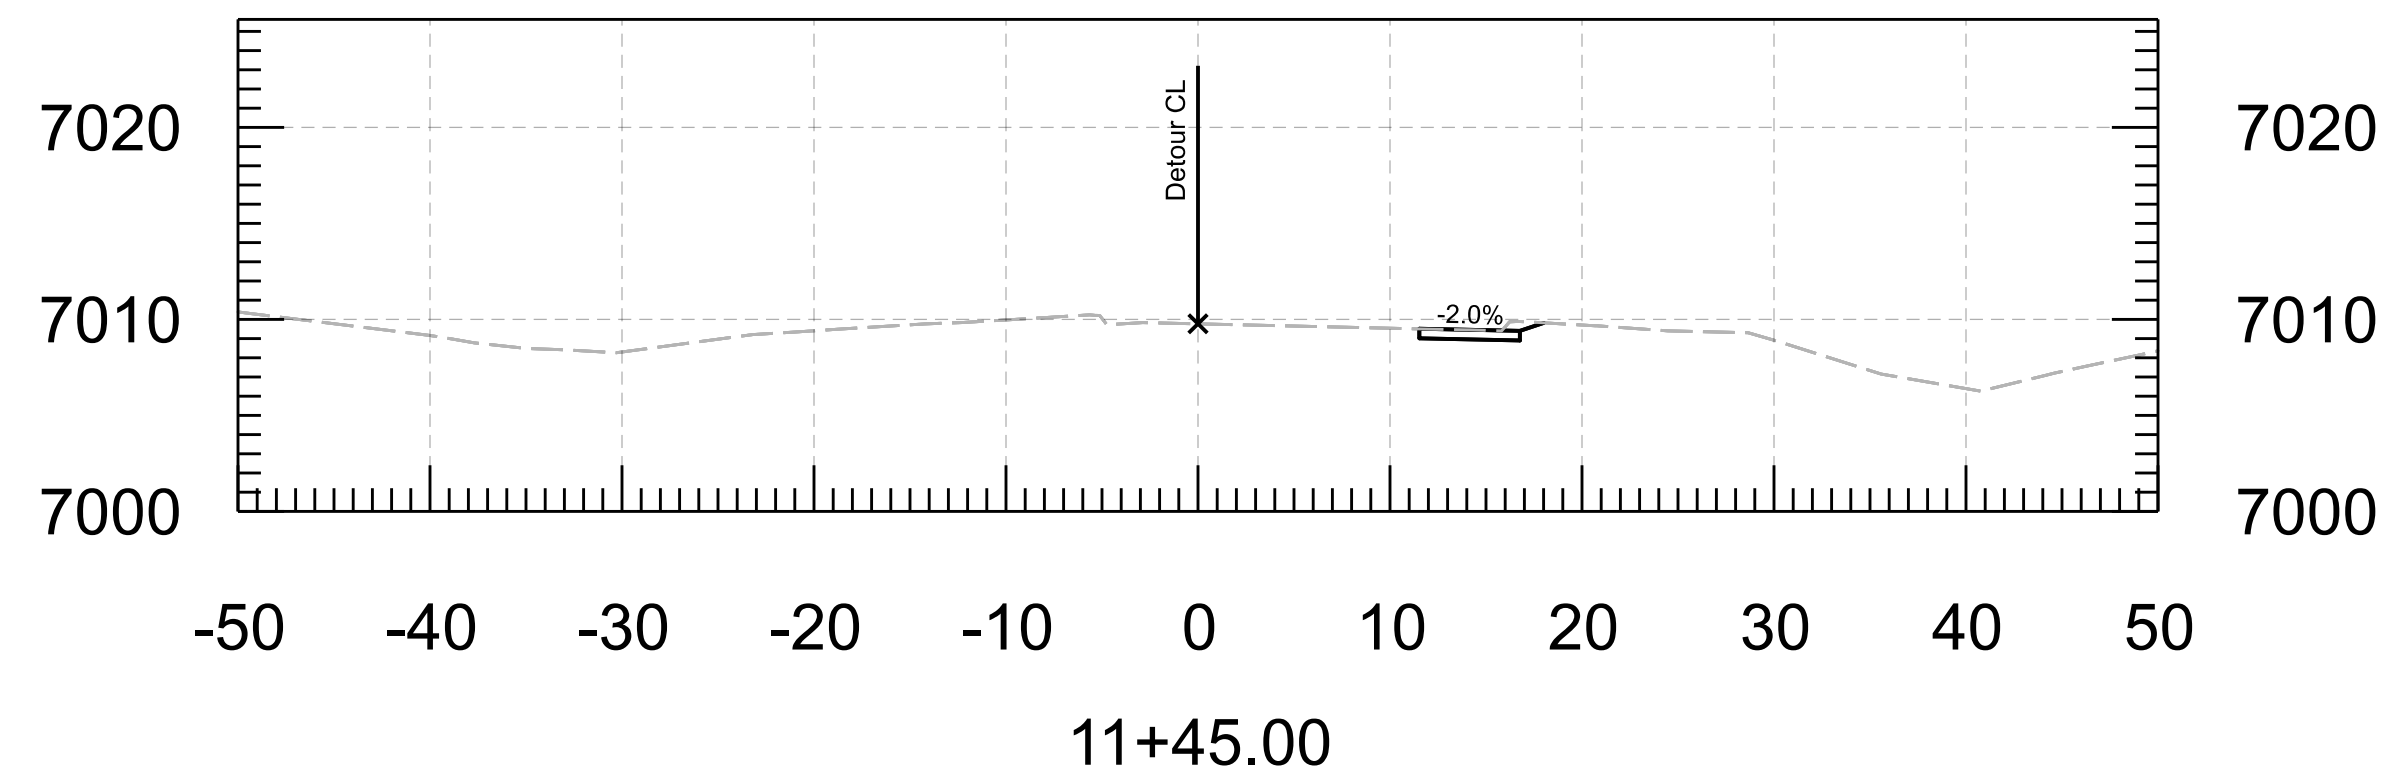


	NAME	DATE
DESIGN	J.NOYES	10/23
DRAWN	J.NOYES	10/23
CHECKED	L.BUSENBARK	10/23

HDR
 HDR, INC.
 20 E. THOMAS ROAD
 SUITE 2500
 PHOENIX, AZ 85012
 TEL: (602) 522-7700

ARIZONA DEPARTMENT OF TRANSPORTATION
 INFRASTRUCTURE DELIVERY AND OPERATIONS DIVISION
 ROADWAY DESIGN SECTION

ROUTE I-17	F.H.W.A. Arizona Division	STATE ARIZ.	PROJECT NO. 017 CN 337	FEDERAL ID NO. 017-B(237)T	SHEET NO. 27	TOTAL SHEETS 27	RECORD DRAWING
MILEPOST 337.39	LOCATION I-17 AIRPORT RD TI UP					DWG NO. ___ OF ___	
STRUCTURE NO.	TRACS NO. F0362 01C						

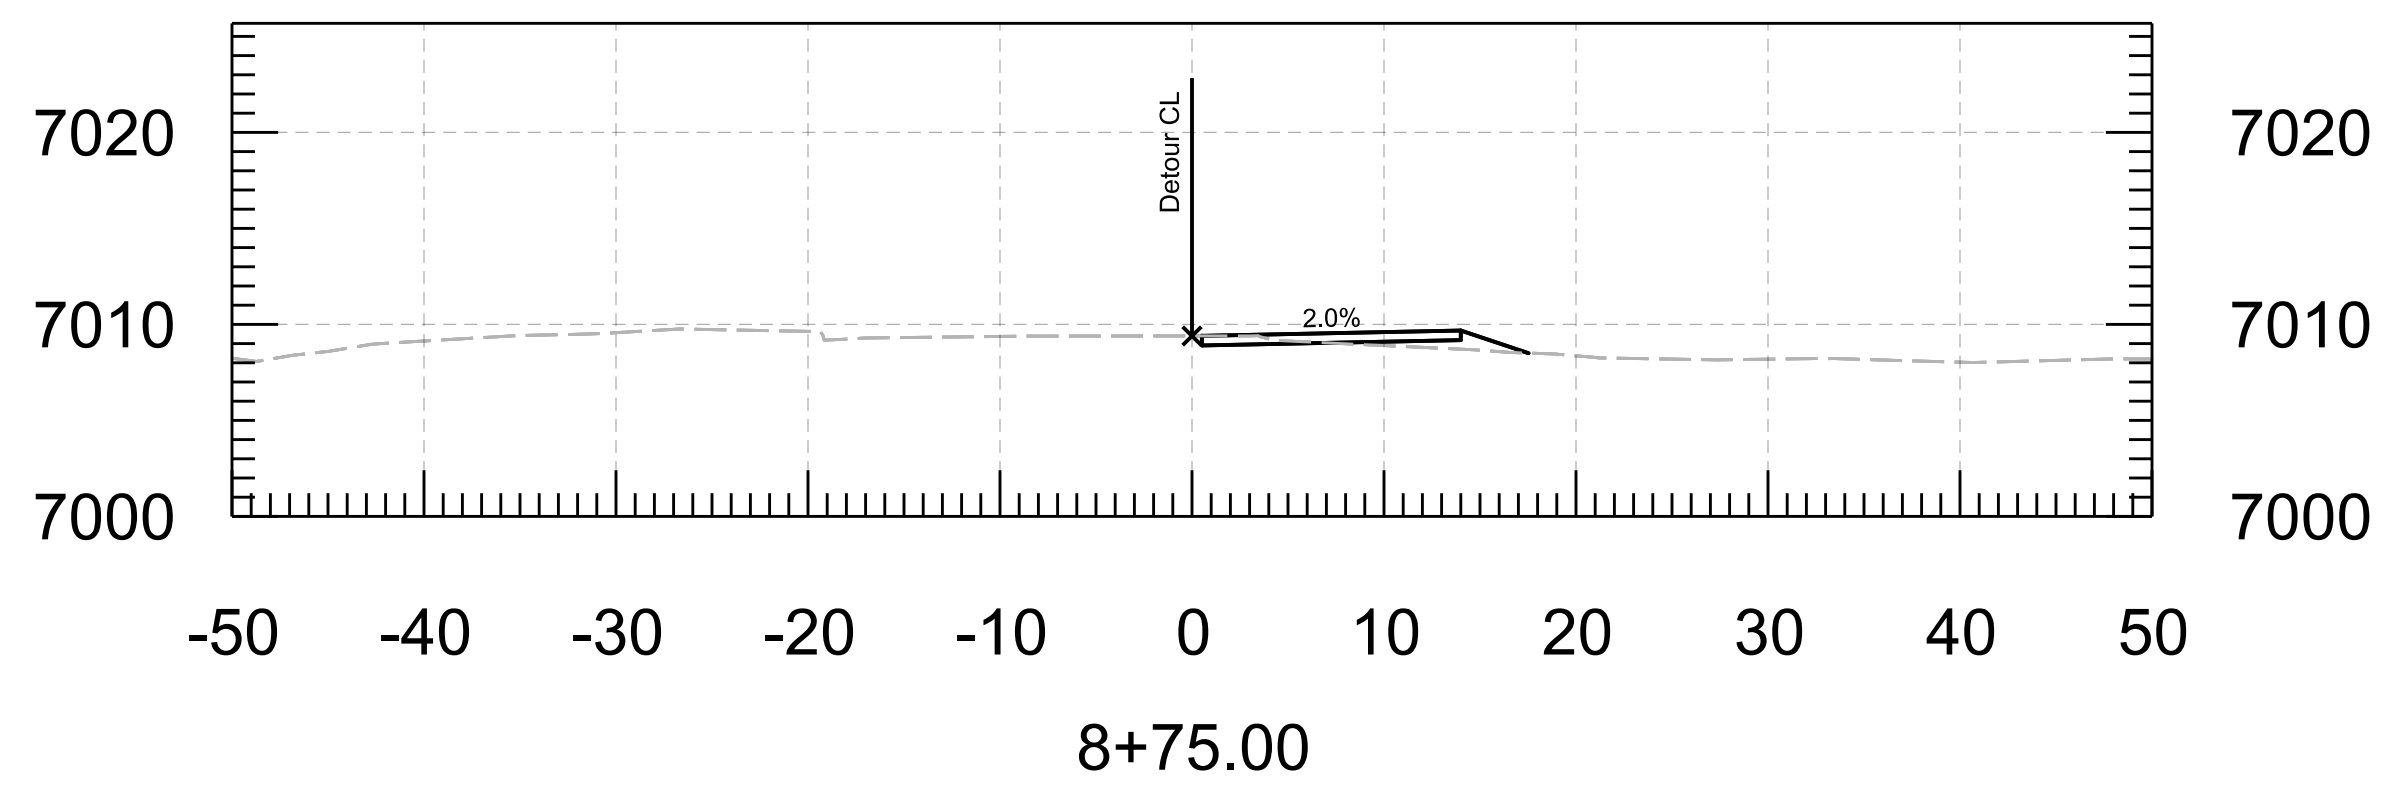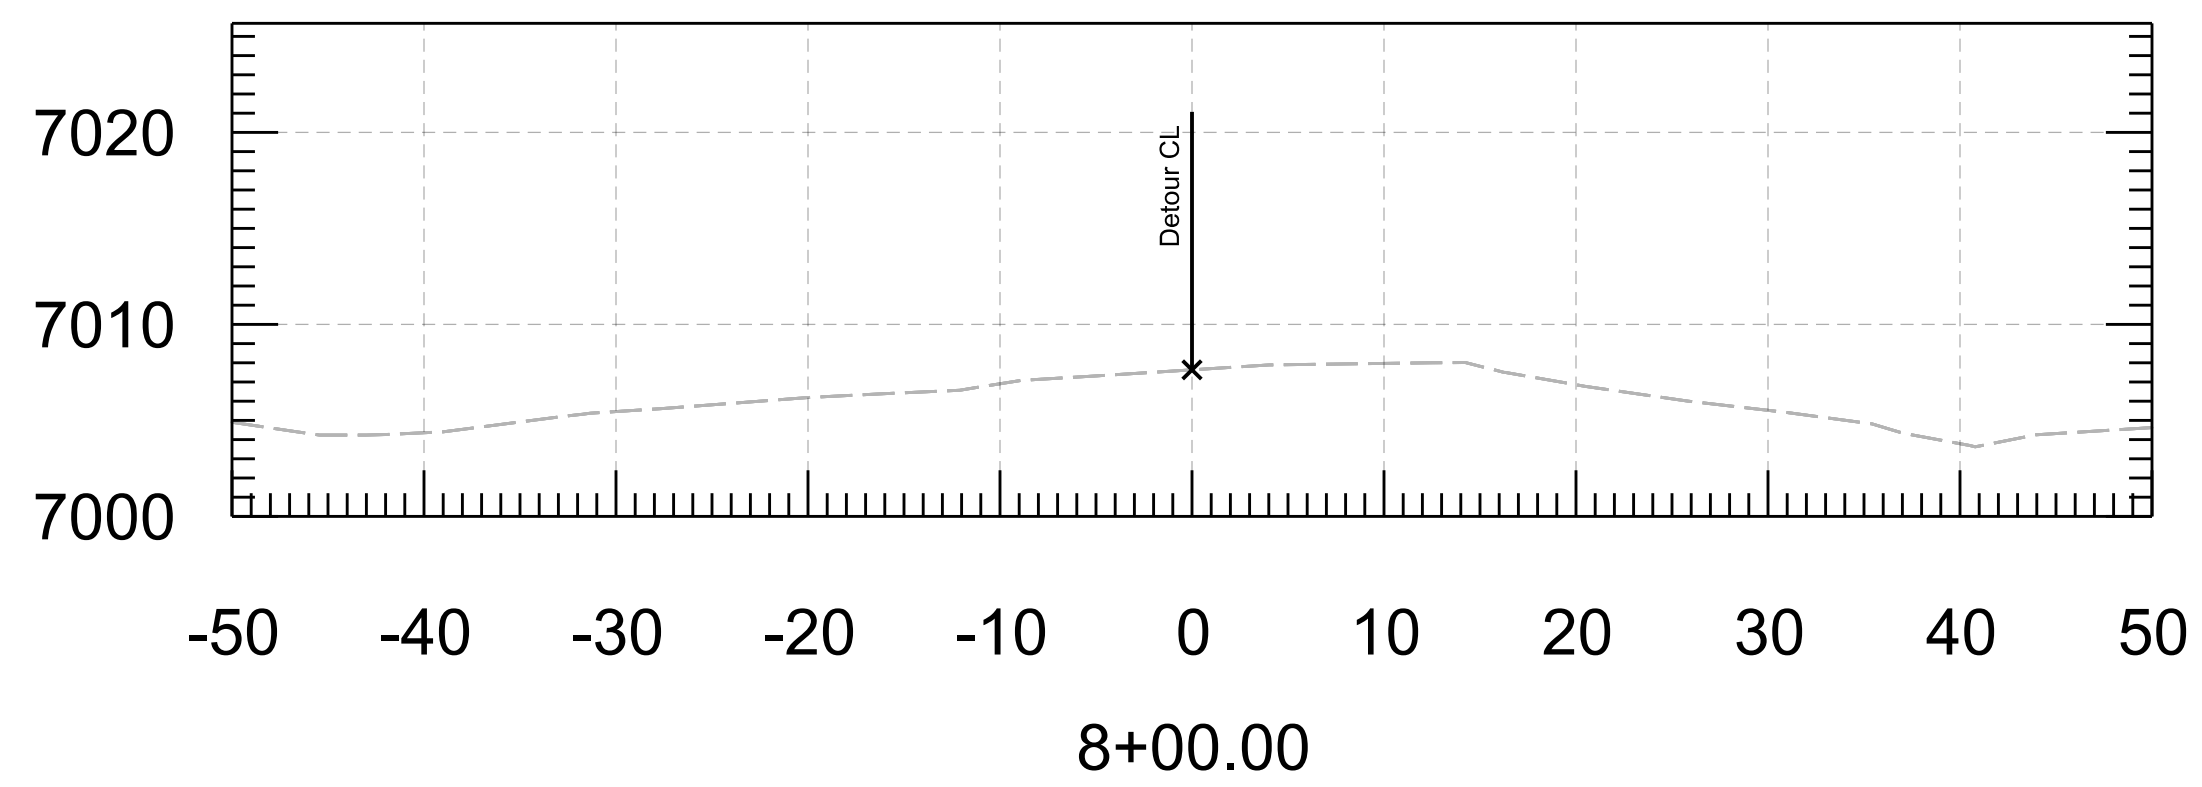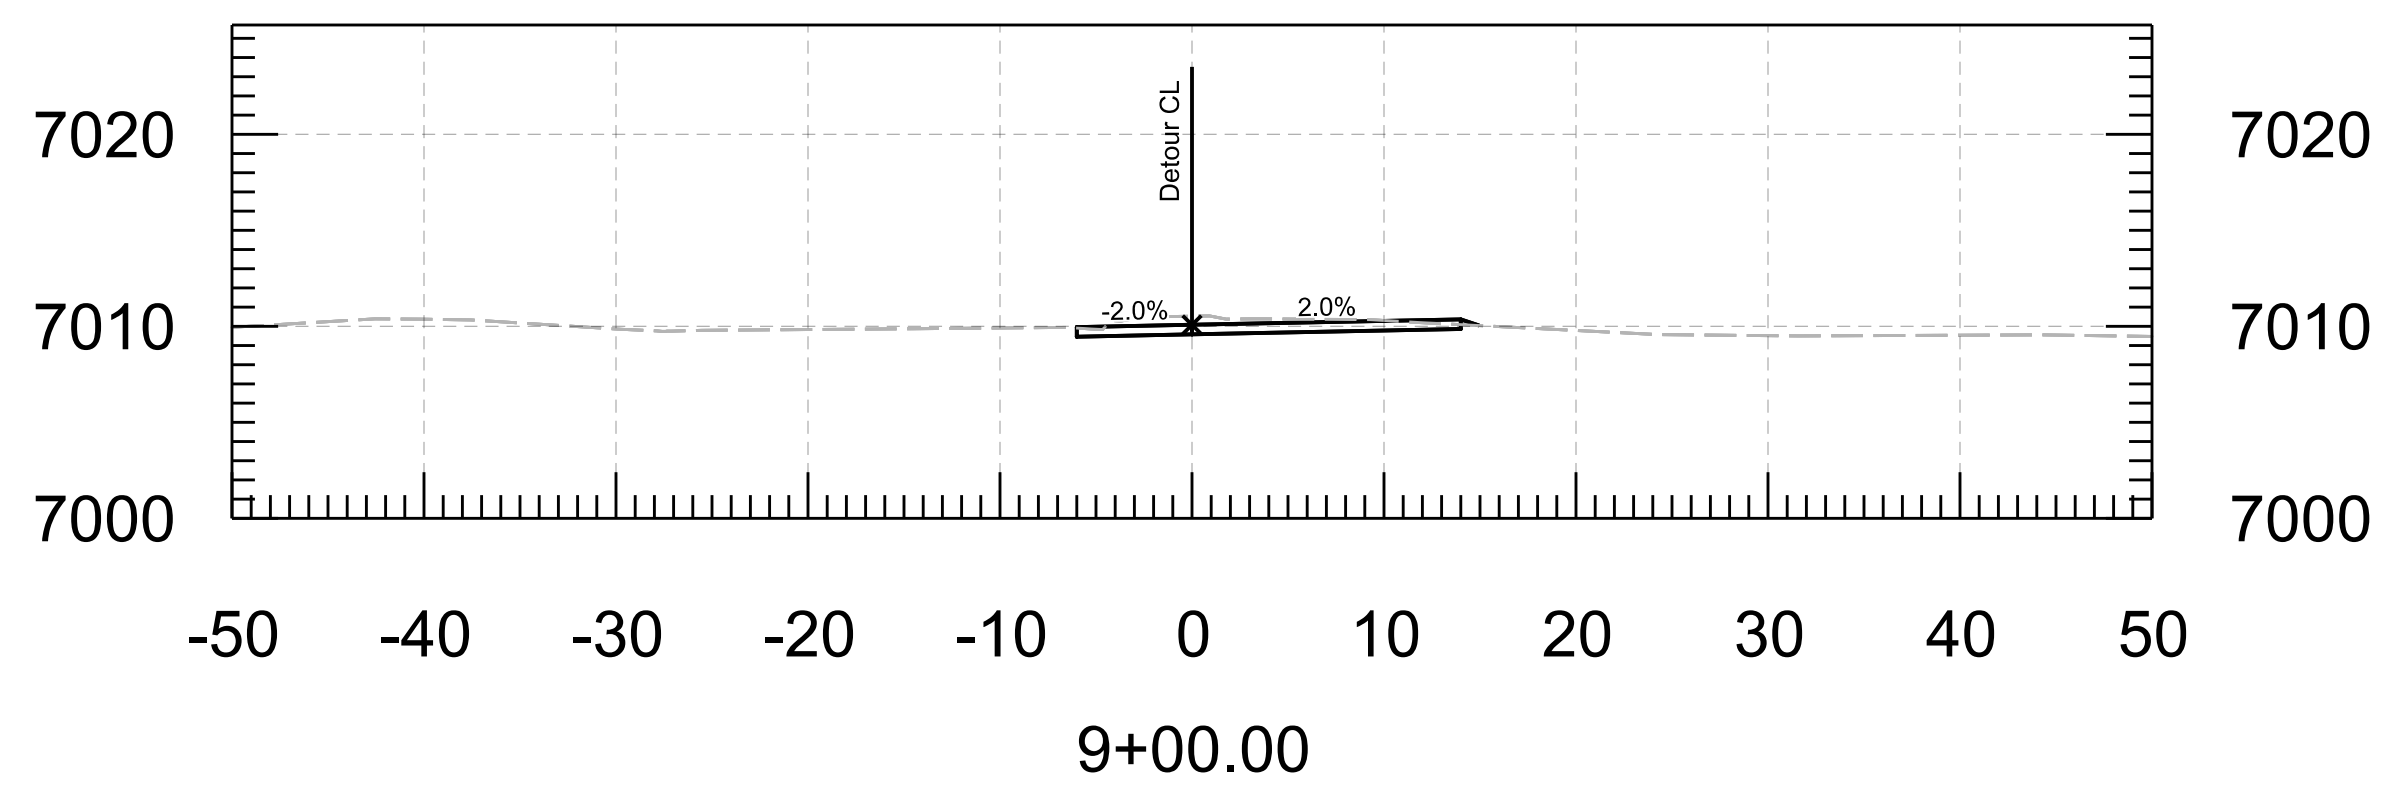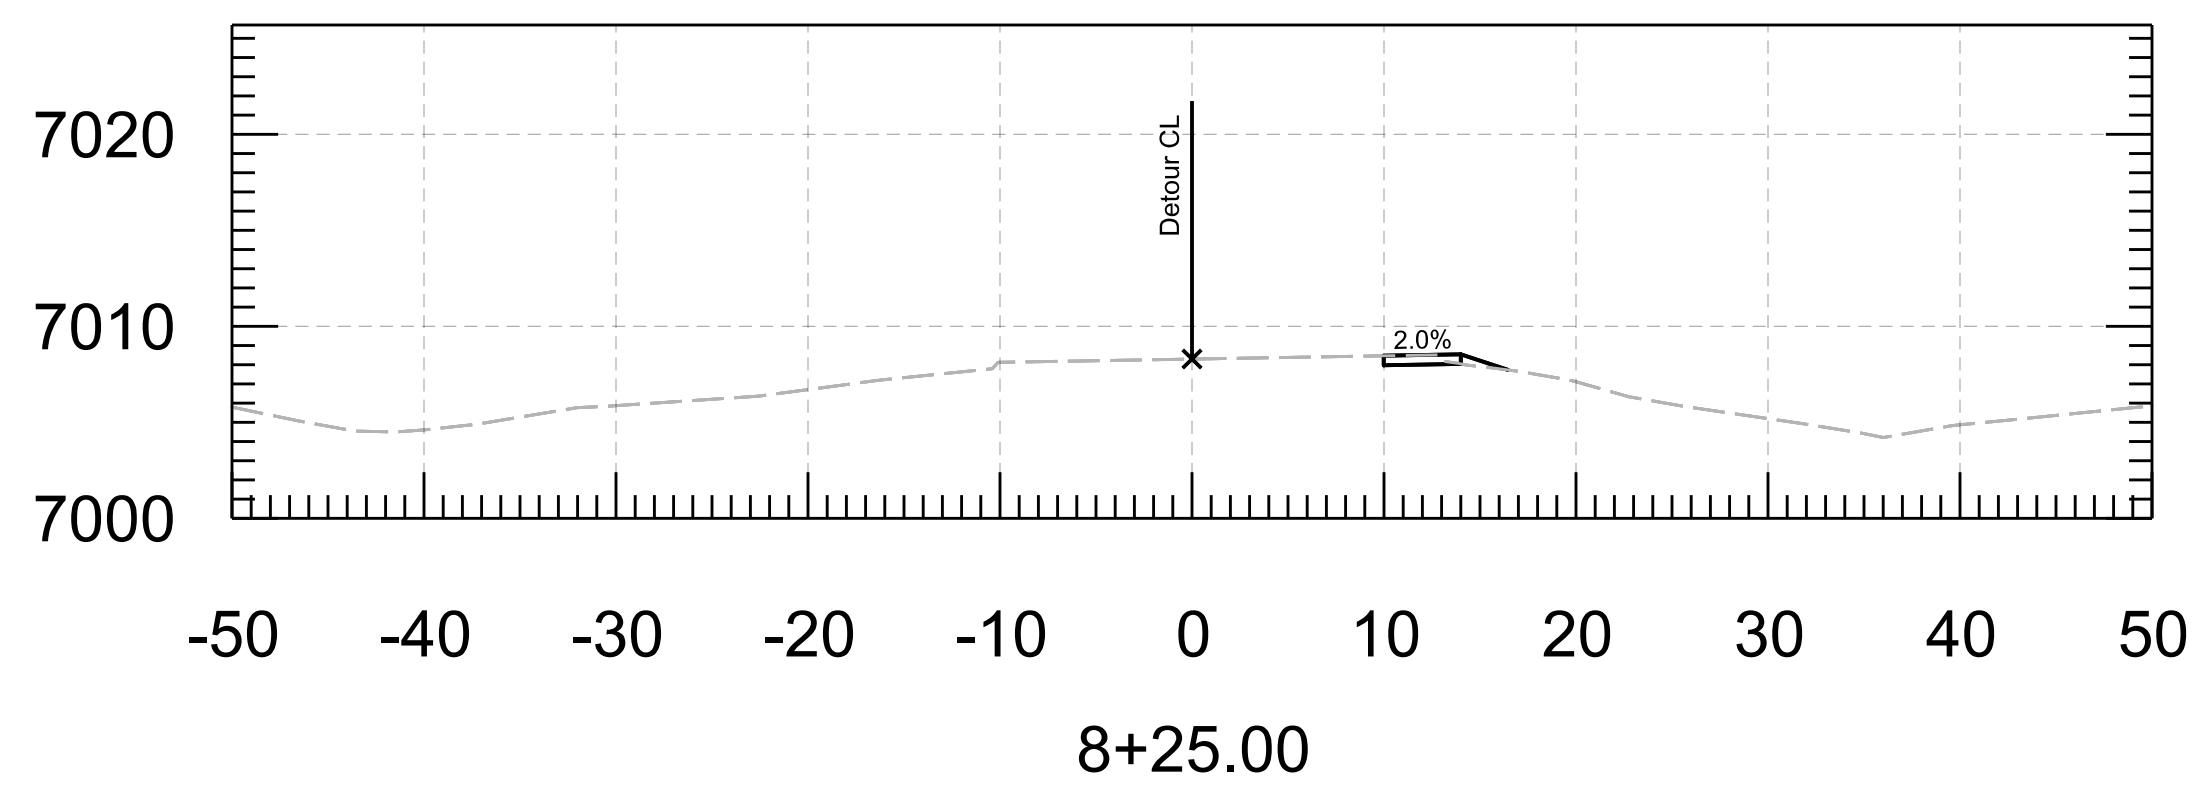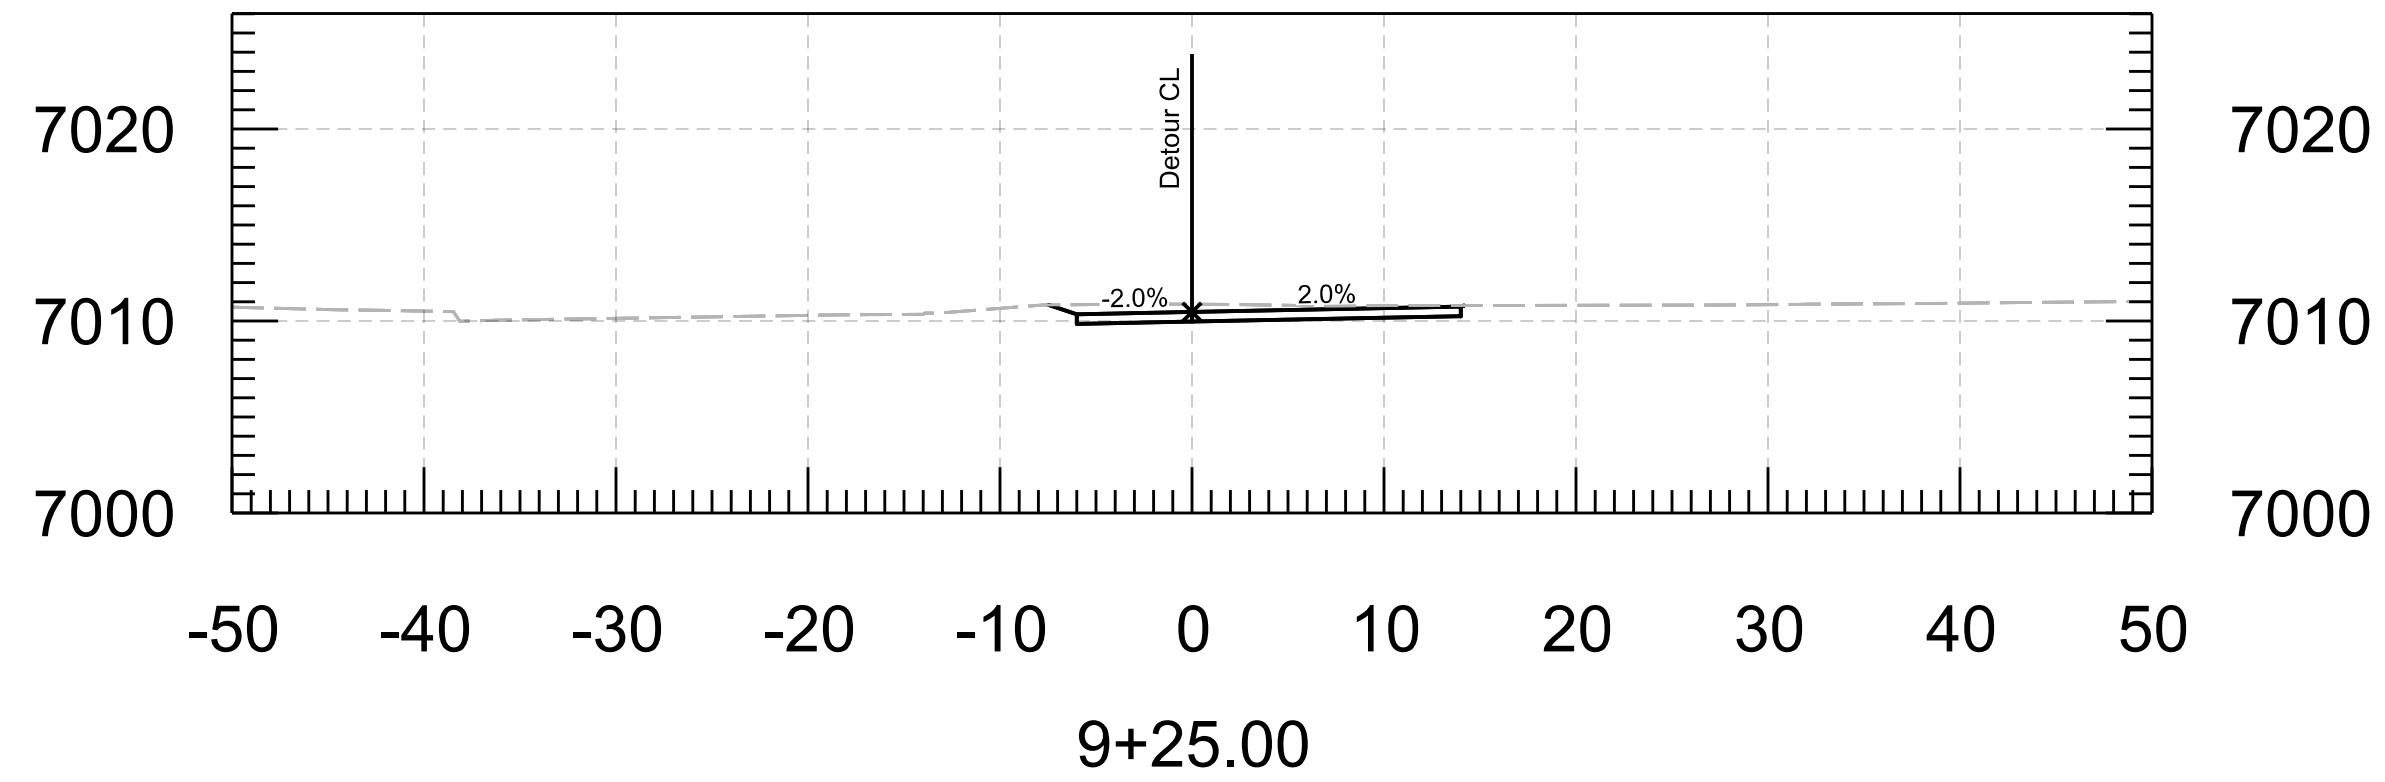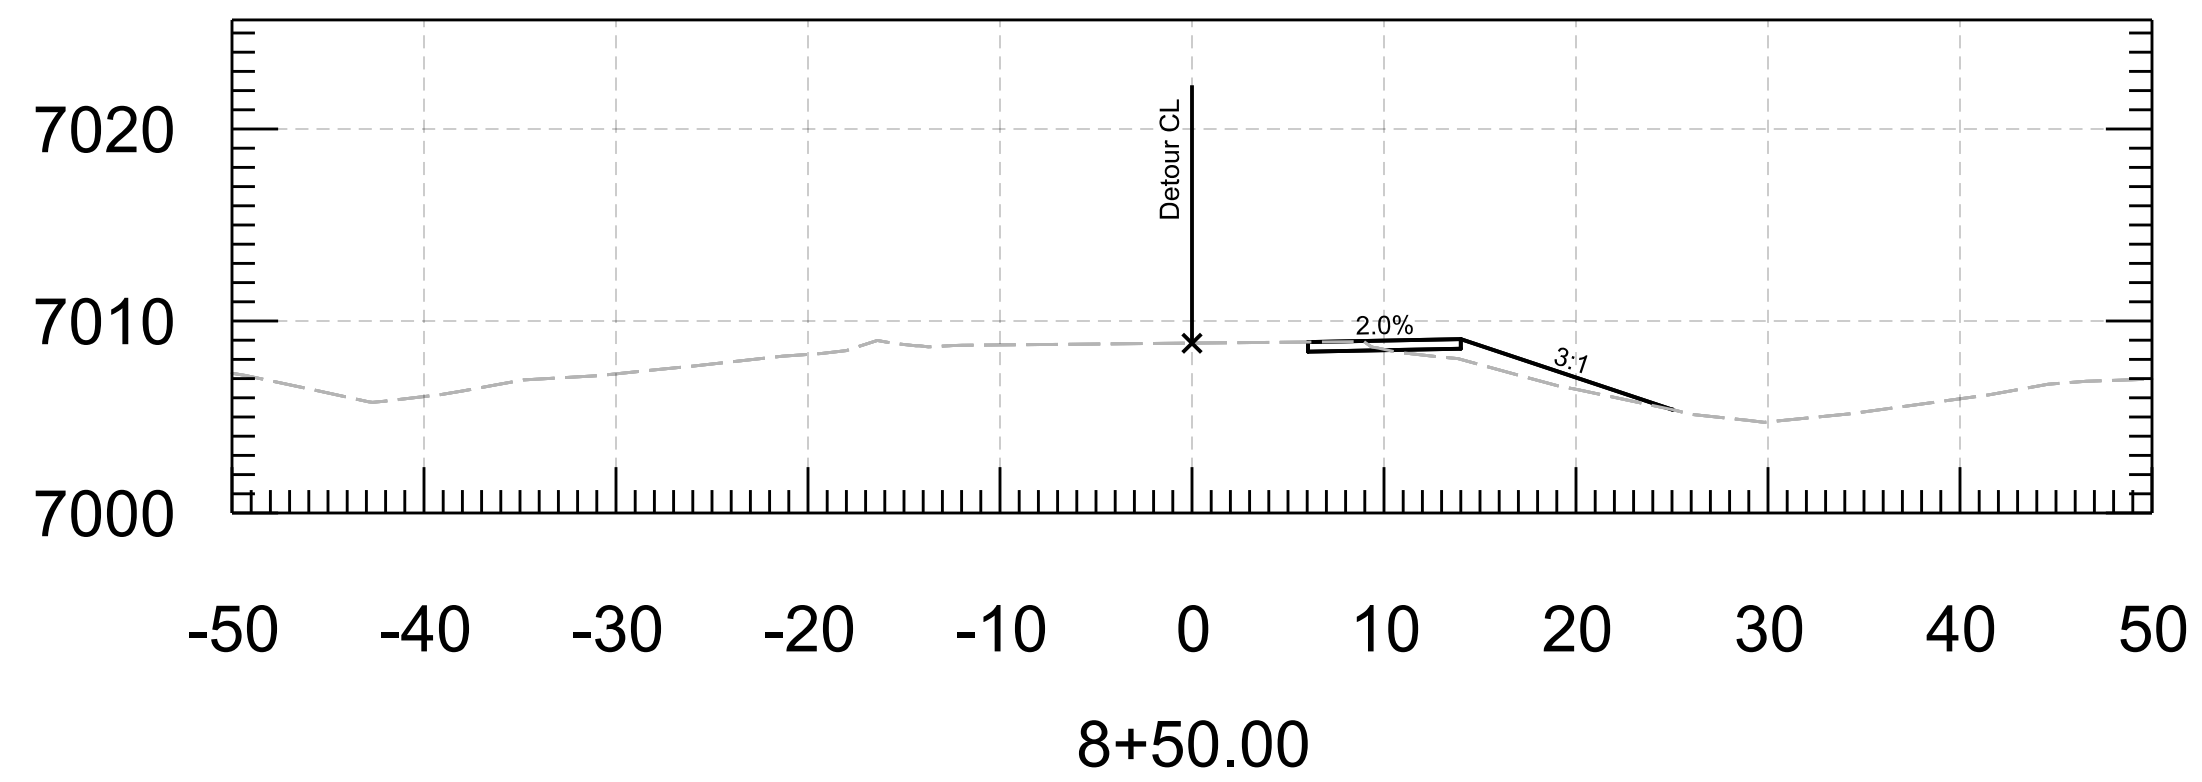







	NAME	DATE
DESIGN	J.NOYES	10/23
DRAWN	J.NOYES	10/23
CHECKED	L.BUSENBARK	10/23

HDR, INC.
20 E. THOMAS ROAD
SUITE 2500
PHOENIX, AZ 85012
TEL: (602) 522-7700

ARIZONA DEPARTMENT OF TRANSPORTATION
INFRASTRUCTURE DELIVERY AND OPERATIONS DIVISION
ROADWAY DESIGN SECTION

CROSS SECTIONS
DETOUR

ROUTE I-17	F.H.W.A. Arizona Division	STATE ARIZ.	PROJECT NO. 017 CN 337	FEDERAL ID NO. 017-B(237)T	SHEET NO. 25	TOTAL SHEETS 27	RECORD DRAWING
MILEPOST 337.39	LOCATION I-17 AIRPORT RD TI UP					DWG NO. ___ OF ___	
STRUCTURE NO.	TRACS NO. F0362 01C						

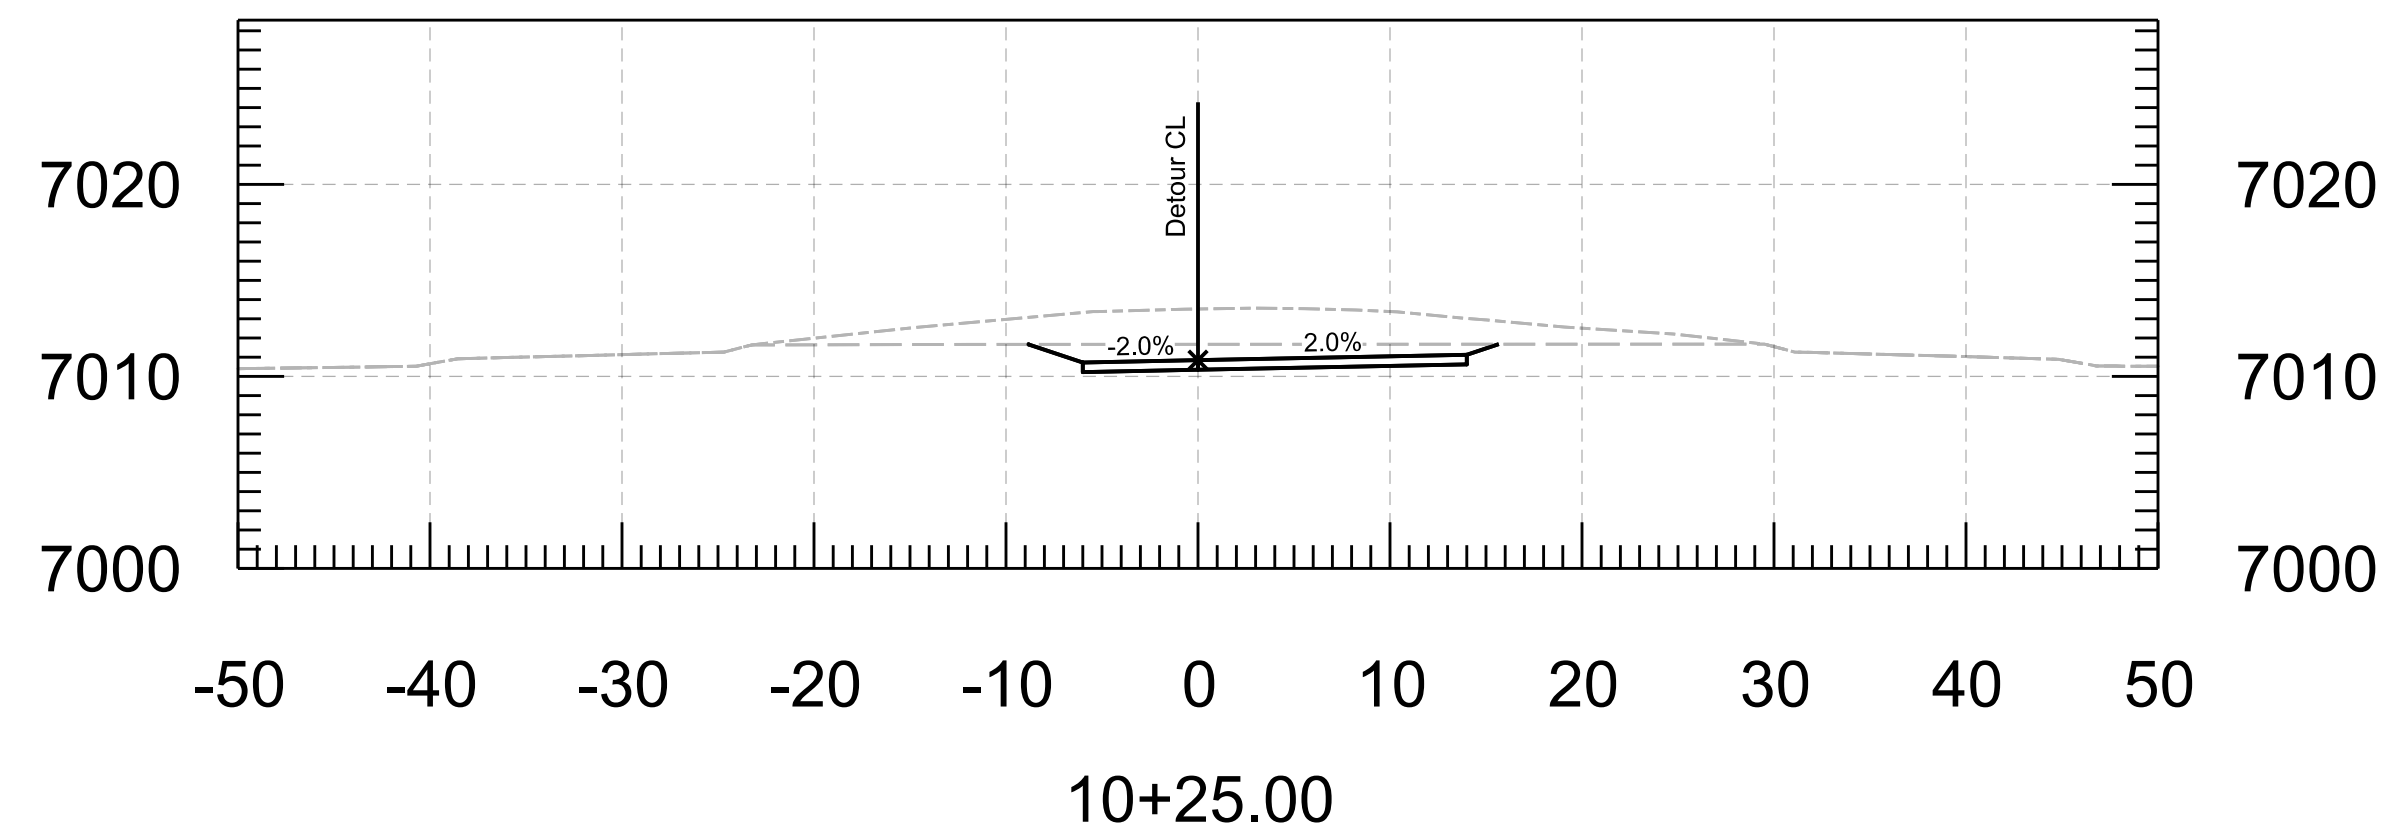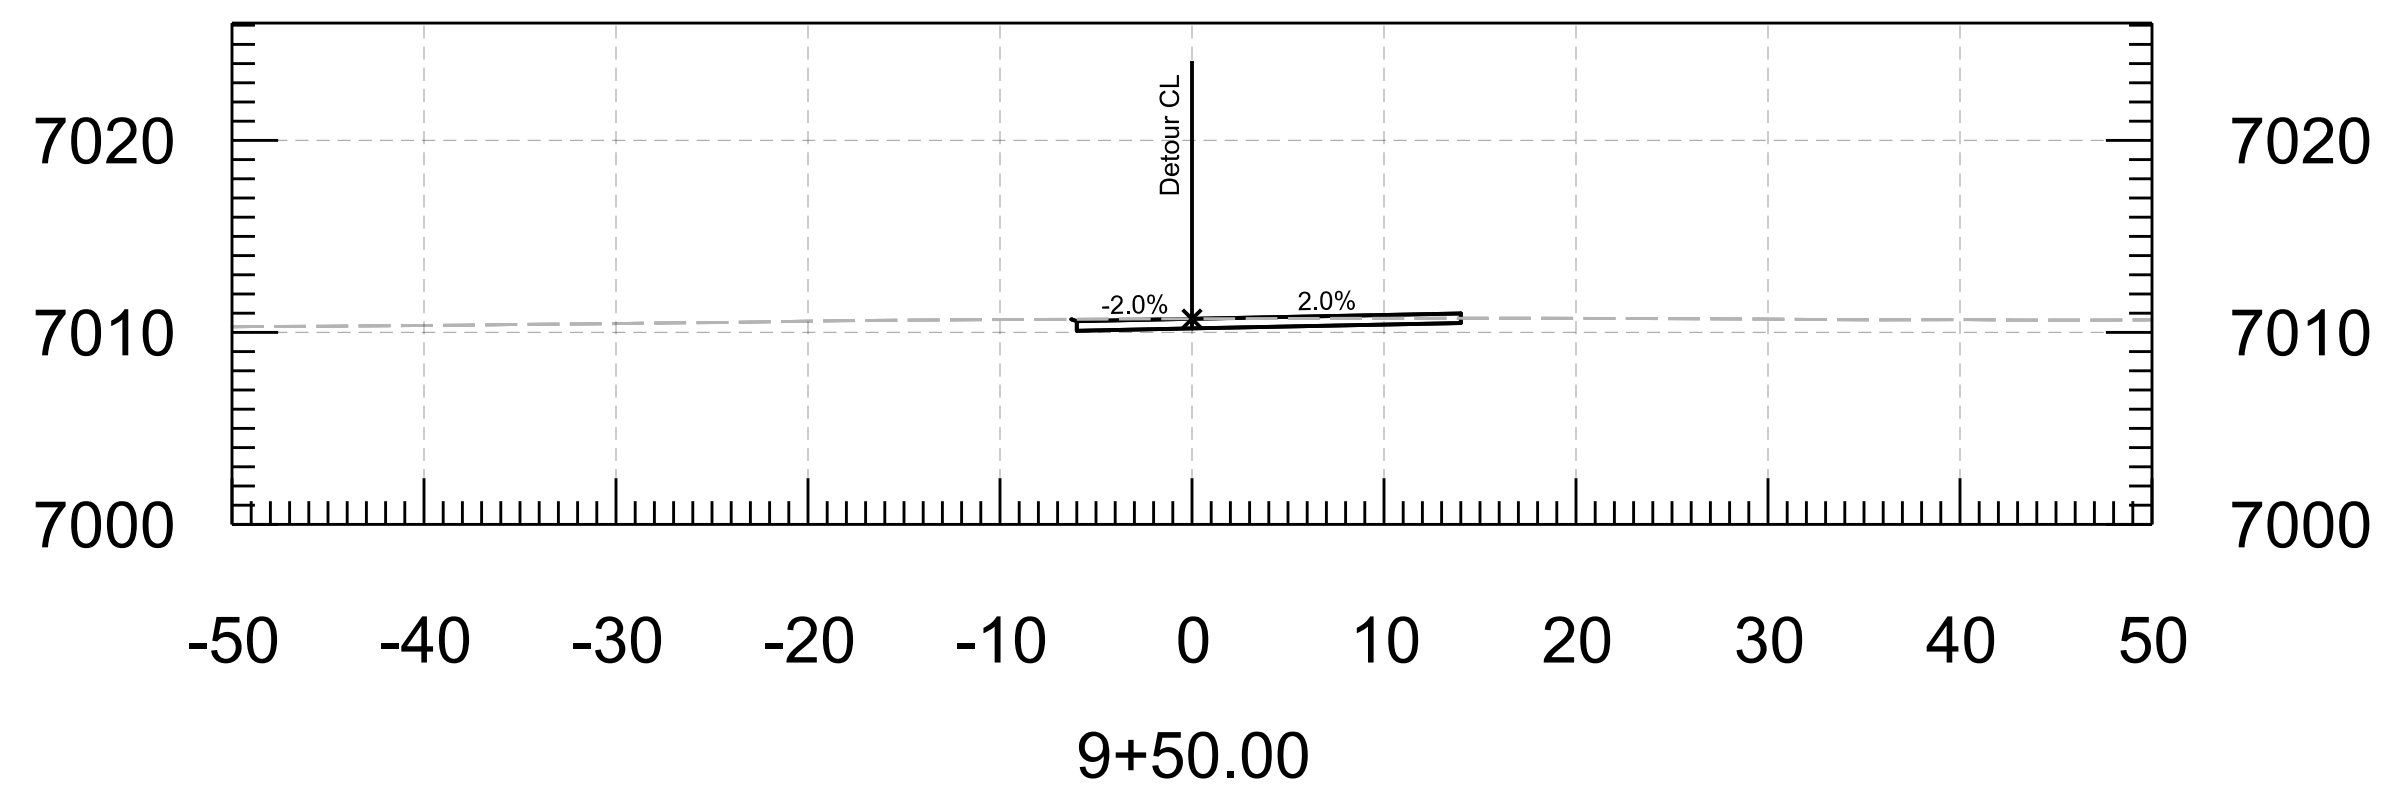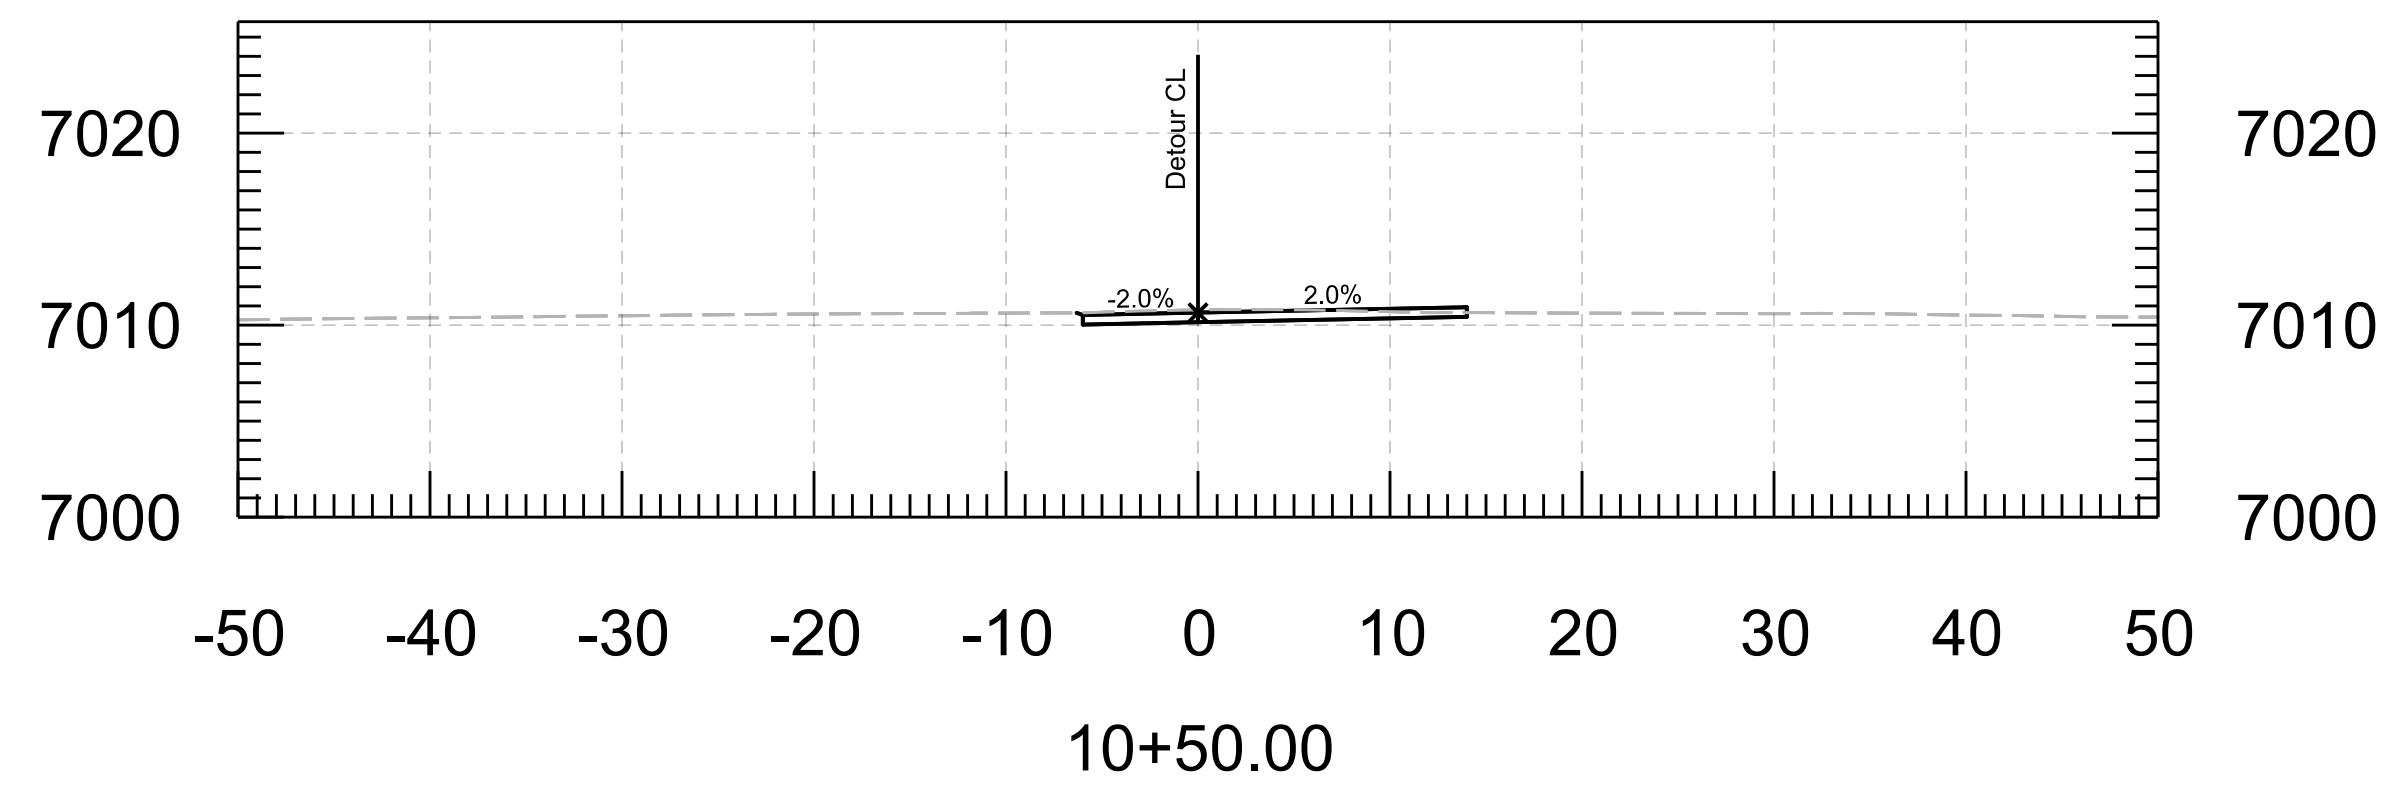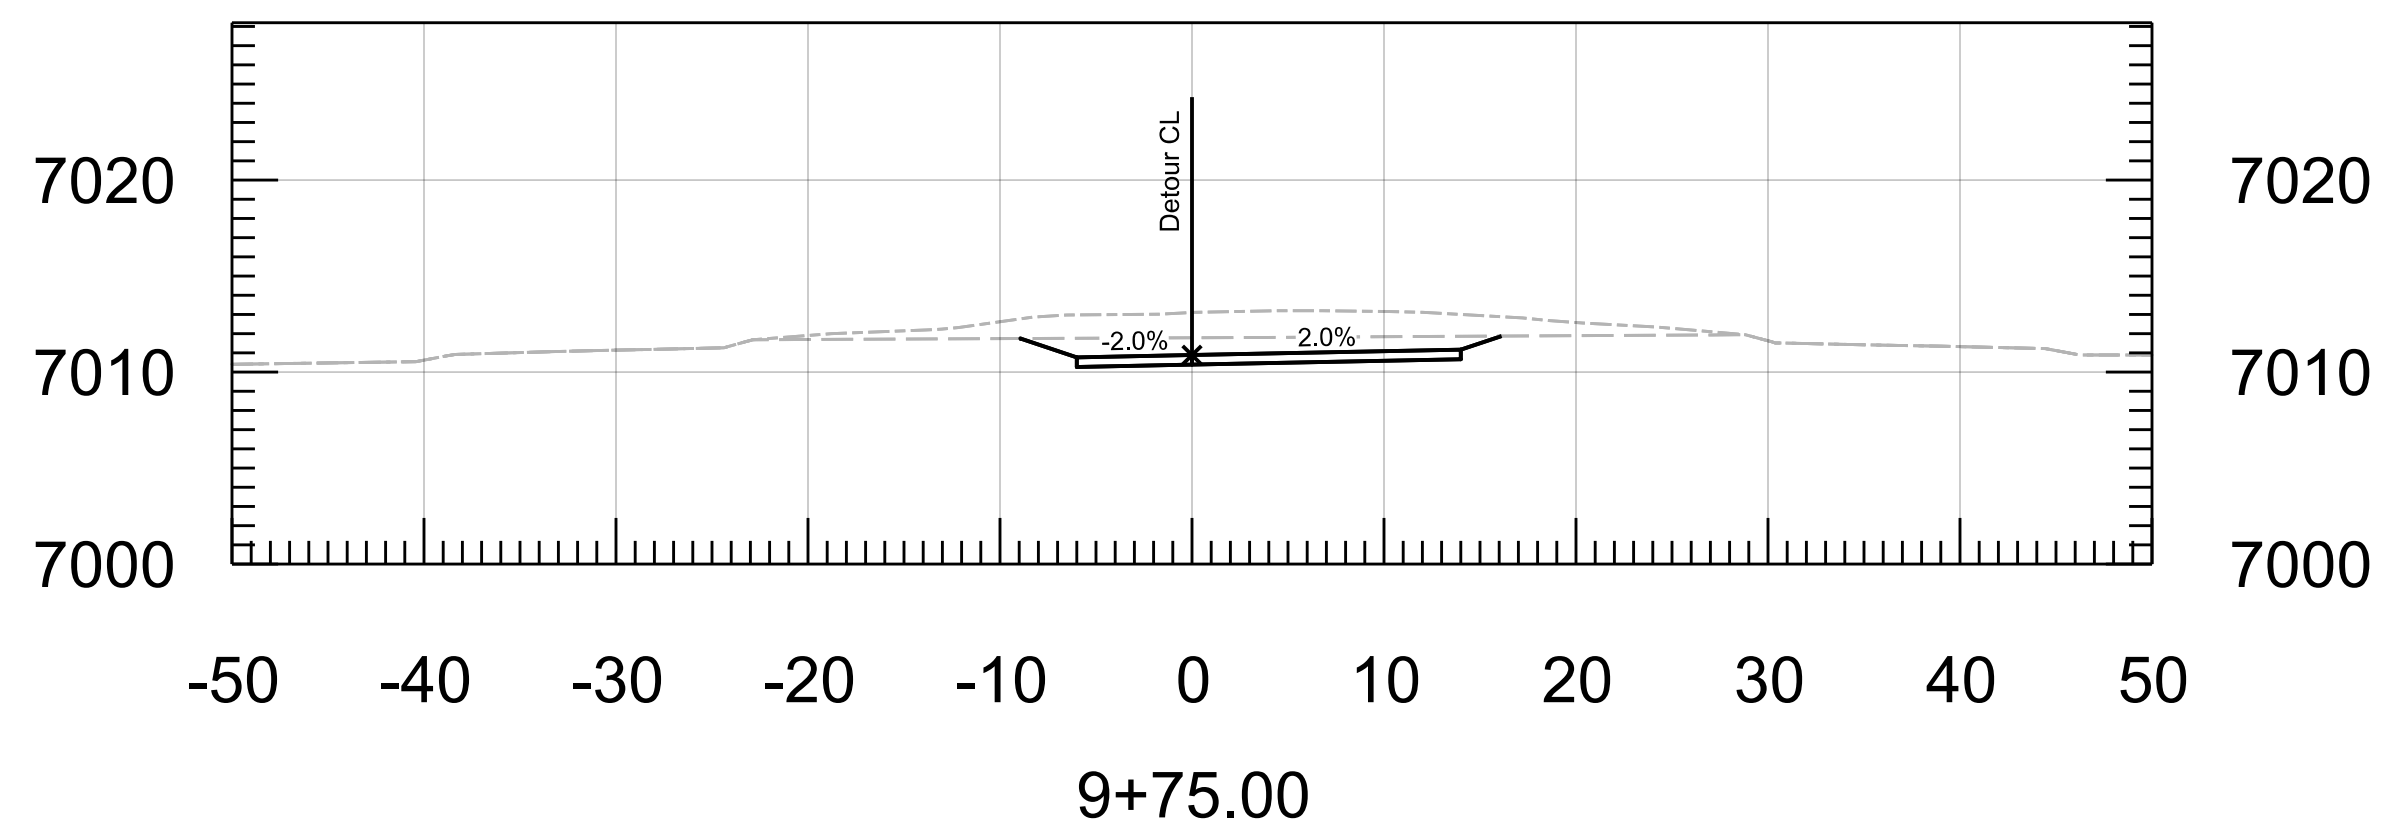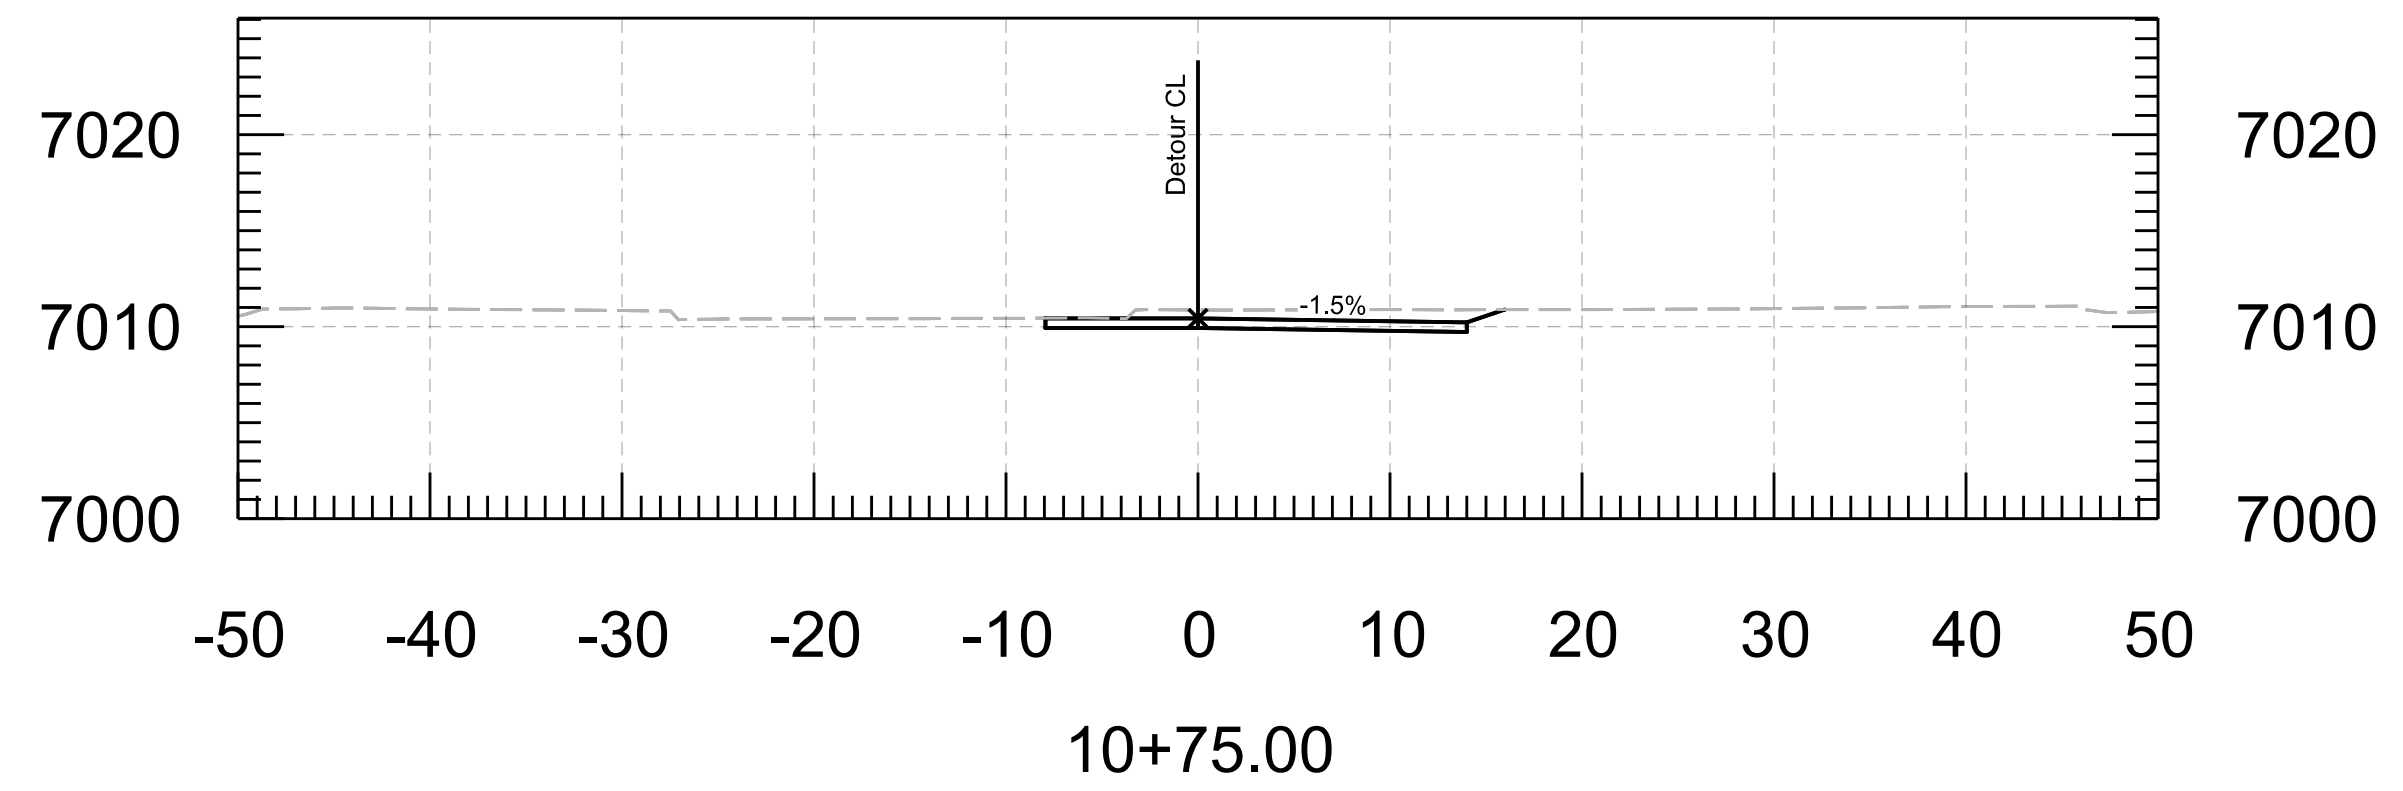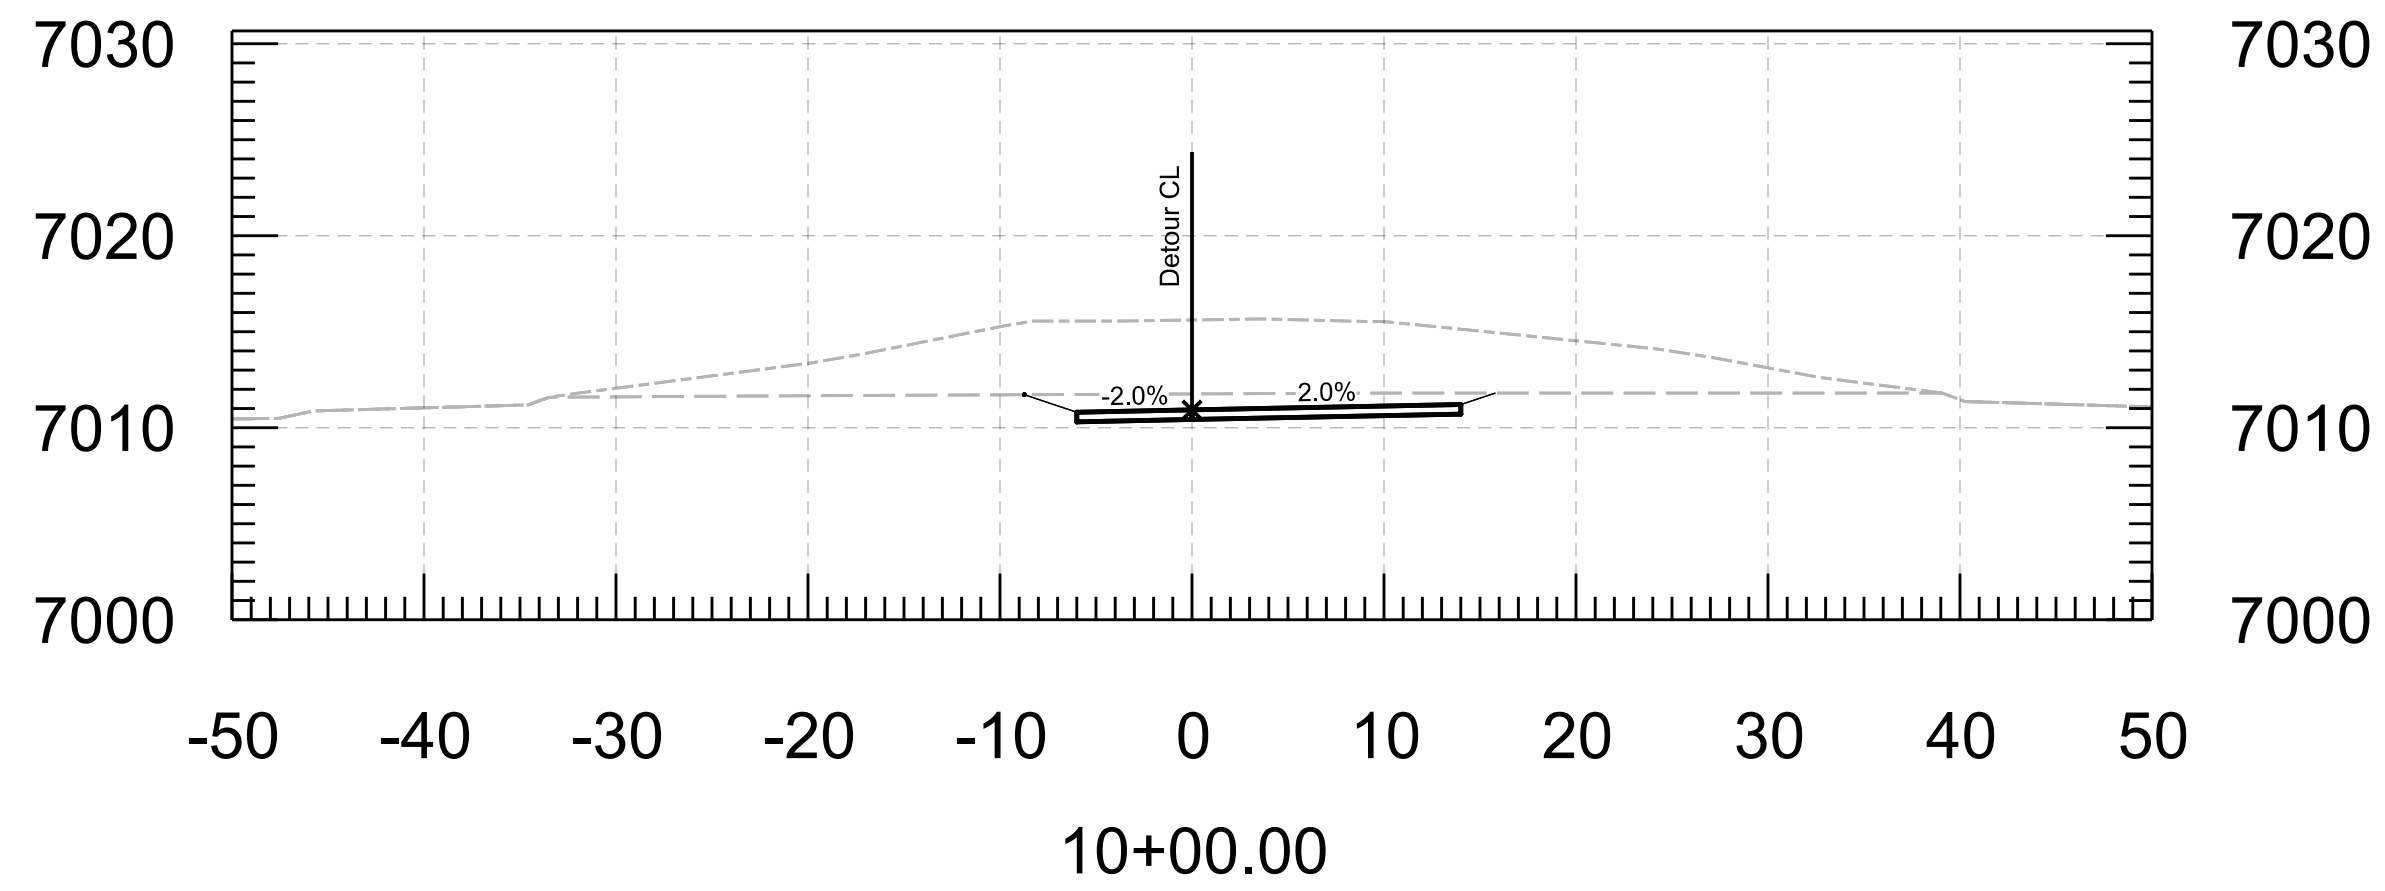

	NAME	DATE
DESIGN	J.NOYES	10/23
DRAWN	J.NOYES	10/23
CHECKED	L.BUSENBARK	10/23

HDR, INC.
20 E. THOMAS ROAD
SUITE 2500
PHOENIX, AZ 85012
TEL (602) 522-7700

ARIZONA DEPARTMENT OF TRANSPORTATION
INFRASTRUCTURE DELIVERY AND OPERATIONS DIVISION
ROADWAY DESIGN SECTION

CROSS SECTIONS
DETOUR

ROUTE I-17	F.H.W.A. Arizona Division	STATE ARIZ.	PROJECT NO. 017 CN 337	FEDERAL ID NO. 017-B(237)T	SHEET NO. 26	TOTAL SHEETS 27	RECORD DRAWING
MILEPOST 337.39	LOCATION I-17 AIRPORT RD TI UP					DWG NO. ___ OF ___	
STRUCTURE NO.	TRACS NO. F0362 01C						